
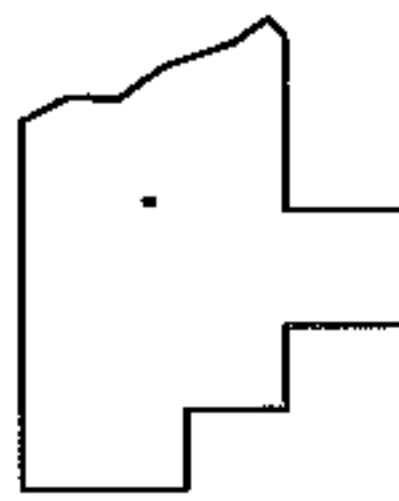
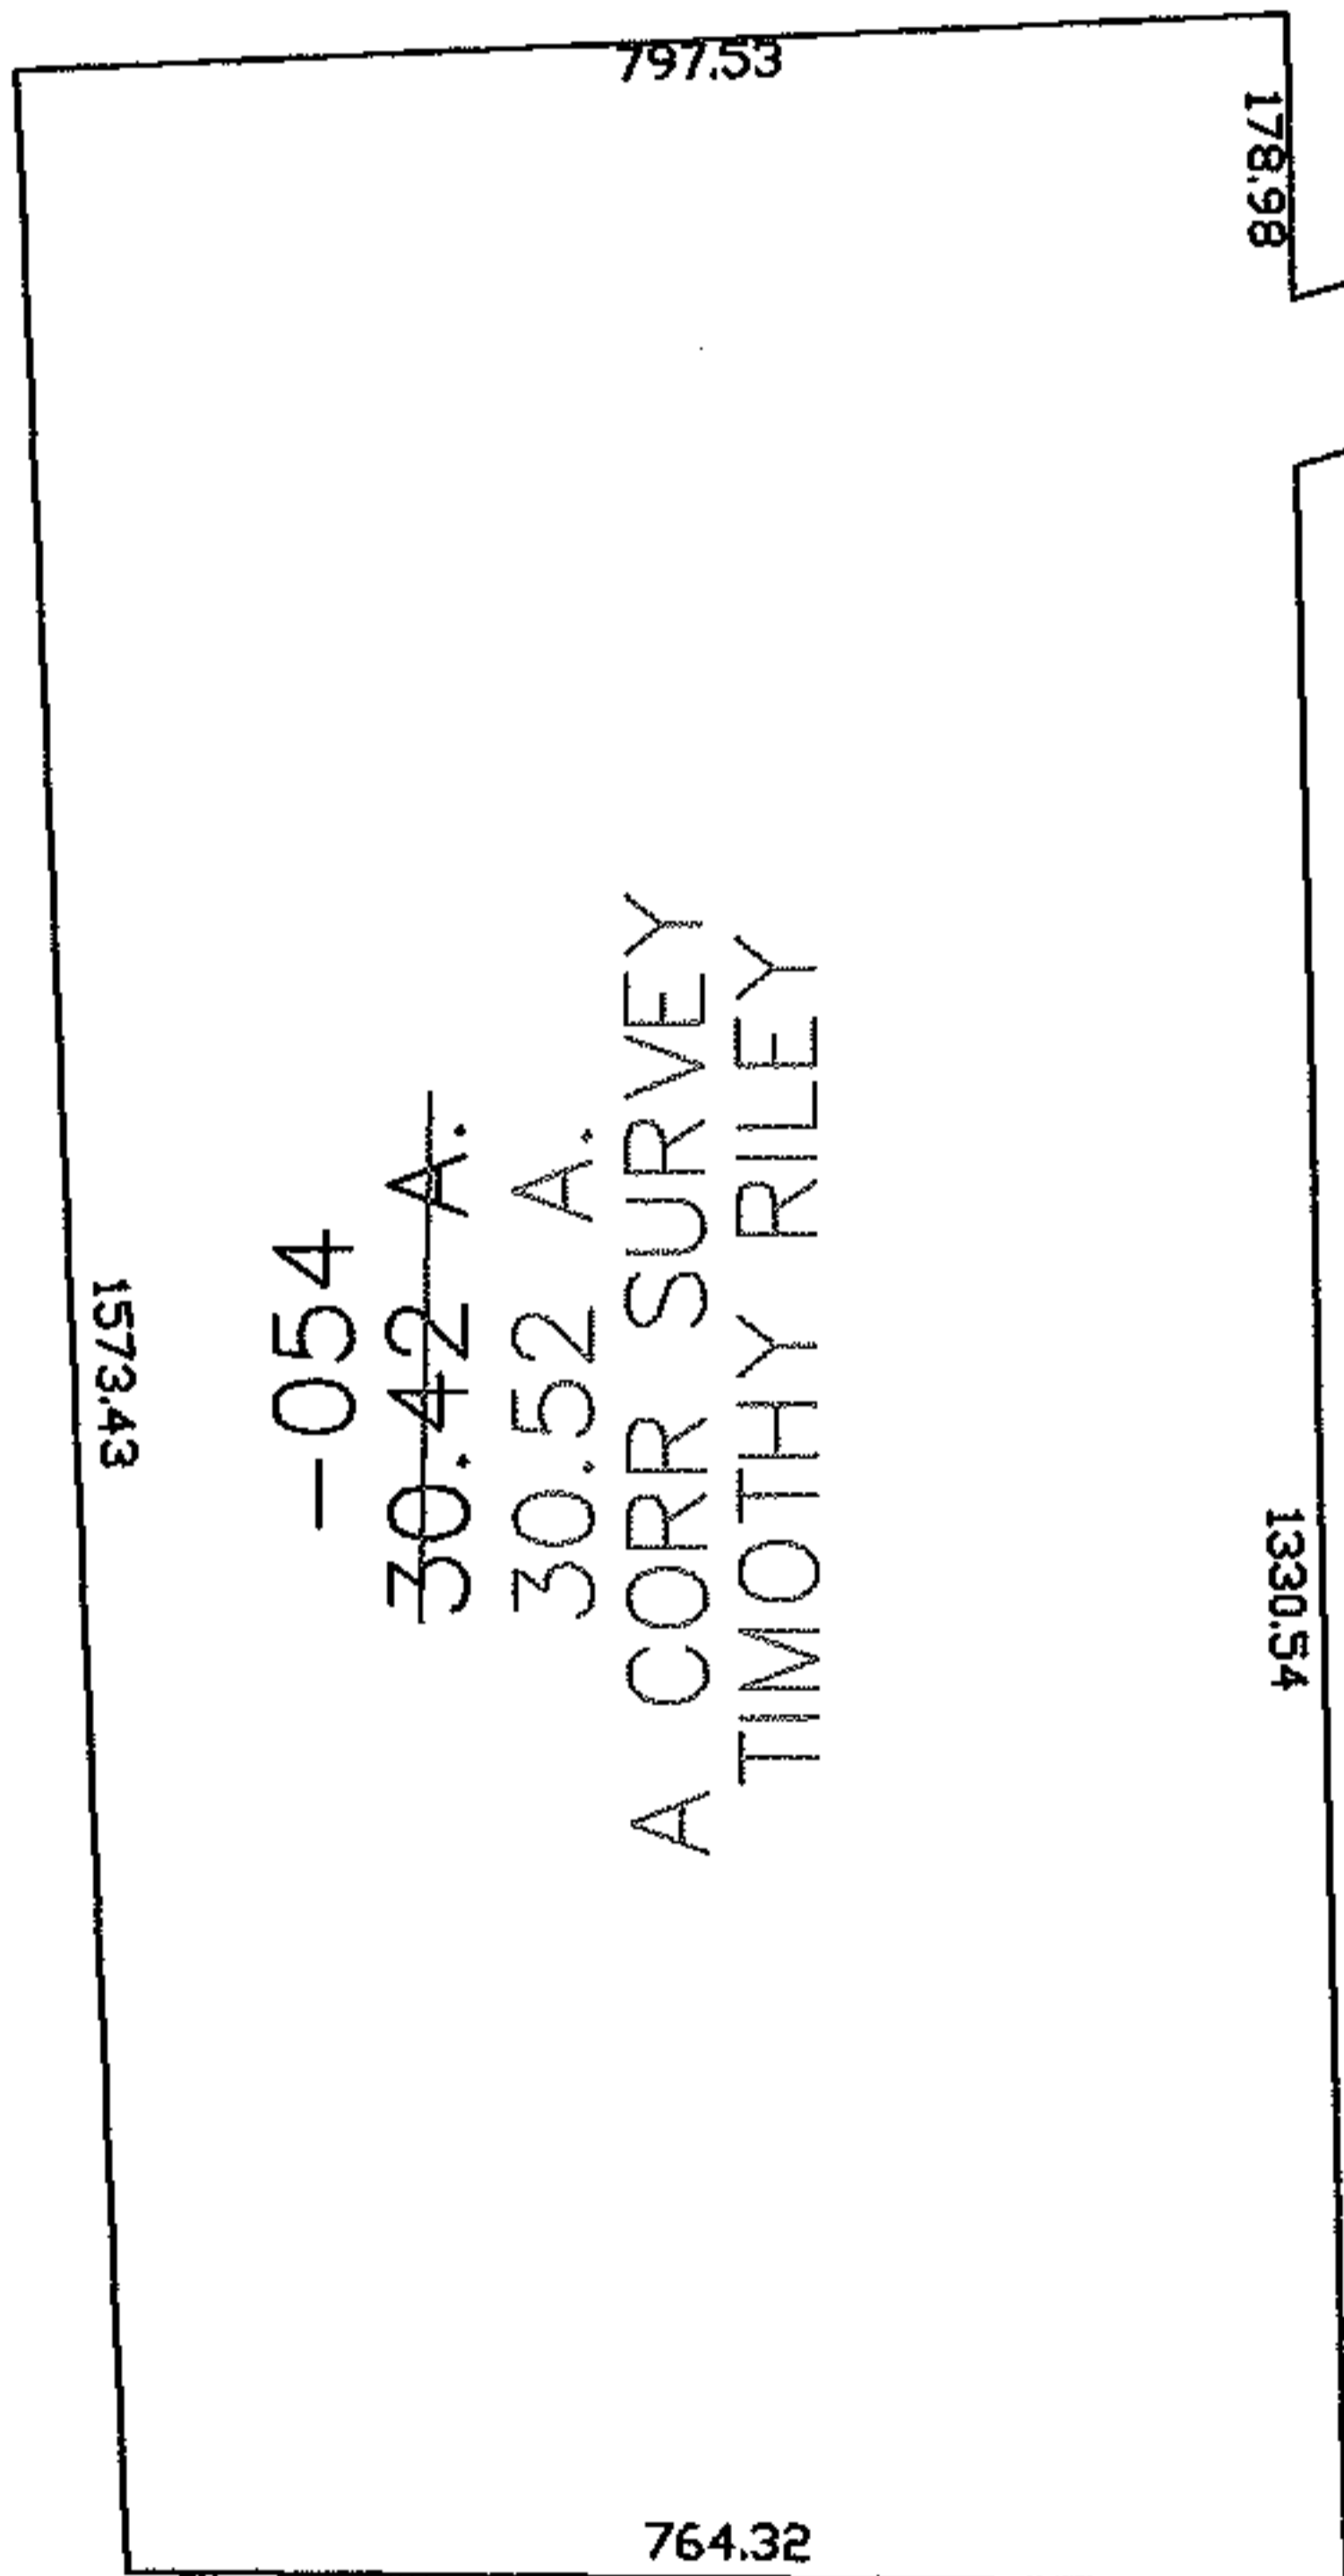
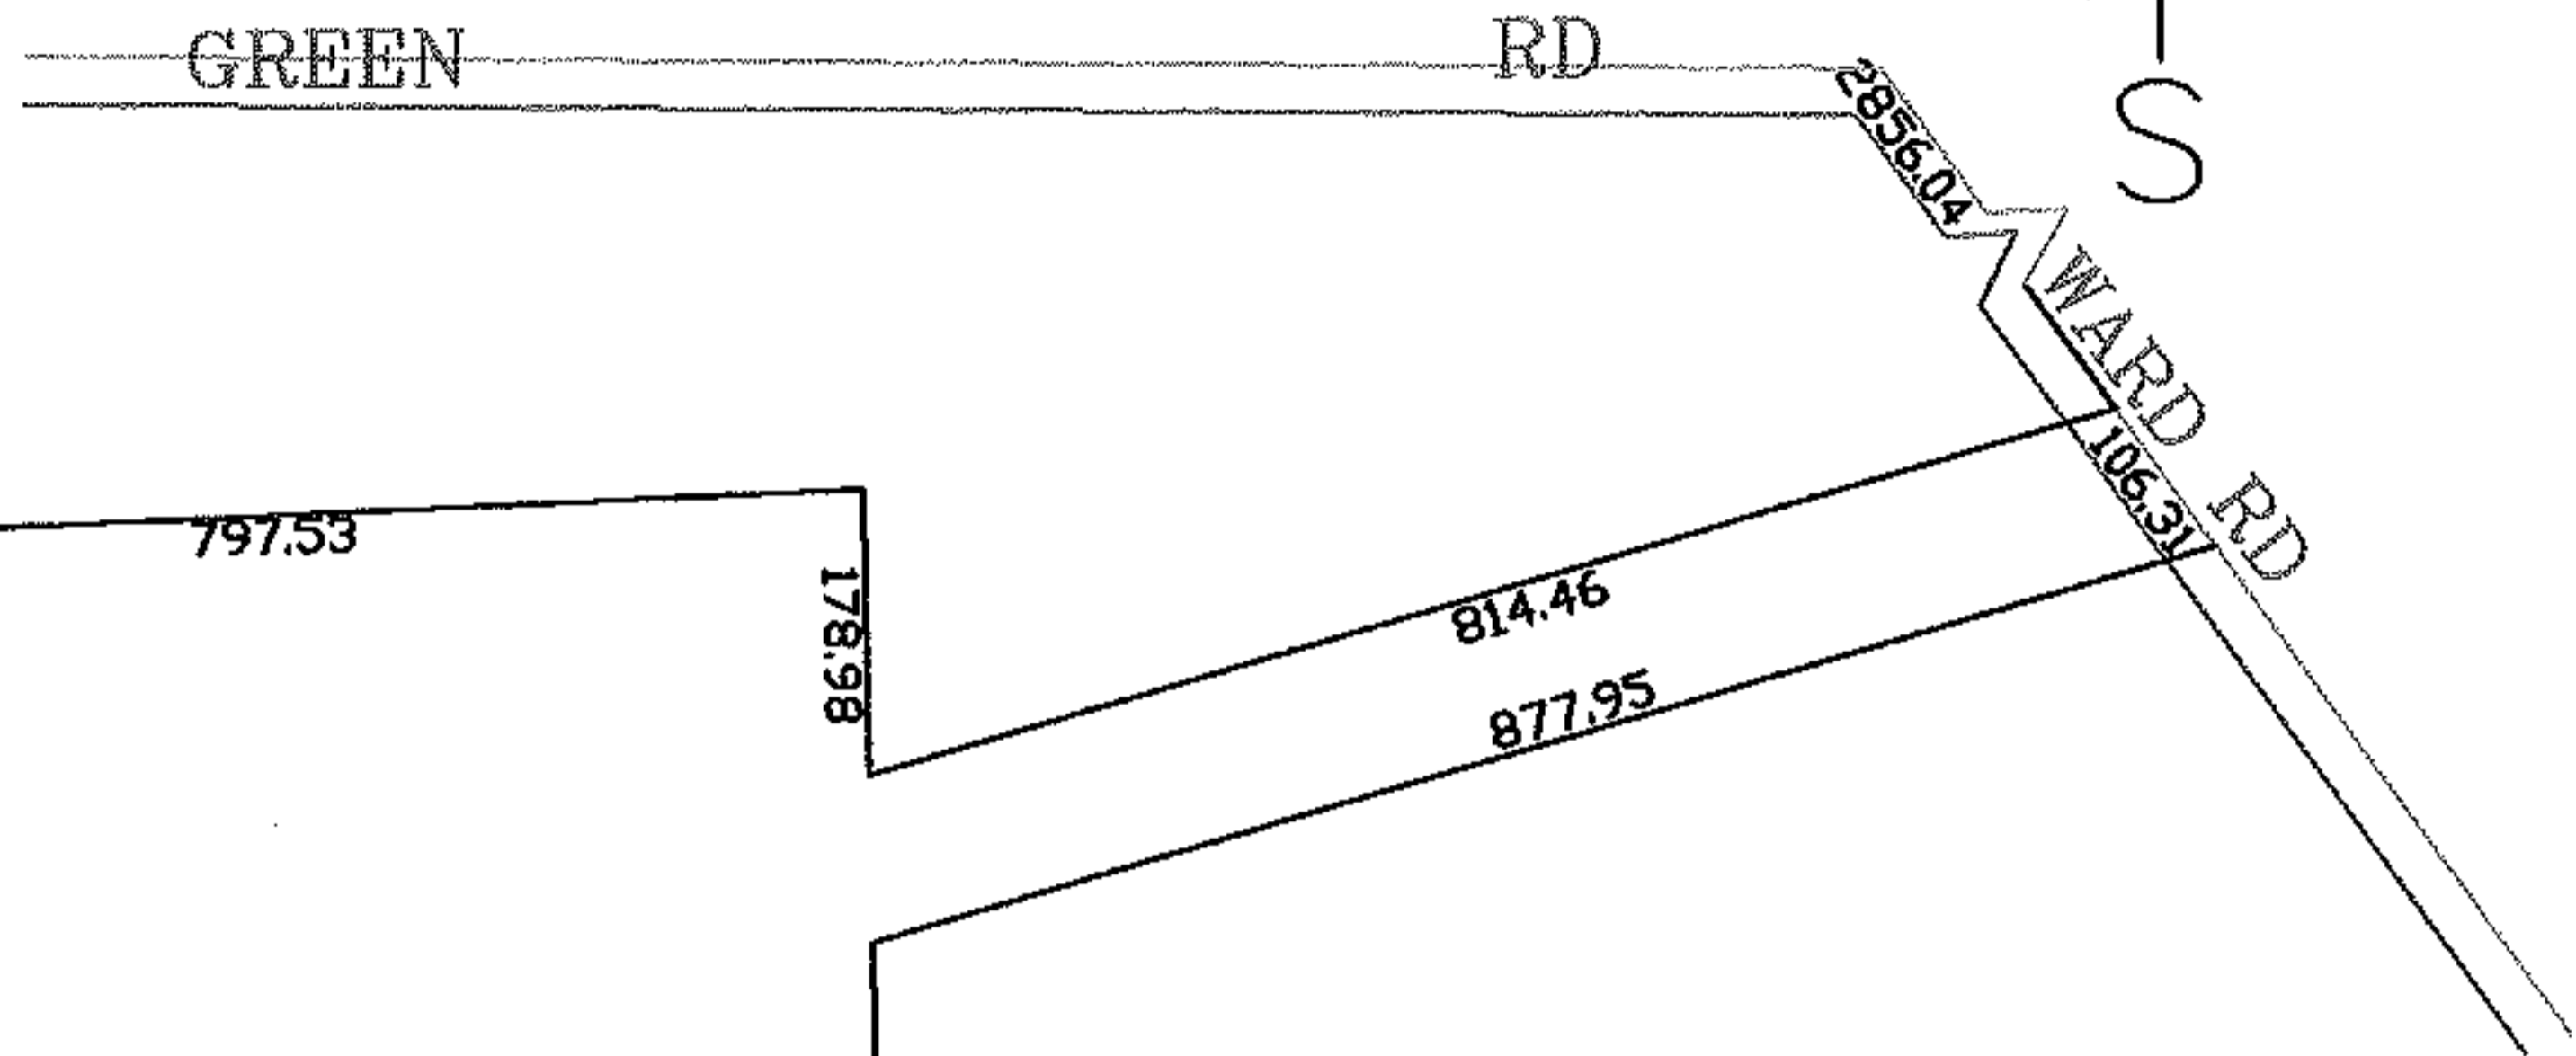


PARENT PARCEL: 08-20-024-000-054

CHILD PARCEL: SAME

STARTING POINT: CENTERLINE OF WARD RD & GREEN RD

07-02451-A

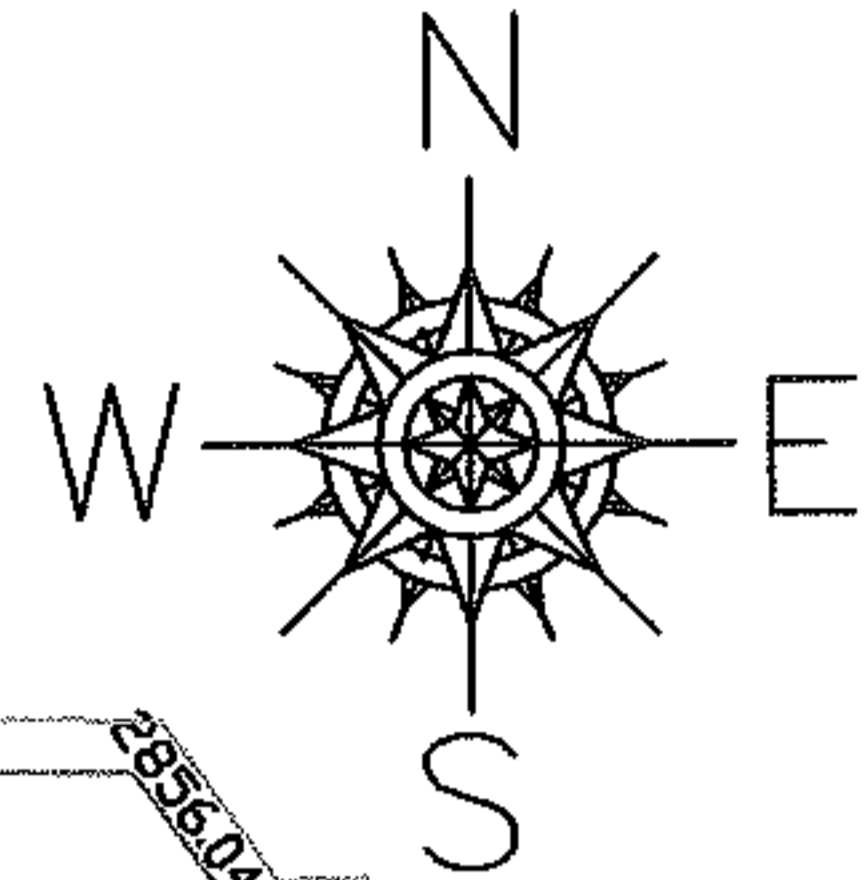

SPLITS/DEEDS PROCESSED

LORAIN COUNTY TAX MAP DEPARTMENT
226 MIDDLE AVE. ELYRIA, OHIO

SURVEYED BY: TIMOTHY RILEY
CLOSURE: 0.00 : 10.000
MAP PAGE(S): 8-E
APPROVED BY: JAH DATE: 9-6-07
SCALE: 1" = 300 PRIOR INSTRUMENT: DV 1081/743