


PARENT PARCEL: 09-00-072-000-008

CHILD PARCEL: 09-00-072-000-034, -035

STARTING POINT: CENTERLINE OF OBERLIN-NORWALK RD & QUARRY RD

09-00196

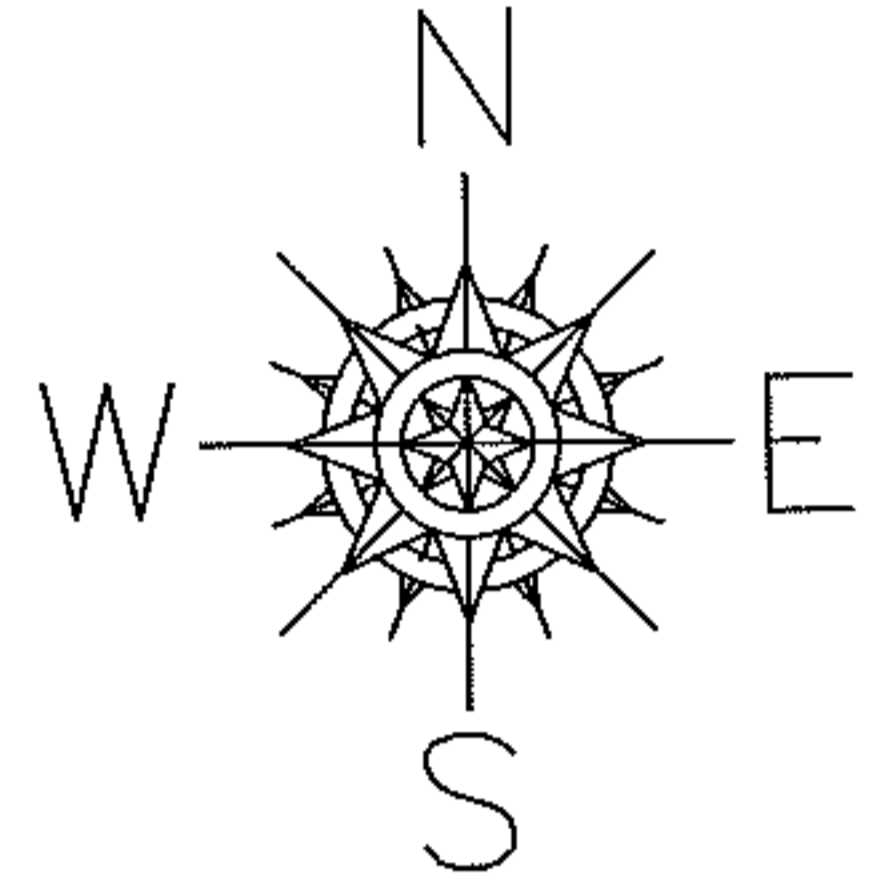

~~-008~~
~~7.24 A.~~
-035
6.76 A.

-034
0.48 A.

QUARRY RD

OBERLIN-NORWALK RD

1372.84

29.99

412.00

53.85

111.80

118.06

70.04

SPLITS/DEEDS PROCESSED

LORAIN COUNTY TAX MAP DEPARTMENT
226 MIDDLE AVE. ELYRIA, OHIO

SURVEYED BY: RAYMOND FOOS

CLOSURE: 0.00 : 10,000

MAP PAGE(S): 9-E

APPROVED BY: JAH DATE: 11-9-09

SCALE: 1" = 100 PRIOR INSTRUMENT: 20050111042