
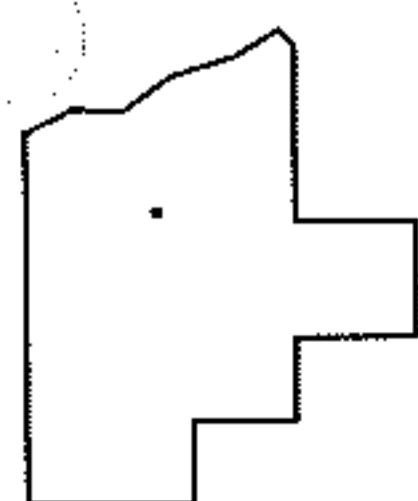
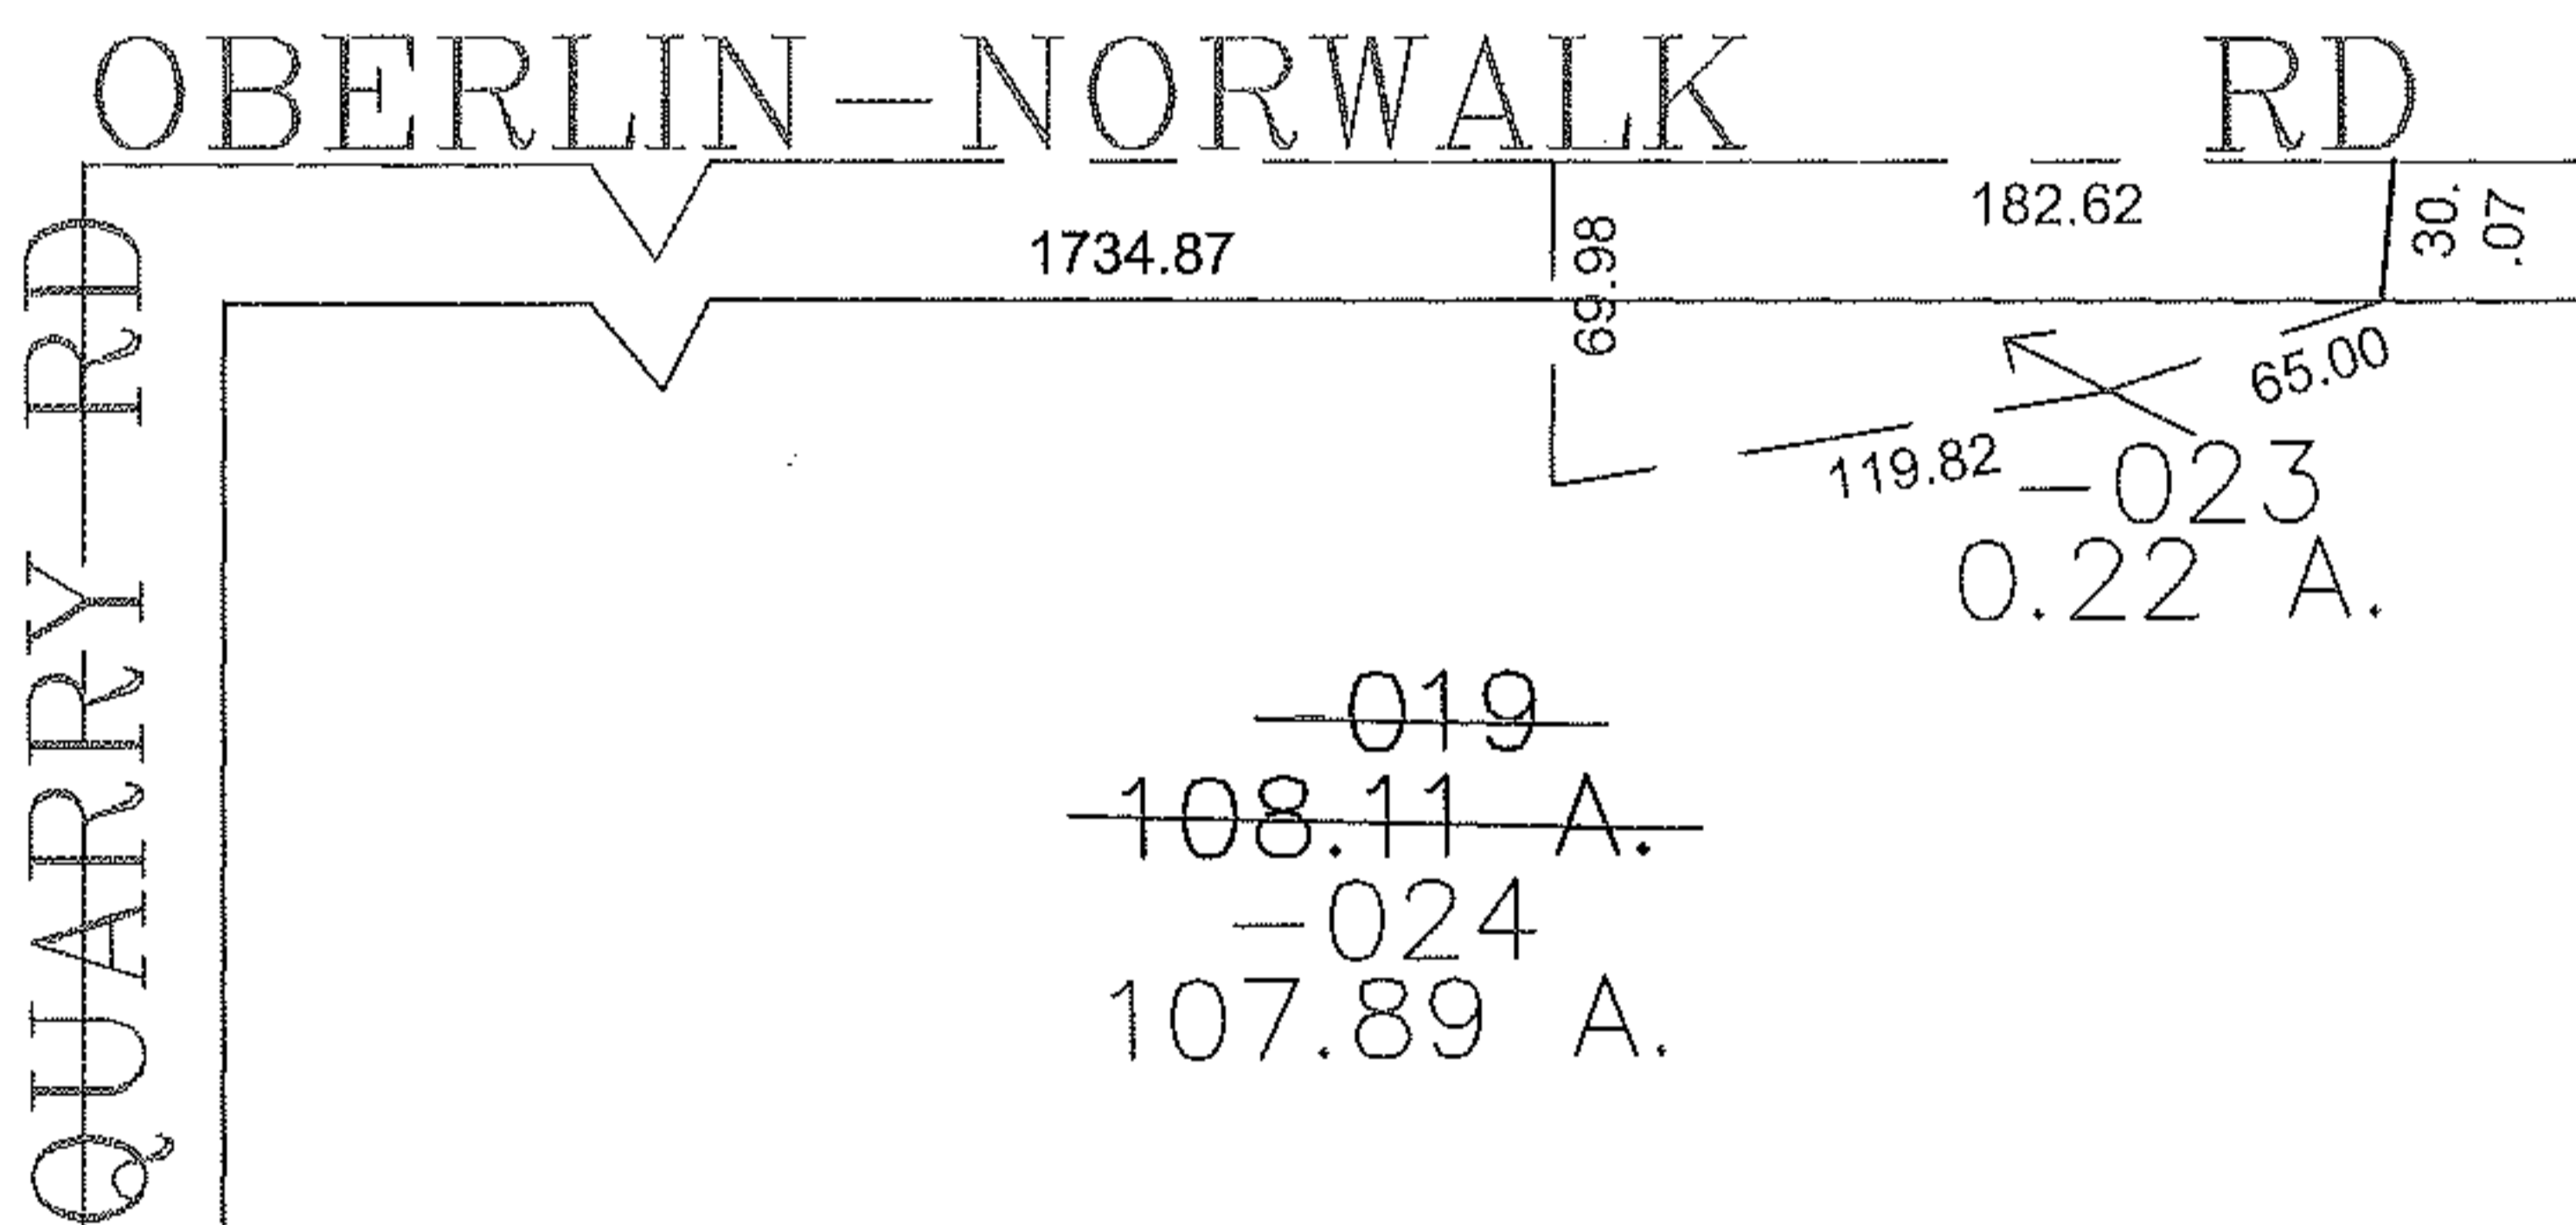


PARENT PARCEL: 09-00-082-000-019

CHILD PARCEL: 09-00-082-000-023, -024

STARTING POINT: CENTERLINE OF QUARRY RD & OBERLIN-NORWALK RD

09-00197

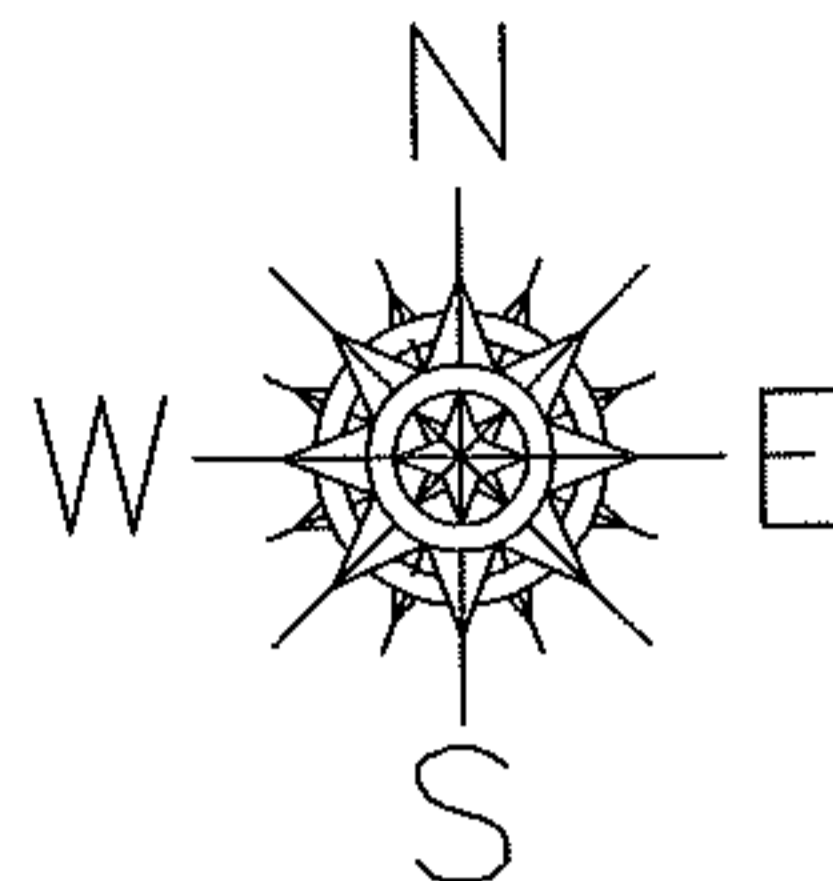

**SPLITS/DEEDS PROCESSED**

LORAIN COUNTY TAX MAP DEPARTMENT  
226 MIDDLE AVE. ELYRIA, OHIO

SURVEYED BY: RAYMOND FOOS

CLOSURE: 0.00 : 10.000

MAP PAGE(S): 9-E

APPROVED BY: JAH DATE: 11-9-09

SCALE: 1" = 100 PRIOR INSTRUMENT: 20080239725