


PARENT PARCEL: 03-00-004-000-051

CHILD PARCEL: 03-00-004-000-073, -074

10-00200

STARTING POINT: SOUTHWEST CONER OF O.L. 4 & 3

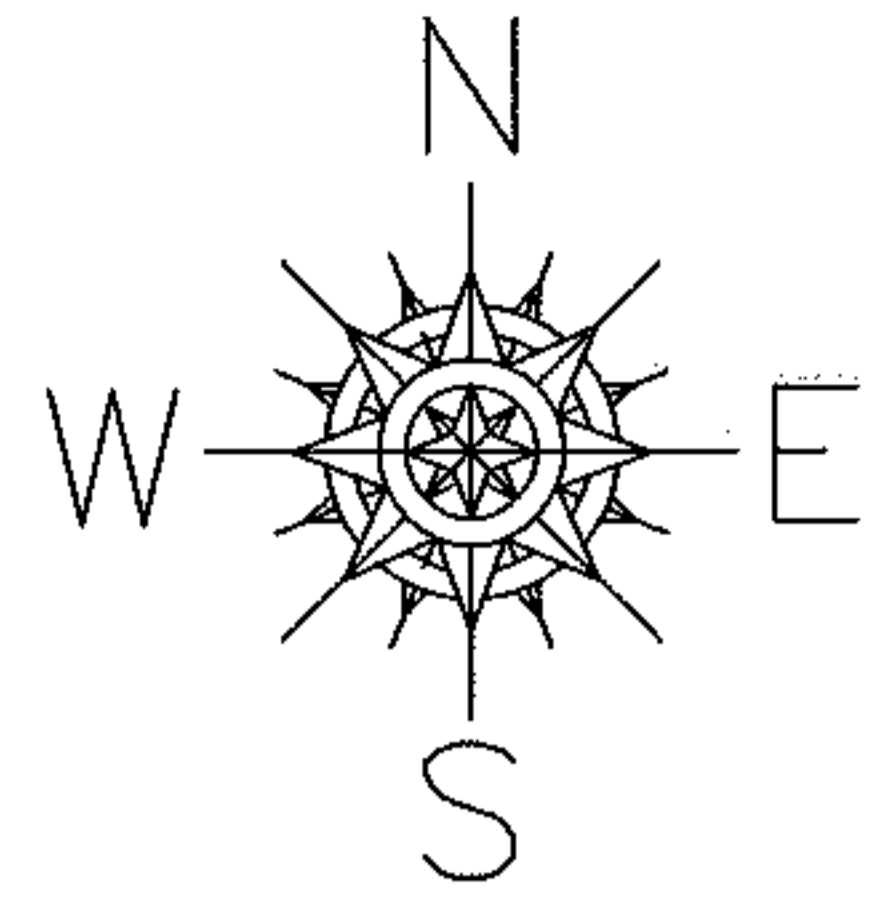

ST RT I-90

ABBIE RD

RD

~~-051~~
~~20.70 A.~~
-074
20.63 A.

-073
0.07 A.

19.58

208.78
190.36

15.93

15.52

234.33

180.00


63.32

355.63

442.01

O.L. 4

O.L. 3

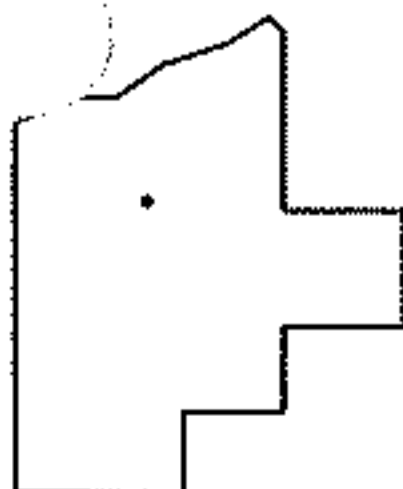

SPLITS/DEEDS PROCESSED
LORAIN COUNTY TAX MAP DEPARTMENT
226 MIDDLE AVE. ELYRIA, OHIO

SURVEYED BY: MICHAEL J WARE

CLOSURE: 0.00 : 10.000

MAP PAGE(S): 03-00-004-A

APPROVED BY: JAH DATE: 2-2-10

SCALE: 1" = 200 PRIOR INSTRUMENT: 20060143535