
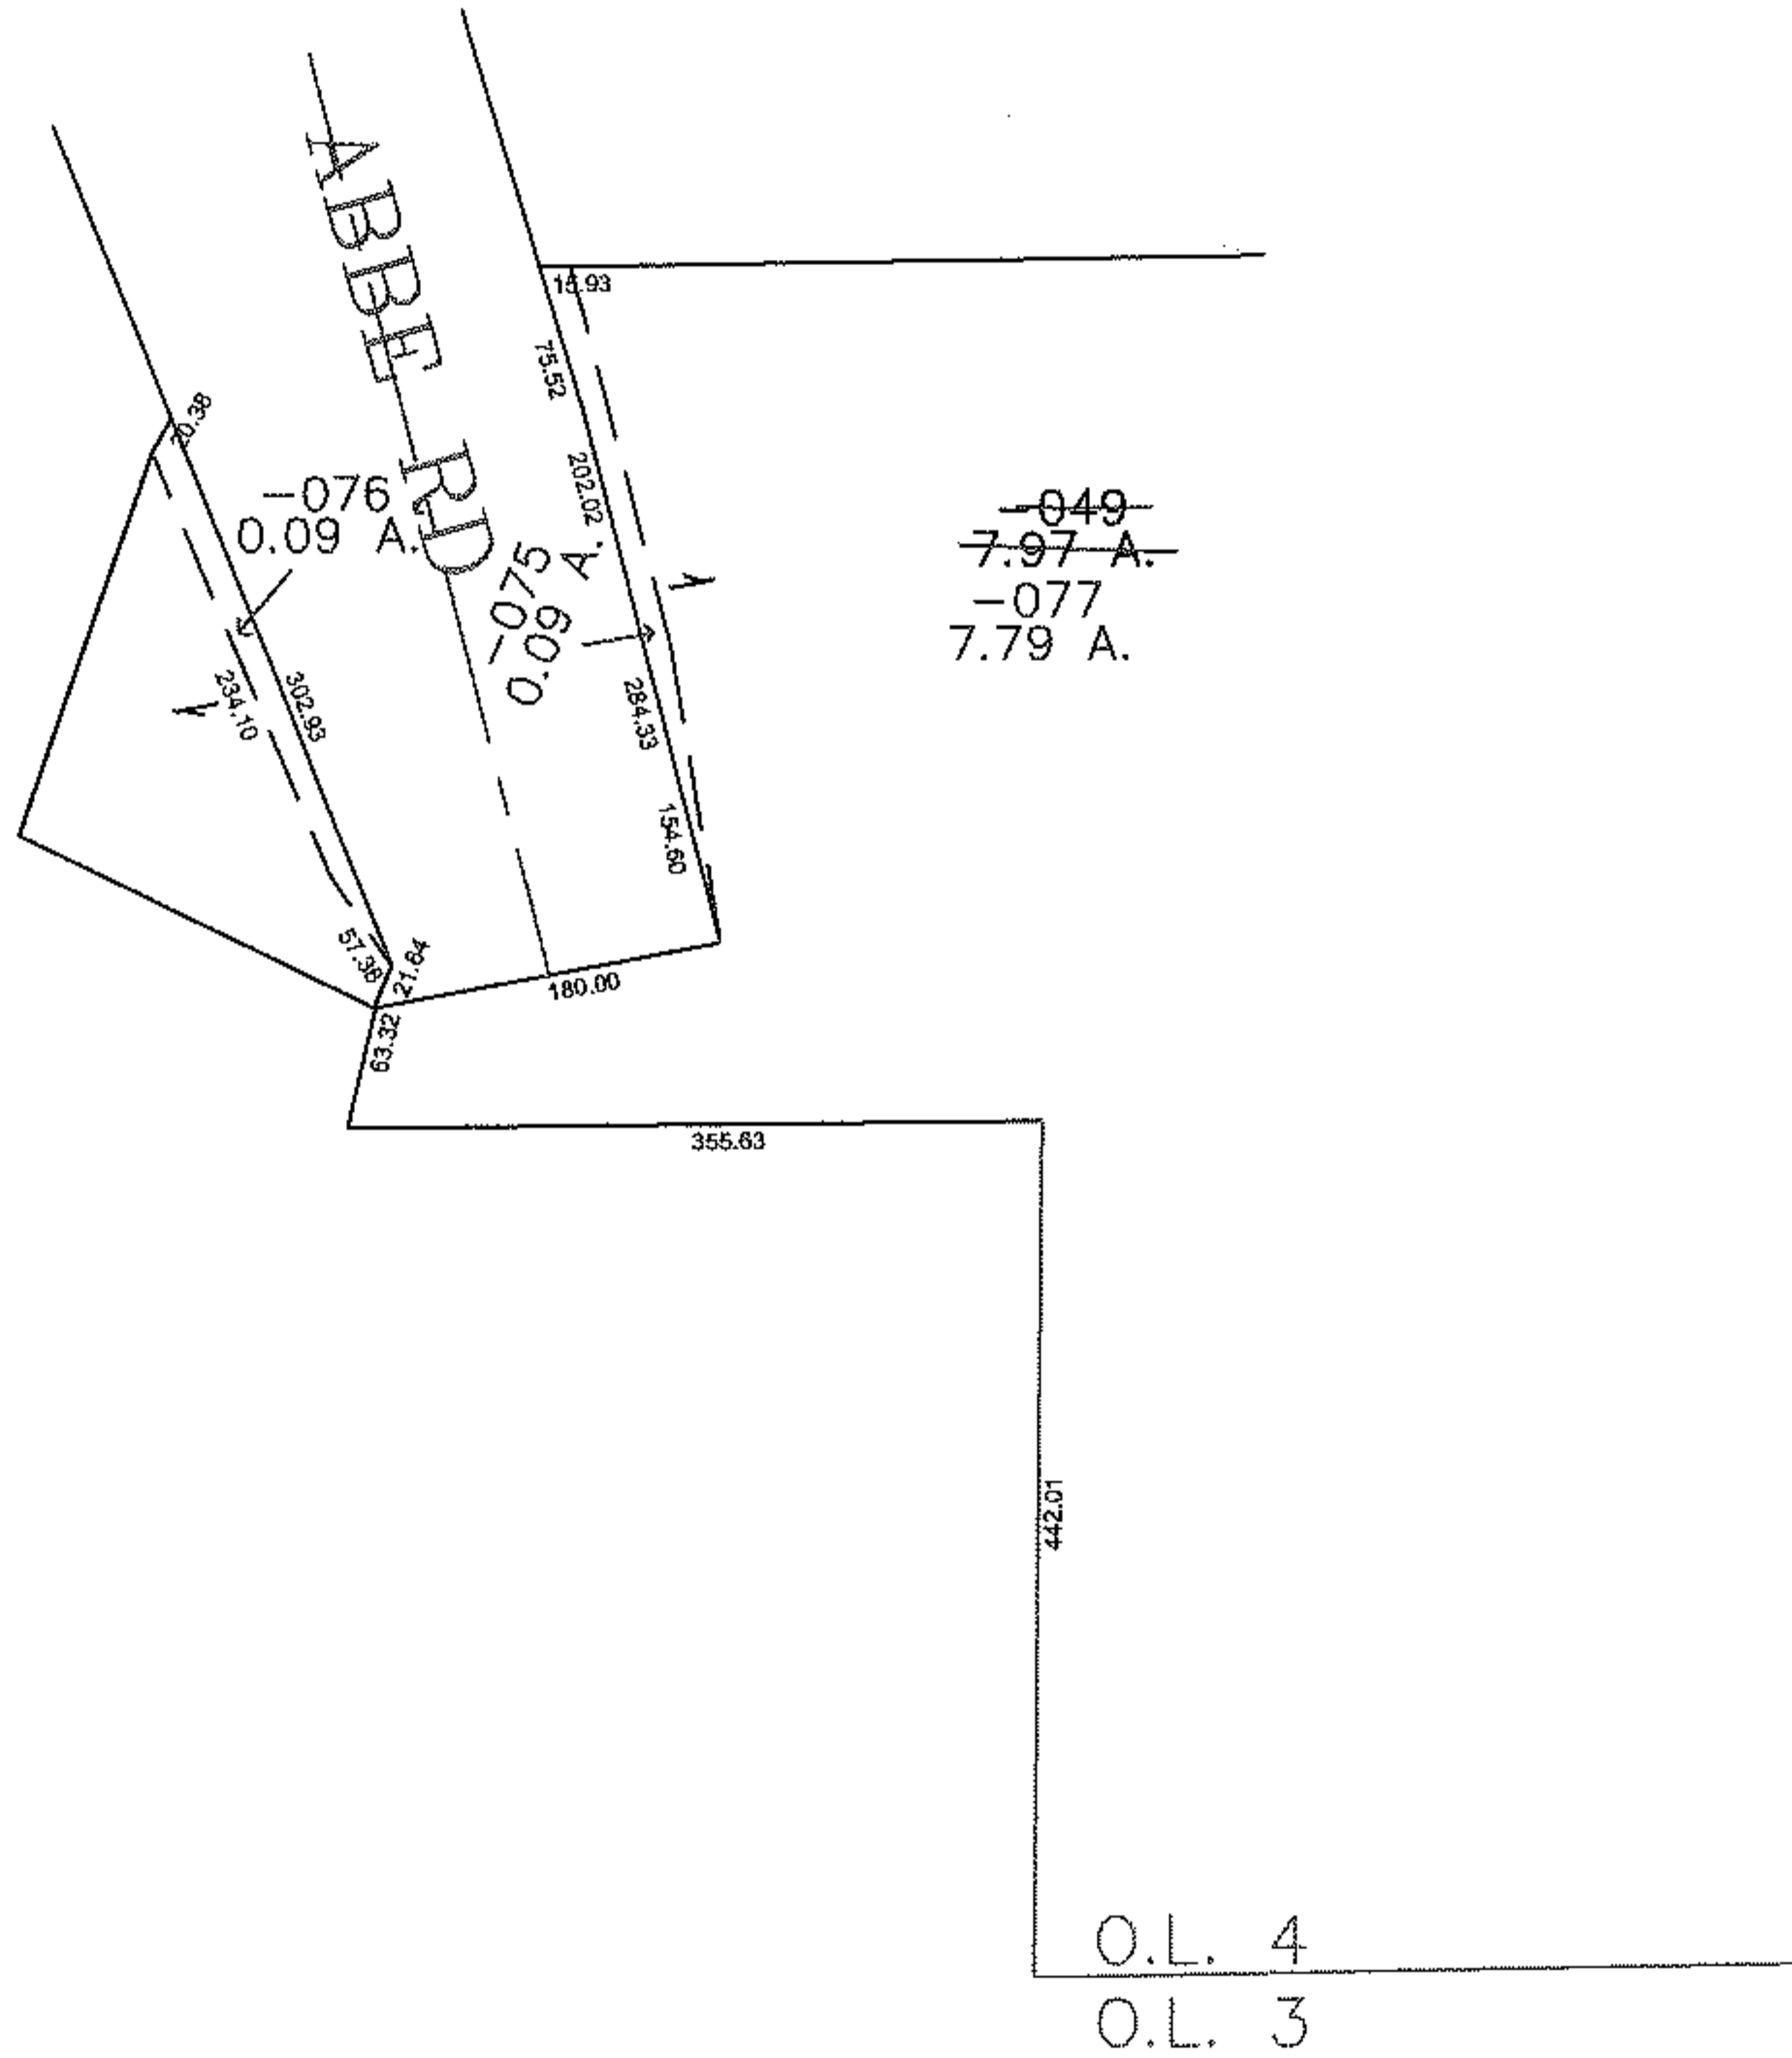


PARENT PARCEL: 03-00-004-000-049


CHILD PARCEL: 03-00-004-000-075 THRU -077

STARTING POINT: SOUTHWEST CORNER OF O.L. 4 AND O.L. 3

10-00201

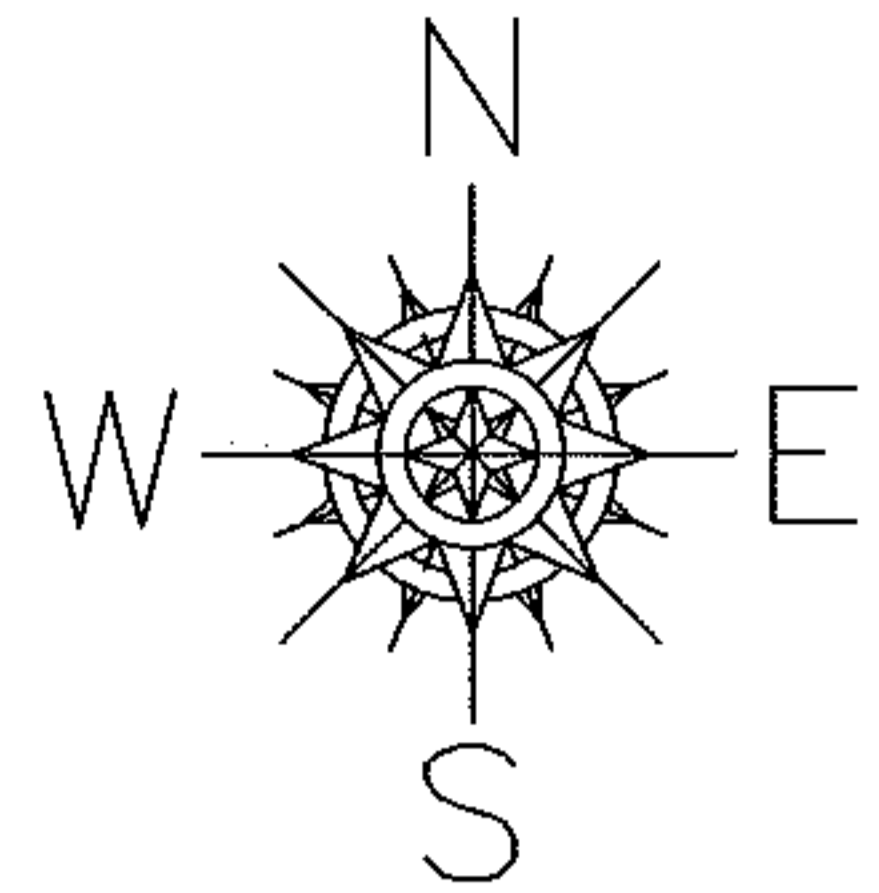

O.L. 4
O.L. 3

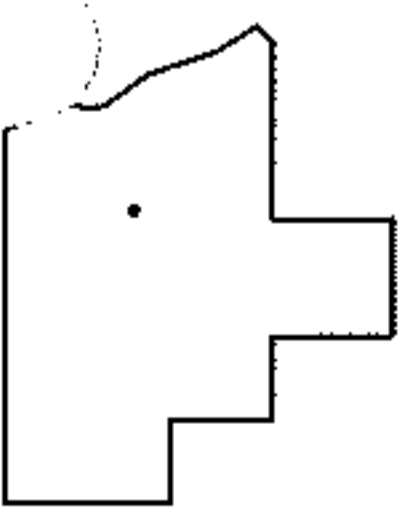

SPLITS/DEEDS PROCESSED
LORAIN COUNTY TAX MAP DEPARTMENT
226 MIDDLE AVE. ELYRIA, OHIO

SURVEYED BY: MICHAEL J WARE
 CLOSURE: 0.00 : 10,000
 MAP PAGE(S): 03-00-004-A
 APPROVED BY: JAH DATE: 2-2-10
 SCALE: 1" = 200' PRIOR INSTRUMENT: 20060143535