
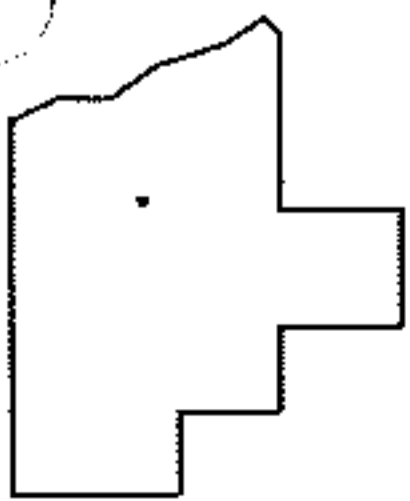
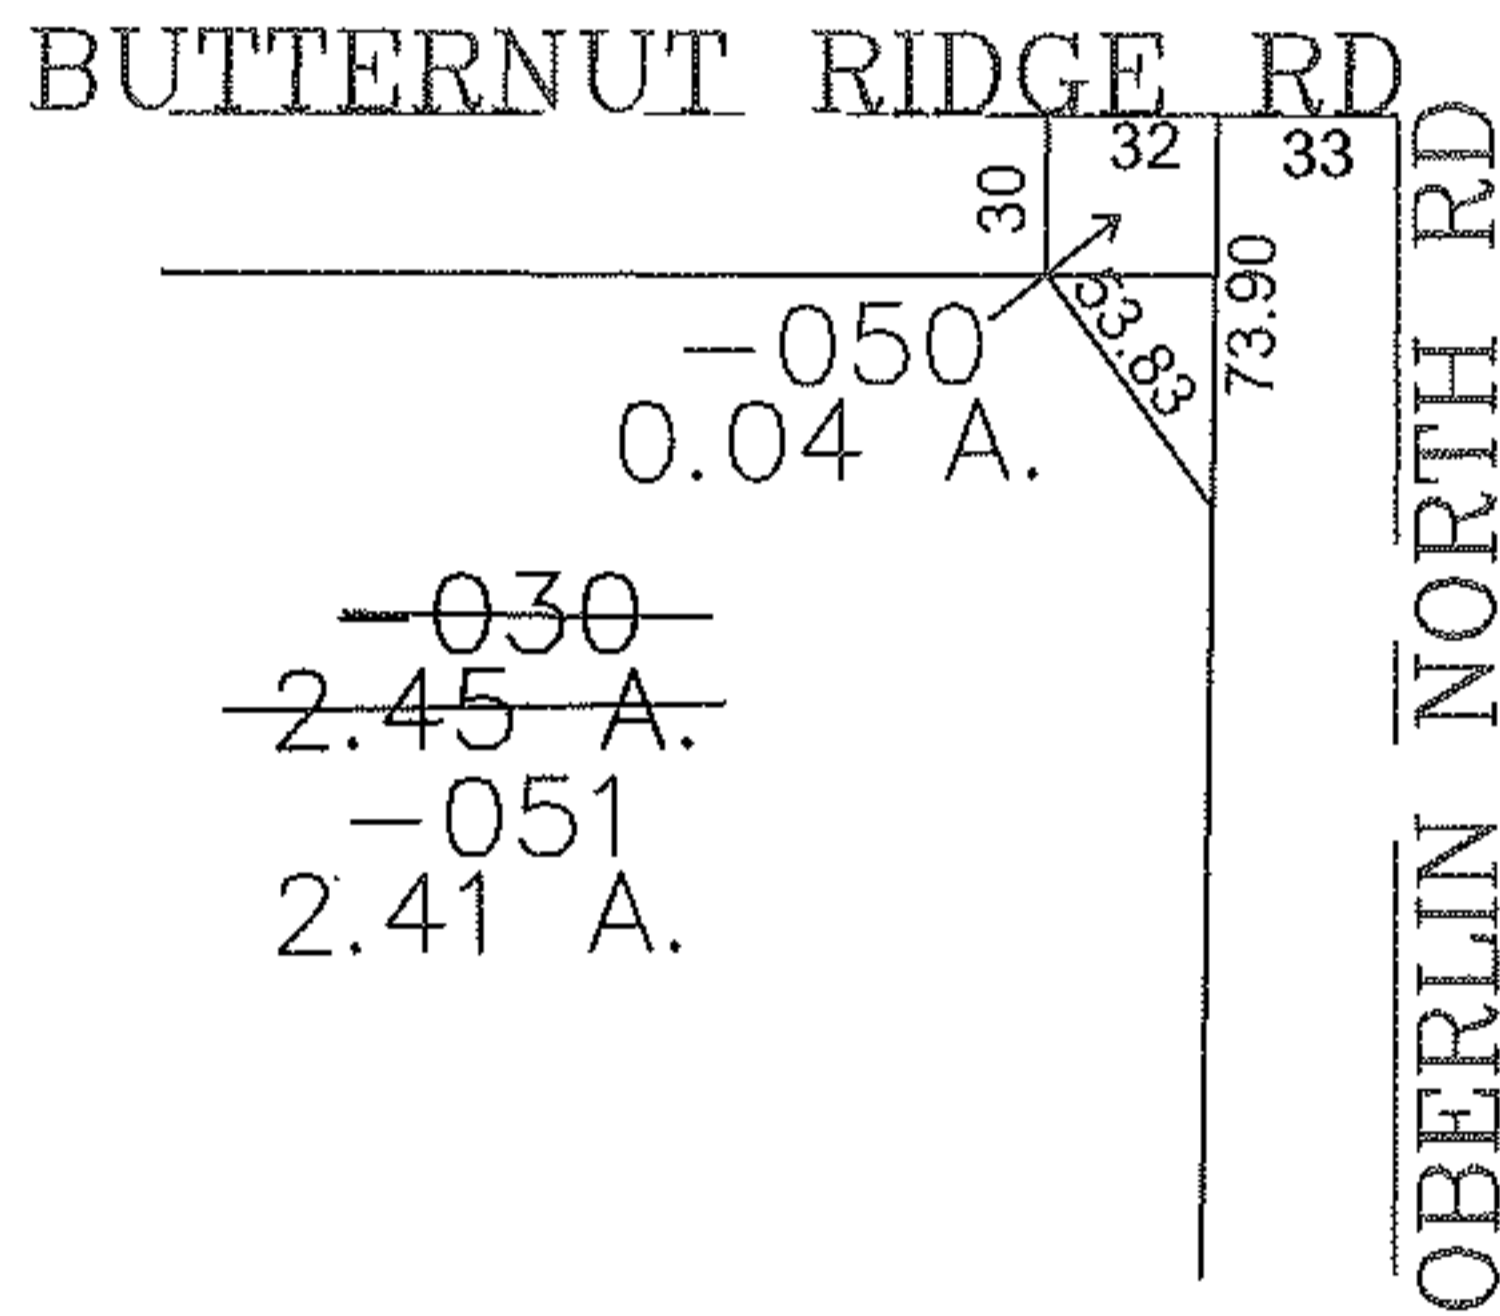


PARENT PARCEL: 09-00-065-000-030

CHILD PARCEL: 09-00-065-000-050, -051

STARTING POINT: CENTERLINE OF BUTTERNUT RIDGE RD & OBERLIN NORTH RD

10-00202

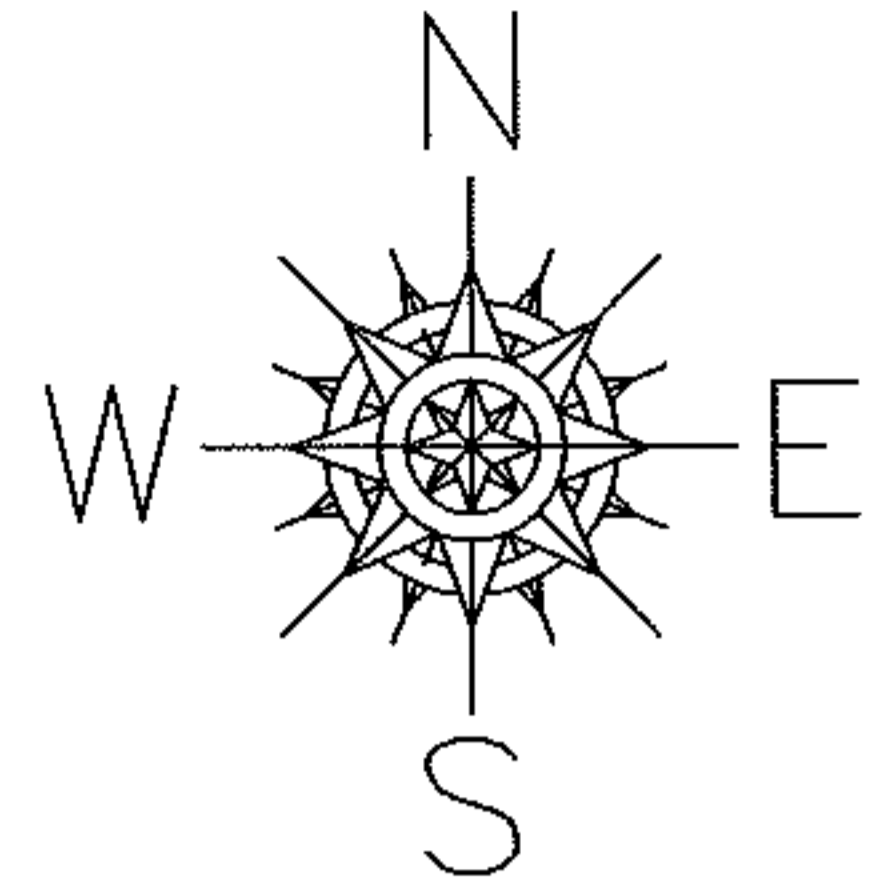

SPLITS/DEEDS PROCESSED

LORAIN COUNTY TAX MAP DEPARTMENT
226 MIDDLE AVE. ELYRIA, OHIO

SURVEYED BY: SHANE L QUEER
 CLOSURE: 0.00 : 10,000
 MAP PAGE(S): 09-00-065-B
 APPROVED BY: JAH DATE: 2-5-10
 SCALE: 1" = 100' PRIOR INSTRUMENT: 19990613221