
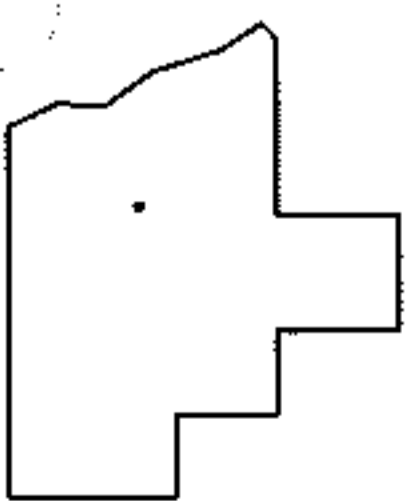
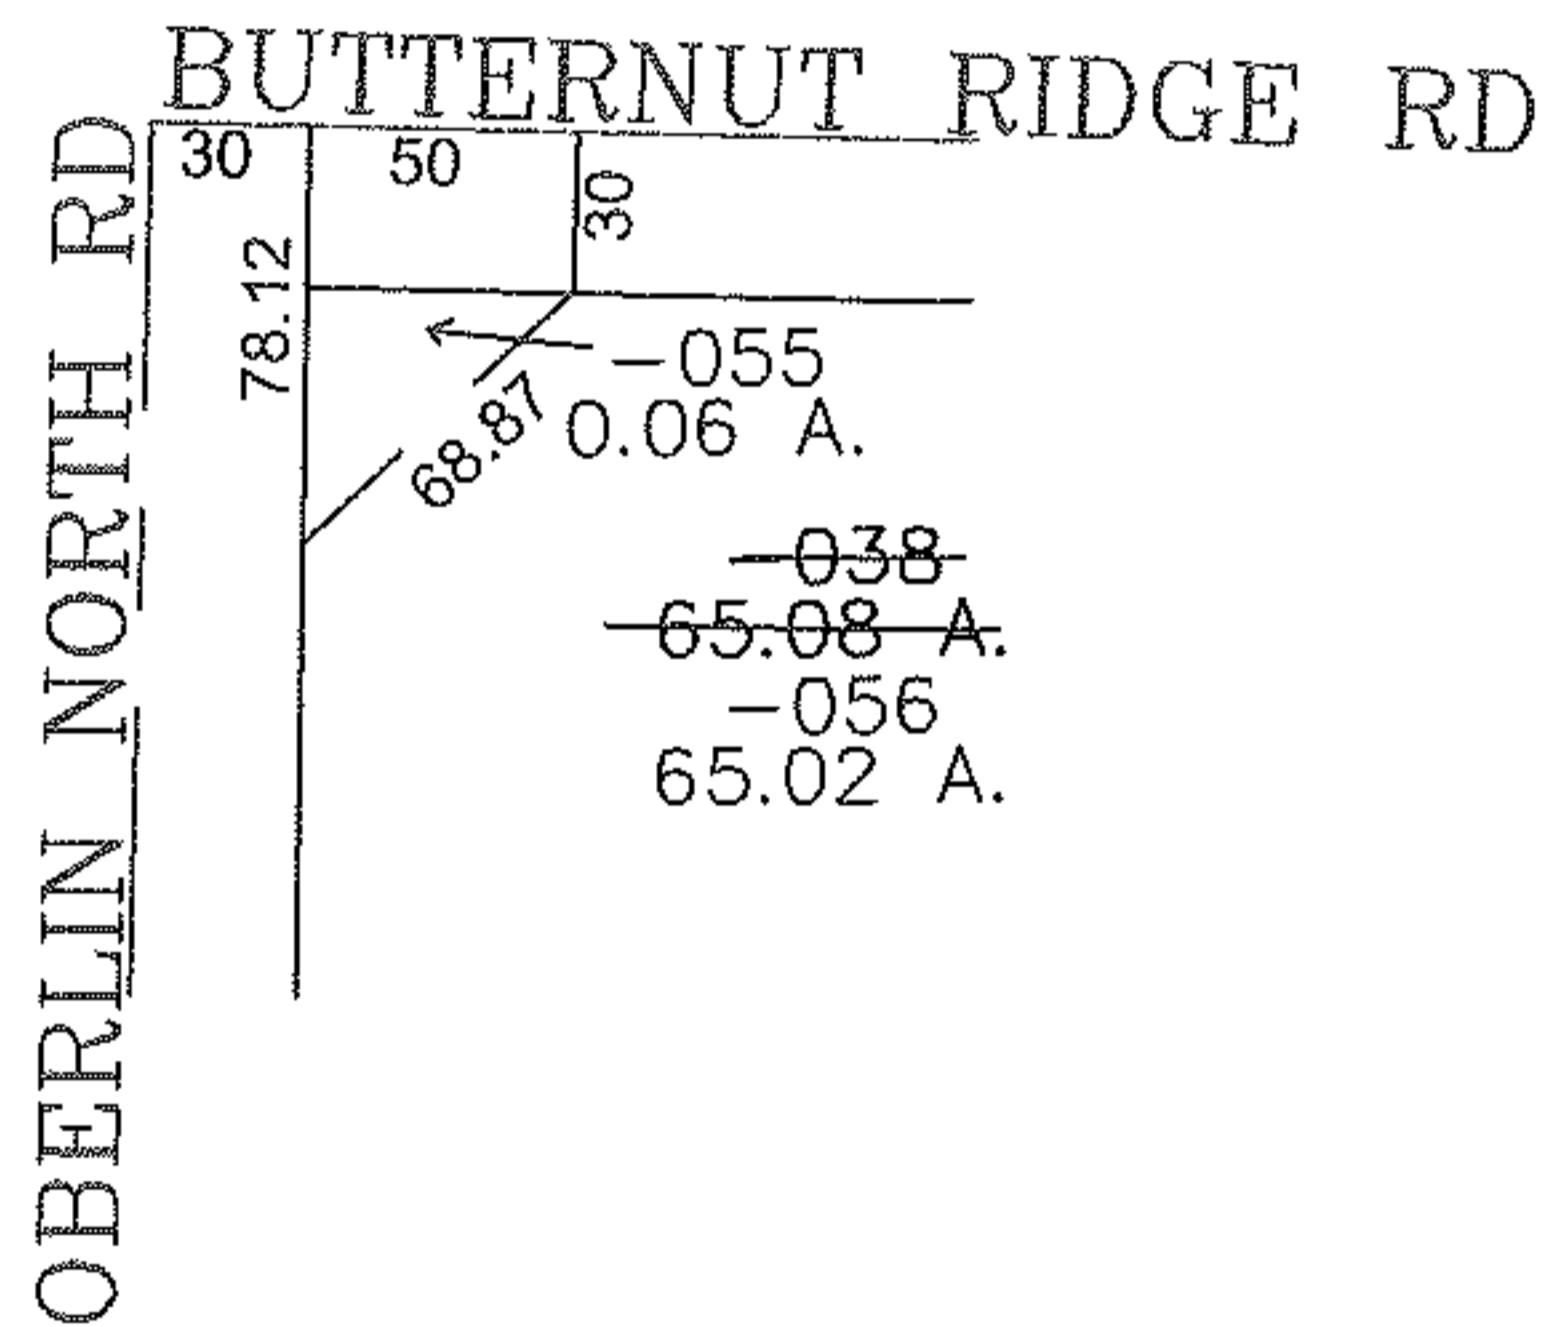


PARENT PARCEL: 09-00-066-000-038

CHILD PARCEL: 09-00-066-000-055, -056

STARTING POINT: CENTERLINE OF BUTTERNUT RIDGE RD & OBERLIN NORTH RD

10-00203

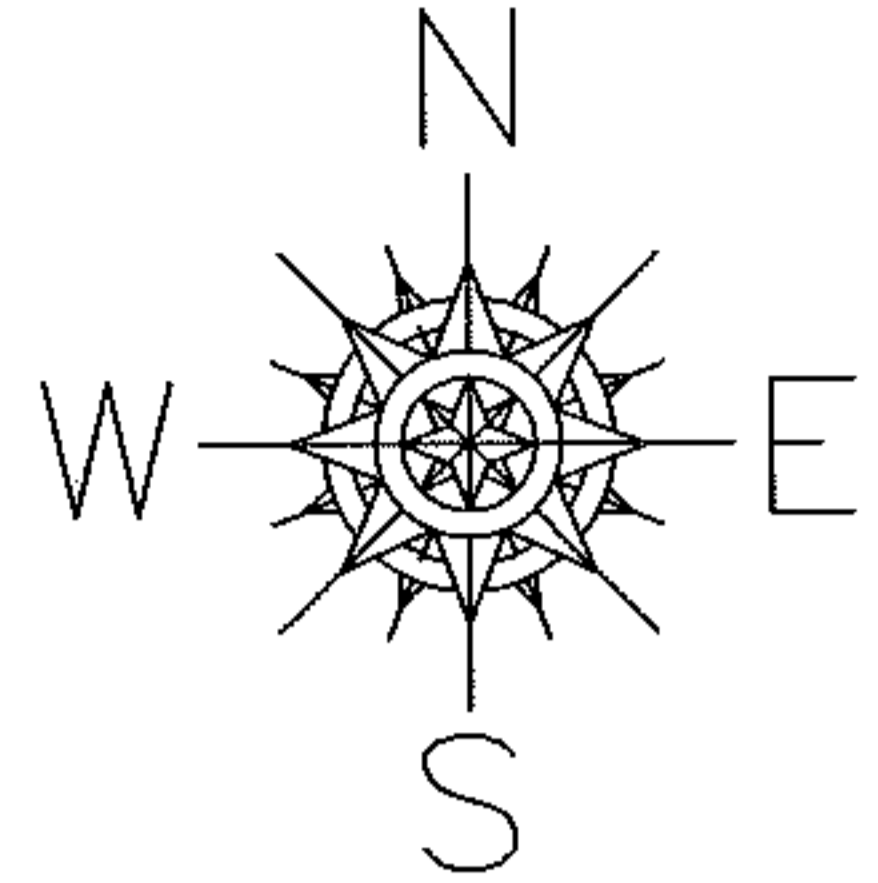

SPLITS/DEEDS PROCESSED

LORAIN COUNTY TAX MAP DEPARTMENT  
226 MIDDLE AVE. ELYRIA, OHIO

SURVEYED BY: SHANE L QUEER

CLOSURE: 0.00 : 10.000

MAP PAGE(S): 09-00-066-B

APPROVED BY: JAH DATE: 2-5-10

SCALE: 1" = 100 PRIOR INSTRUMENT: 19990598439