


PARENT PARCEL: 09-00-055-000-028

10-00204

CHILD PARCEL: 09-00-055-000-034, 035

STARTING POINT: CENTERLINE OF BUTTERNUT RIDGE RD & OBERLIN-ASHLAND RD

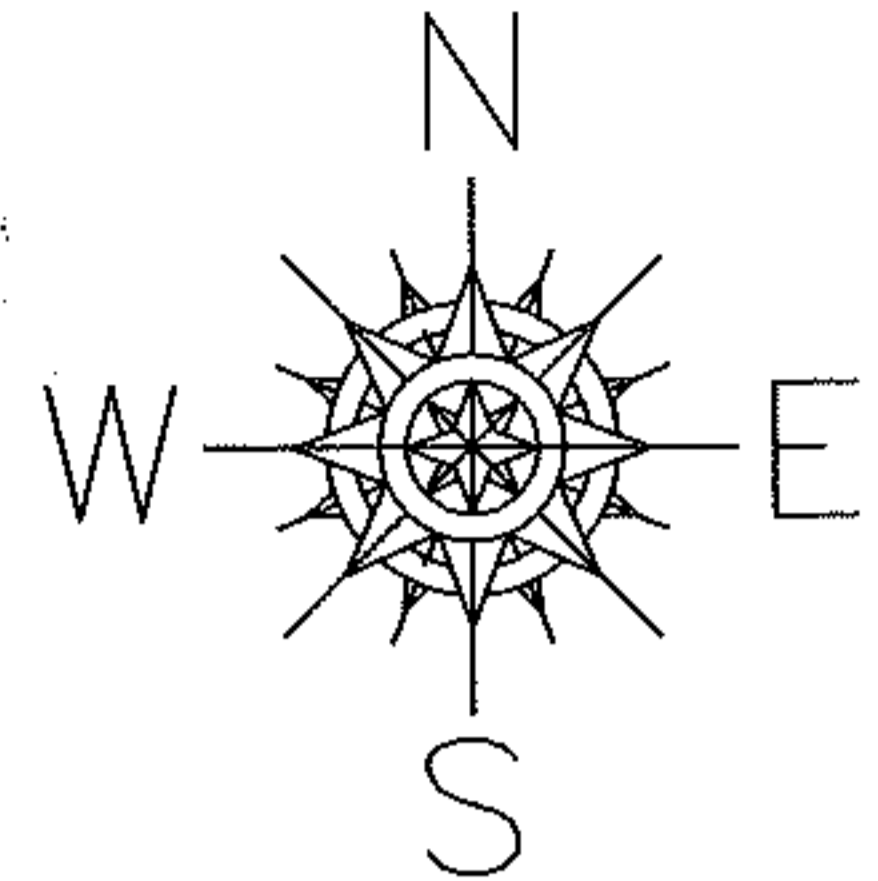


~~-028~~  
~~1.23 A.~~  
-035  
1.14 A.

-034  
0.08 A. 30  
47.44'  
30 65.00 61.60

OBERLIN-ASHLAND RD

BUTTERNUT RIDGE RD

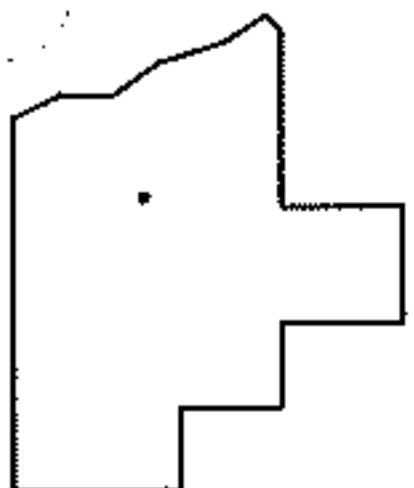

SPLITS/DEEDS PROCESSED

LORAIN COUNTY TAX MAP DEPARTMENT  
226 MIDDLE AVE. ELYRIA, OHIO

SURVEYED BY: SHANE L QUEER

CLOSURE: 0.00 : 10,000

MAP PAGE(S): 9-F

APPROVED BY: JAH DATE: 2-5-10

SCALE: 1" = 50' PRIOR INST.: 20080263757