
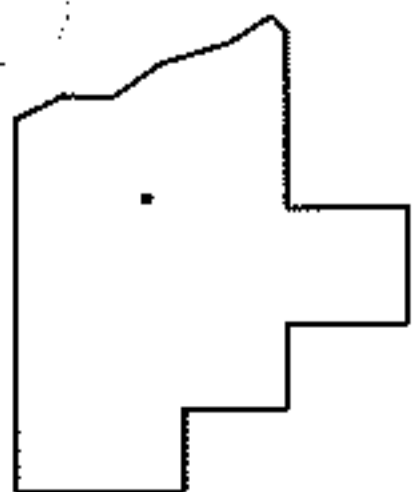
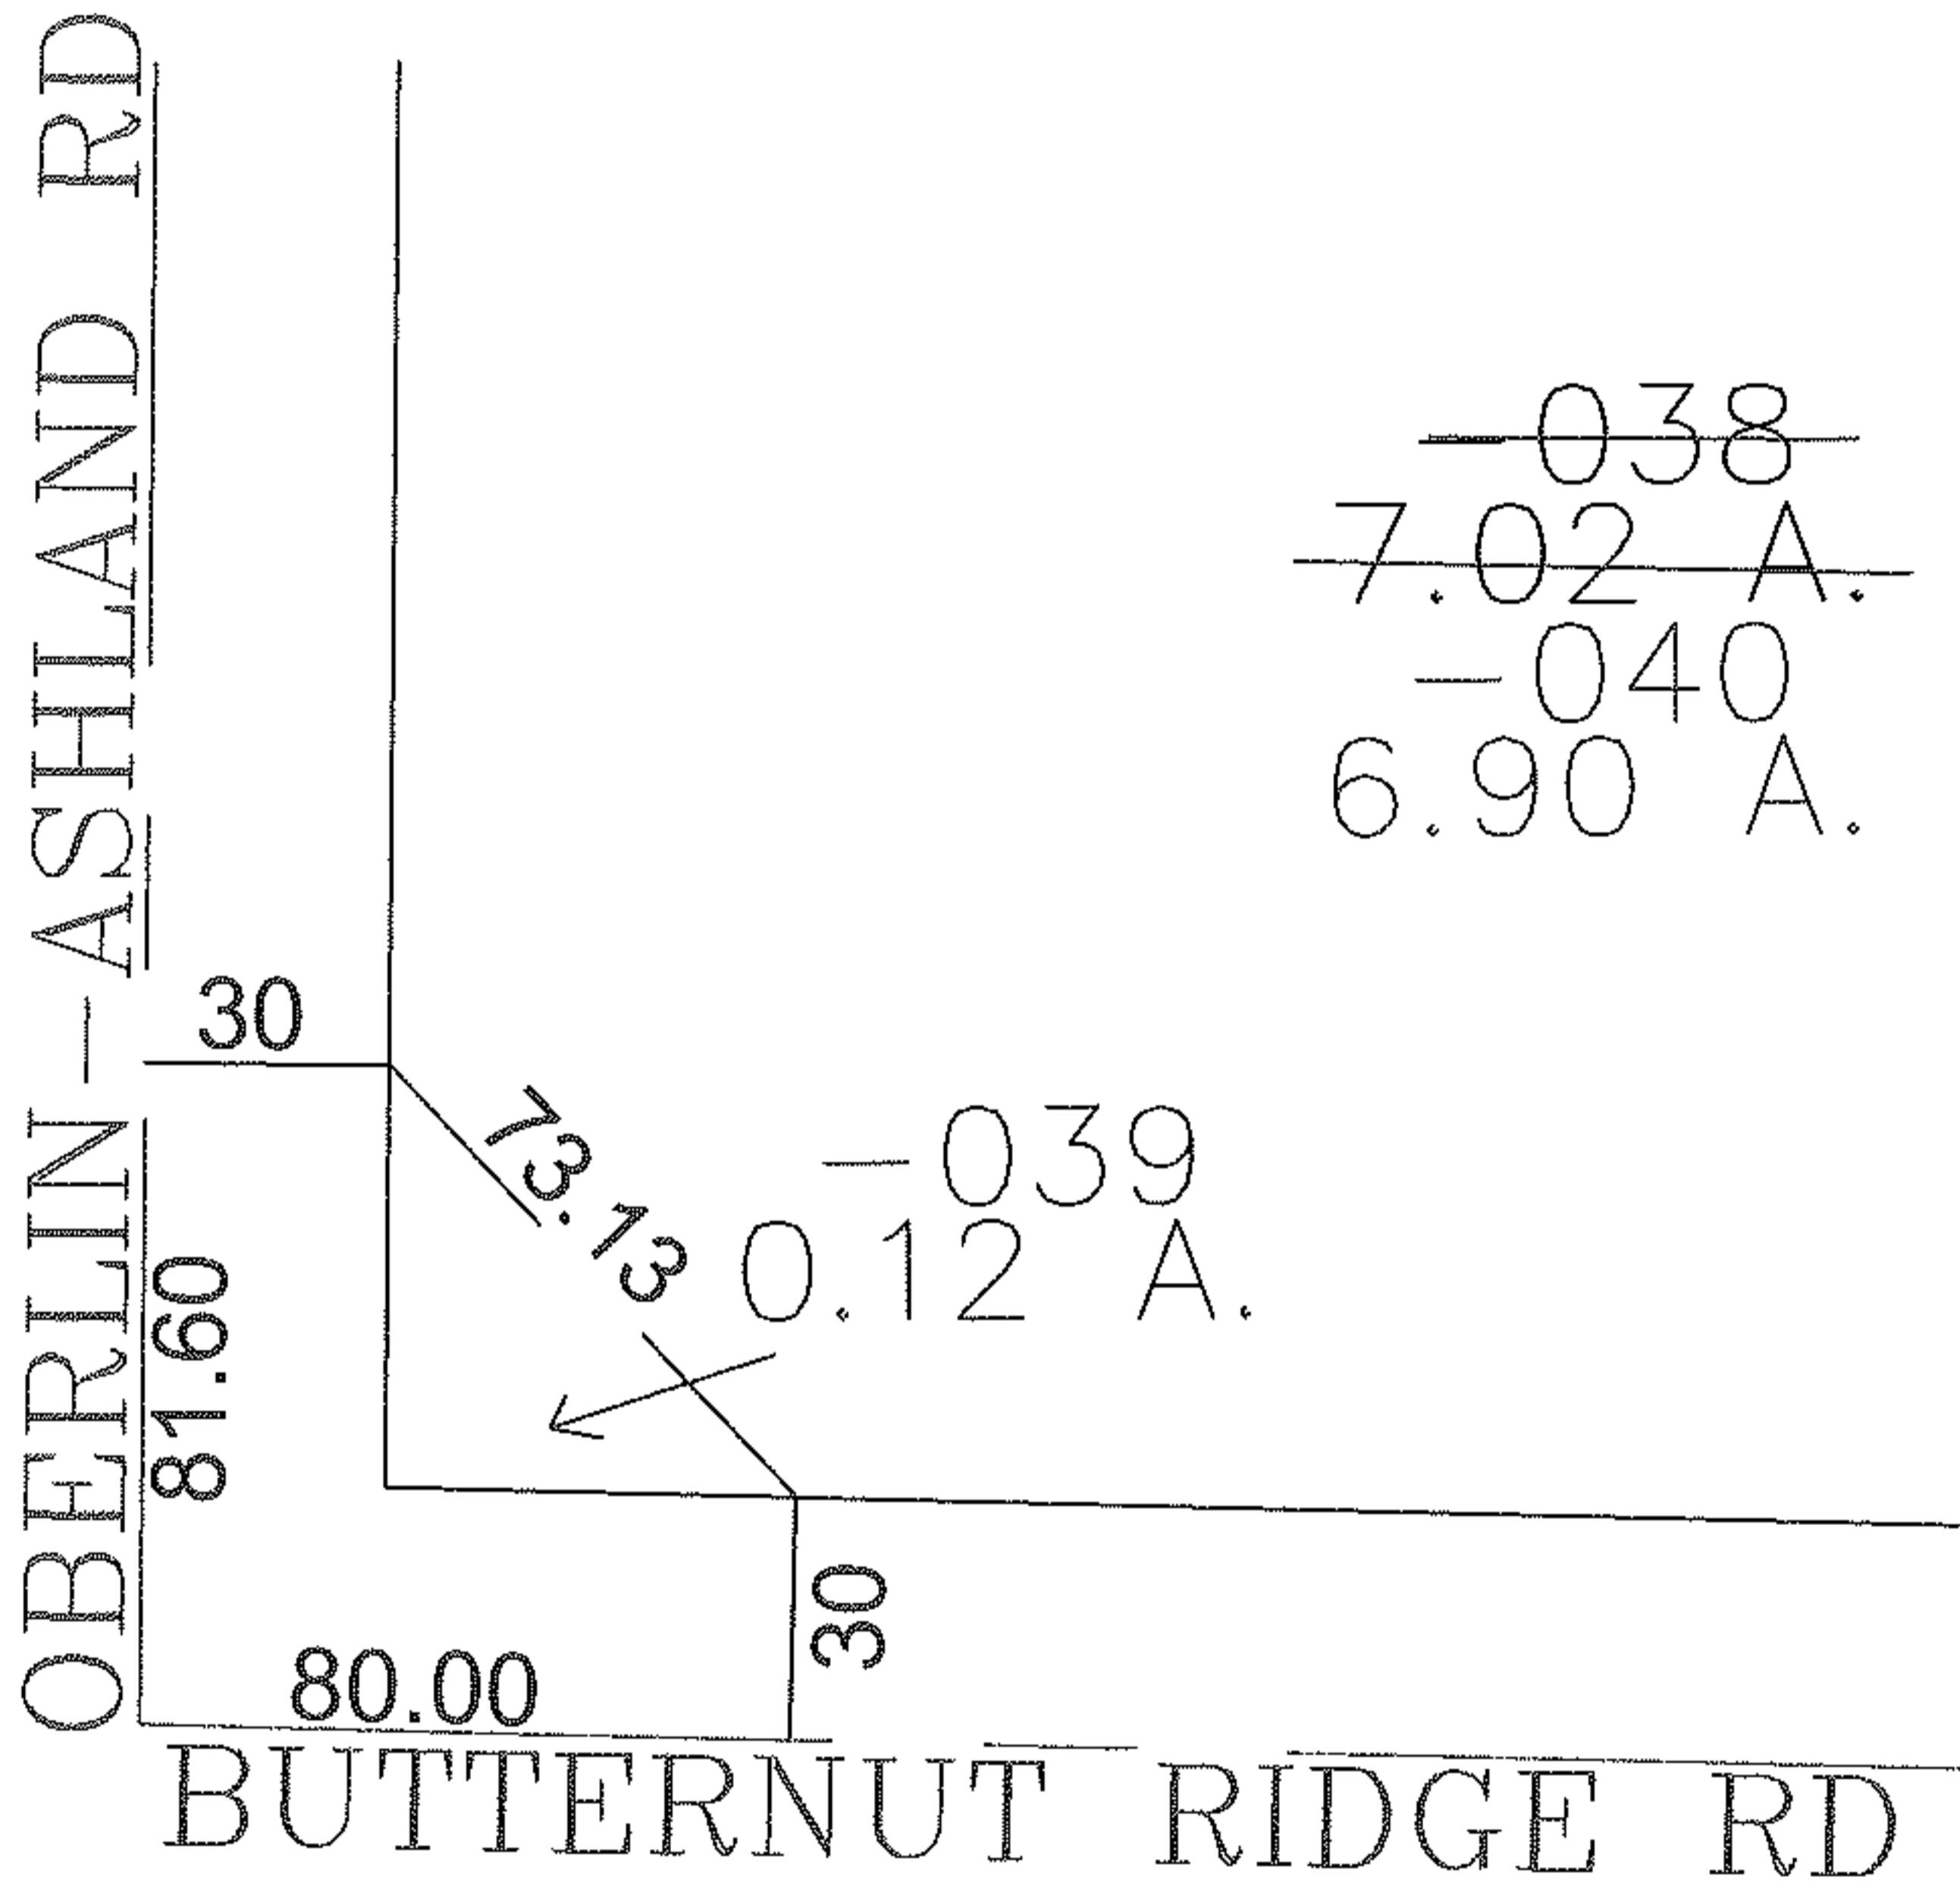


PARENT PARCEL: 09-00-056-000-038

CHILD PARCEL: 09-00-056-000-039, -040

STARTING POINT: CENTERLINE OF BUTTERNUT RIDGE RD & OBERLIN-ASHLAND RD

10-00205

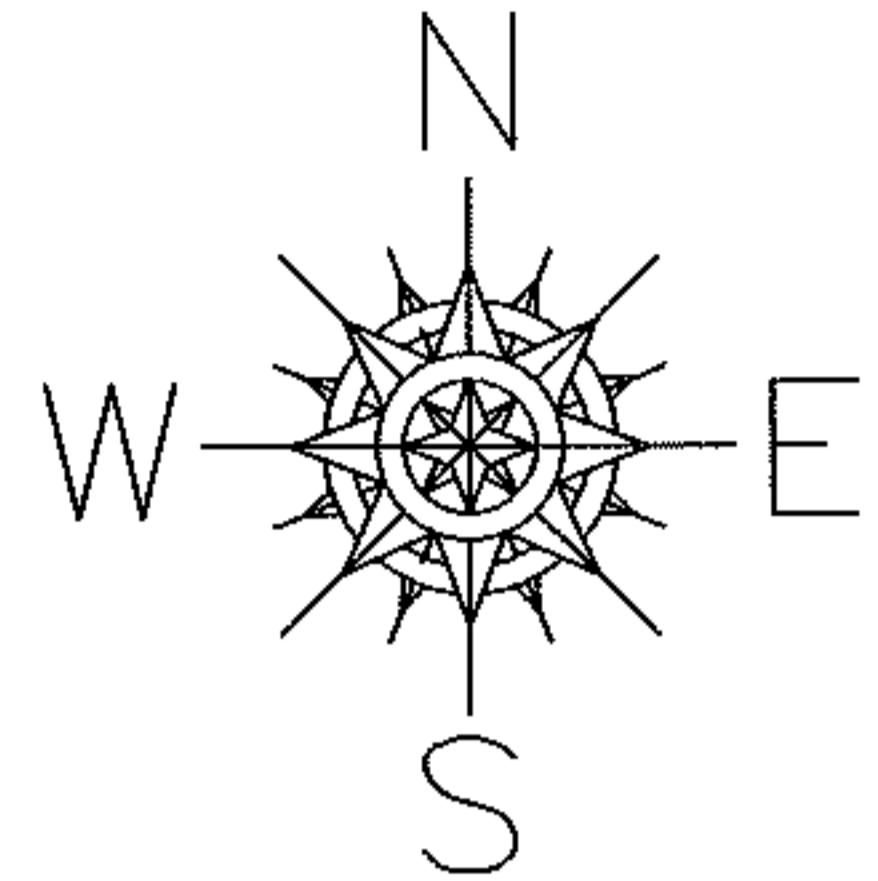

SPLITS/DEEDS PROCESSED

LORAIN COUNTY TAX MAP DEPARTMENT  
226 MIDDLE AVE. ELYRIA, OHIO

SURVEYED BY: SHANE L QUEER

CLOSURE: 0.00 : 10,000

MAP PAGE(S): 9-G

APPROVED BY: JAH DATE: 2-5-10

SCALE: 1" = 50' PRIOR INST.: 20030972749