


PARENT PARCEL: 09-00-065-000-026, -030

CHILD PARCEL: 09-00-065-000-052 THRU -064

STARTING POINT: CENTERLINE OF BUTTERNUT RIDGE RD & LEAVITT RD

10-00206

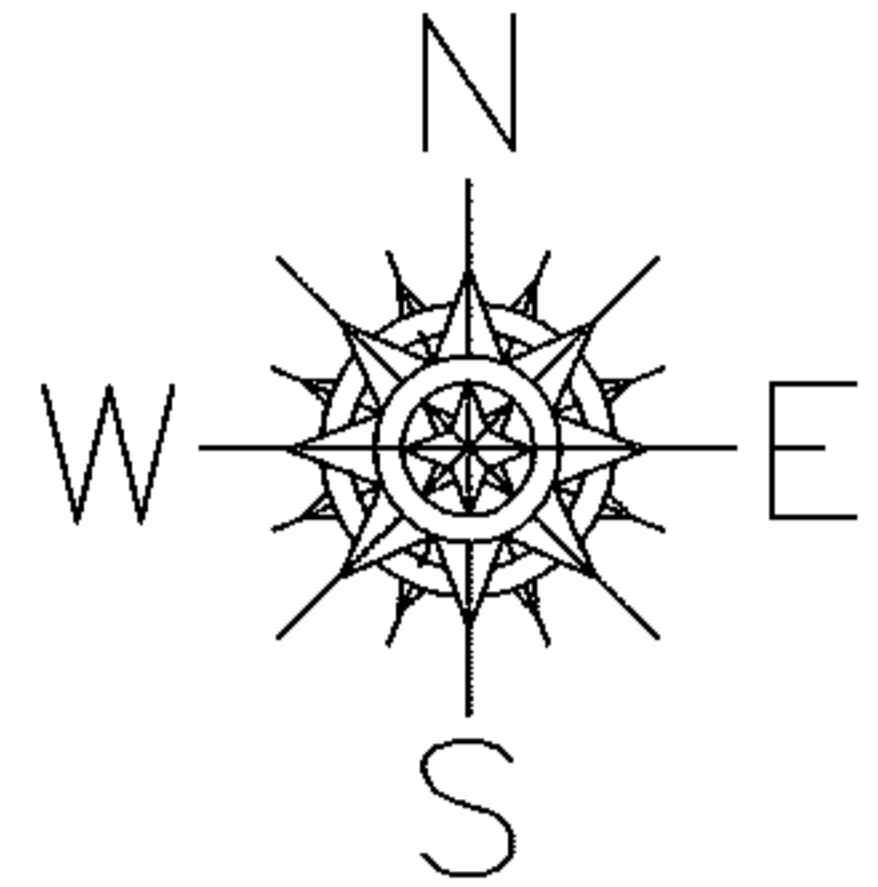

~~BUTTERNUT RIDGE RD~~

~~-051~~
~~2.41 A.~~
~~-054~~
2.25 A.

~~-026~~
~~2.68 A.~~
~~-053~~
2.51 A.

33

438.29
0.32 A.


RD

438.27

-052

LEAVITT

33

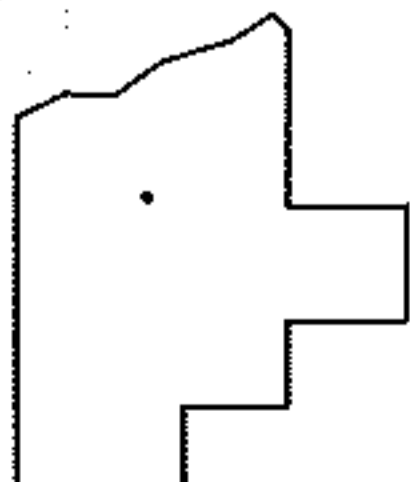

SPLITS/DEEDS PROCESSED

LORAIN COUNTY TAX MAP DEPARTMENT
226 MIDDLE AVE. ELYRIA, OHIO

SURVEYED BY: SHANE L QUEER
CLOSURE: 0.00 : 10.000
MAP PAGE(S): 09-00-065-B
APPROVED BY: JAH DATE: 2-8-10
SCALE: 1" = 100 PRIOR INSTRUMENT: 19990582919