
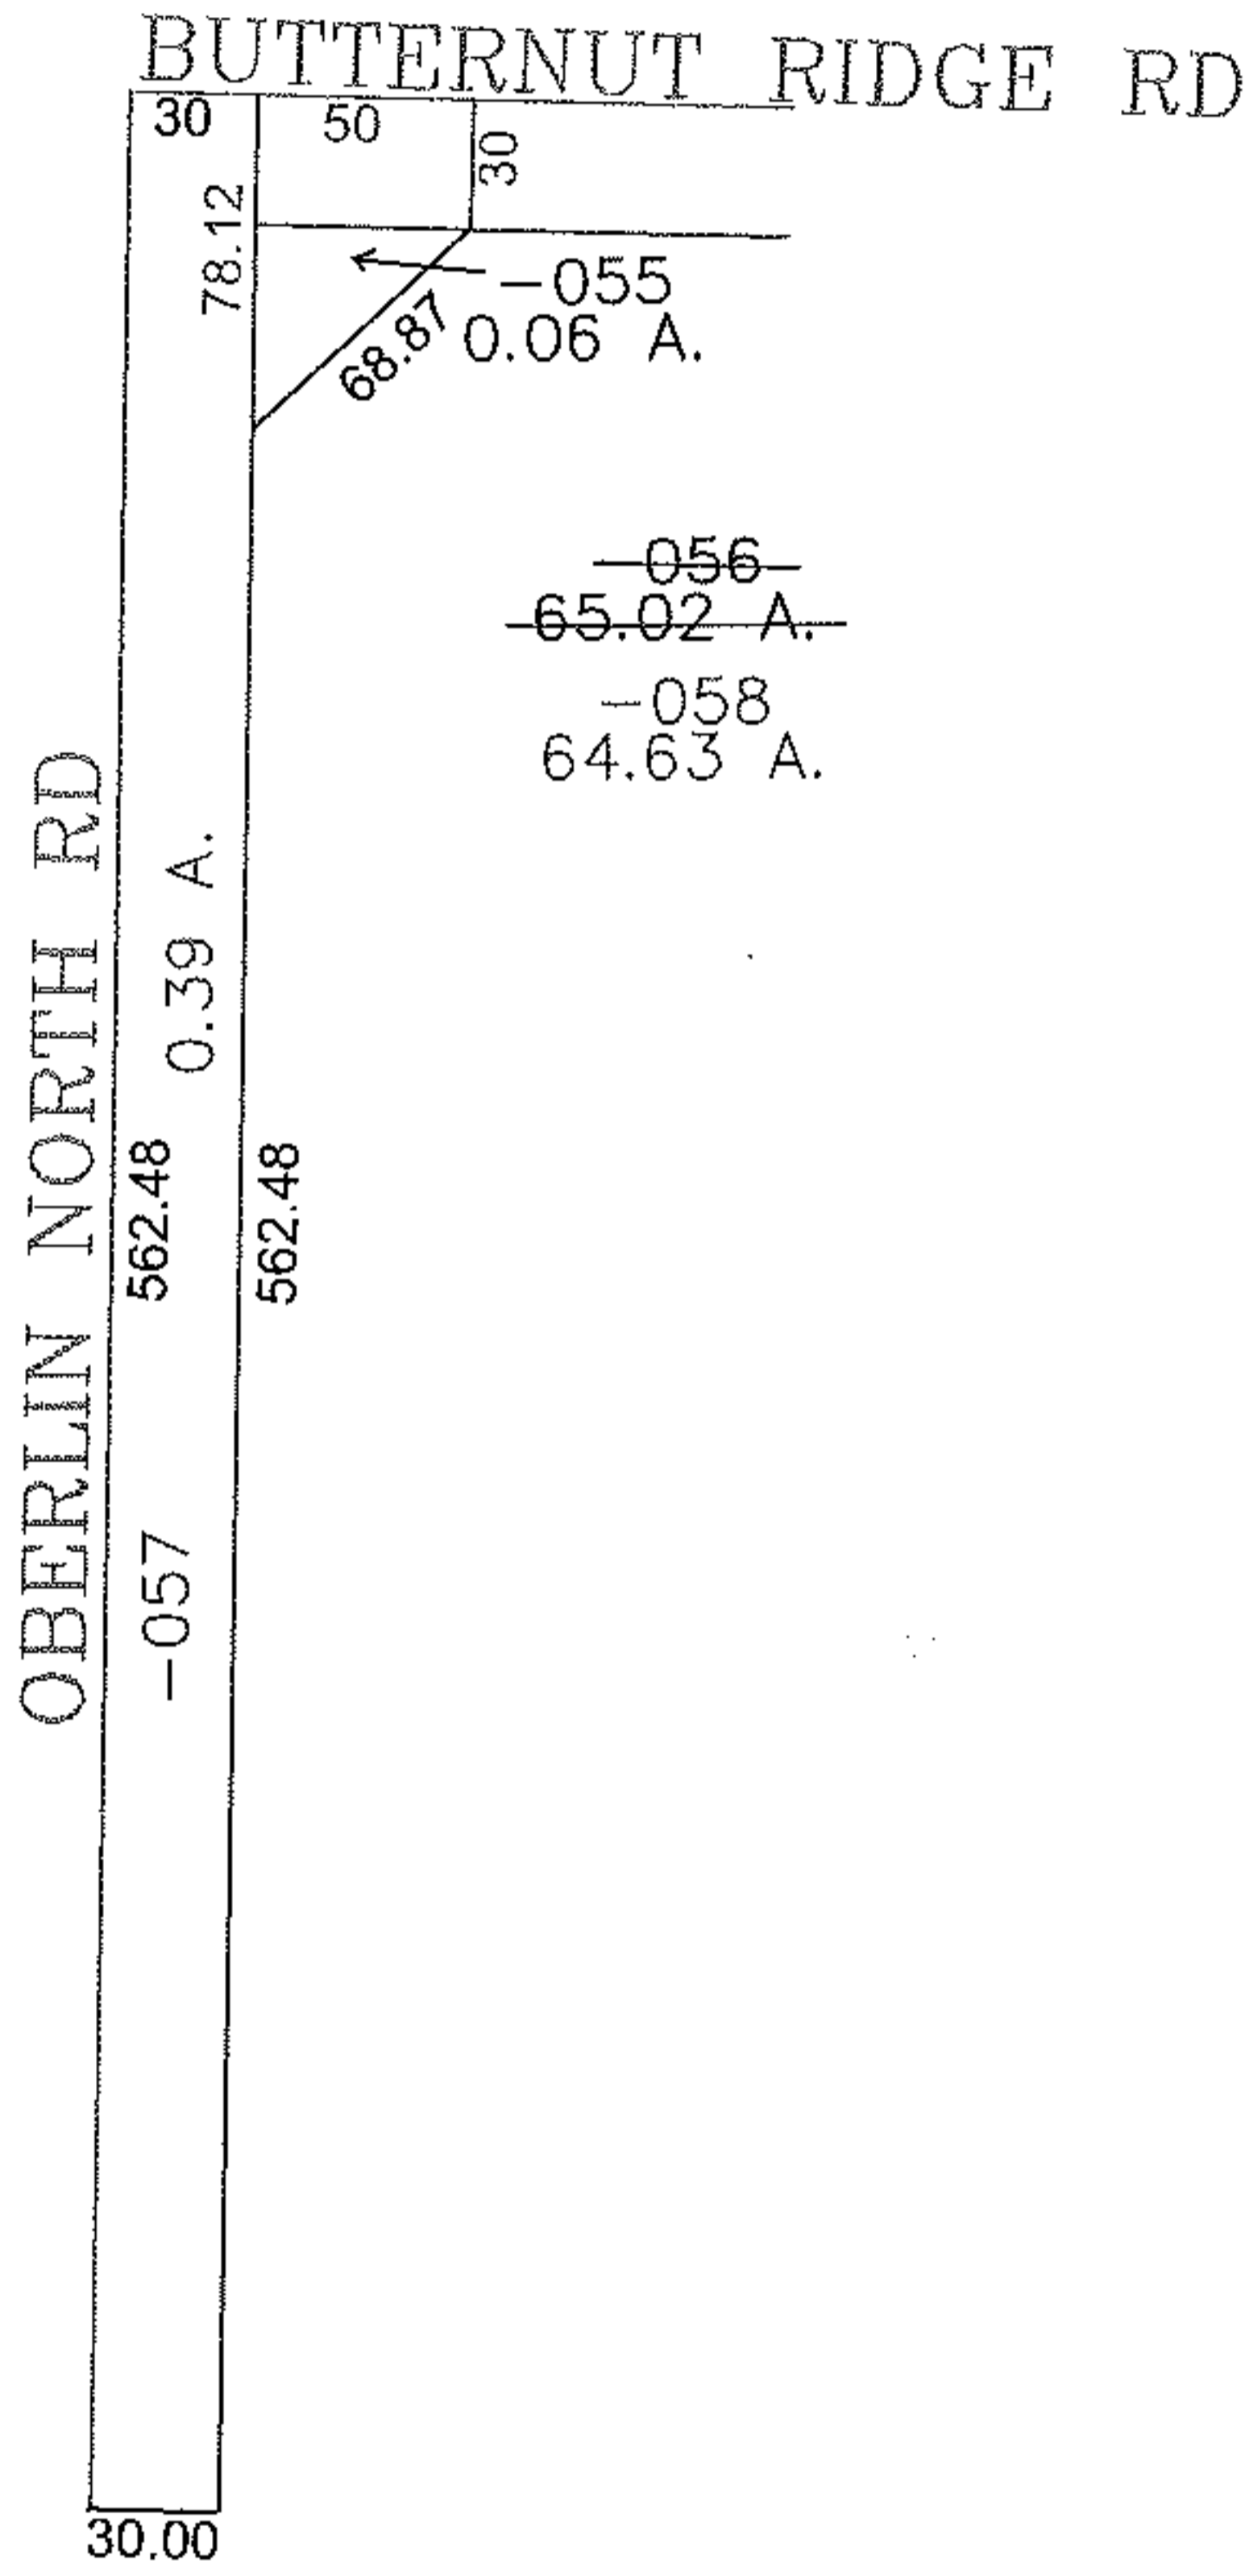


PARENT PARCEL: 09-00-066-000-056

CHILD PARCEL: 09-00-066-000-057, -058

STARTING POINT: CENTERLINE OF BUTTERNUT RIDGE RD & OBERLIN NORTH RD

10-00208

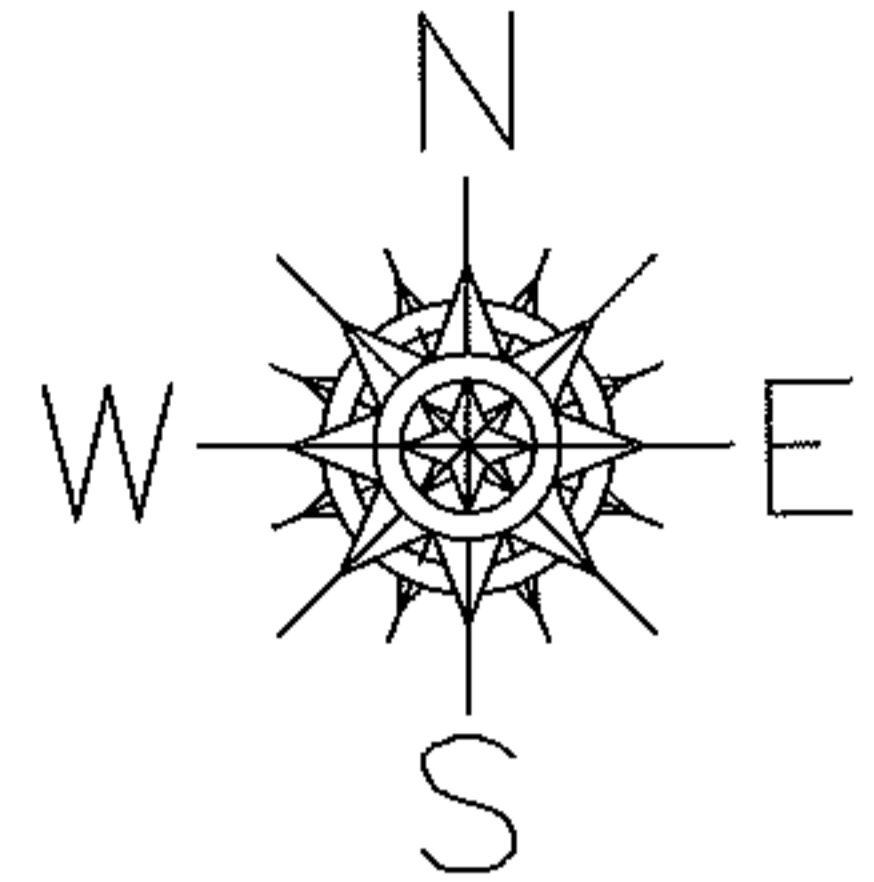

SPLITS/DEEDS PROCESSED

LORAIN COUNTY TAX MAP DEPARTMENT
226 MIDDLE AVE. ELYRIA, OHIO

SURVEYED BY: SHANE L QUEER
 CLOSURE: 0.00 : 10,000
 MAP PAGE(S): 09-00-066-B
 APPROVED BY: JAH DATE: 5-4-10
 SCALE: 1" = 100 PRIOR INSTRUMENT: 19990598439