
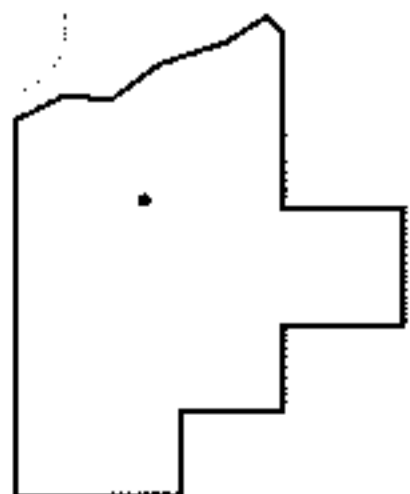
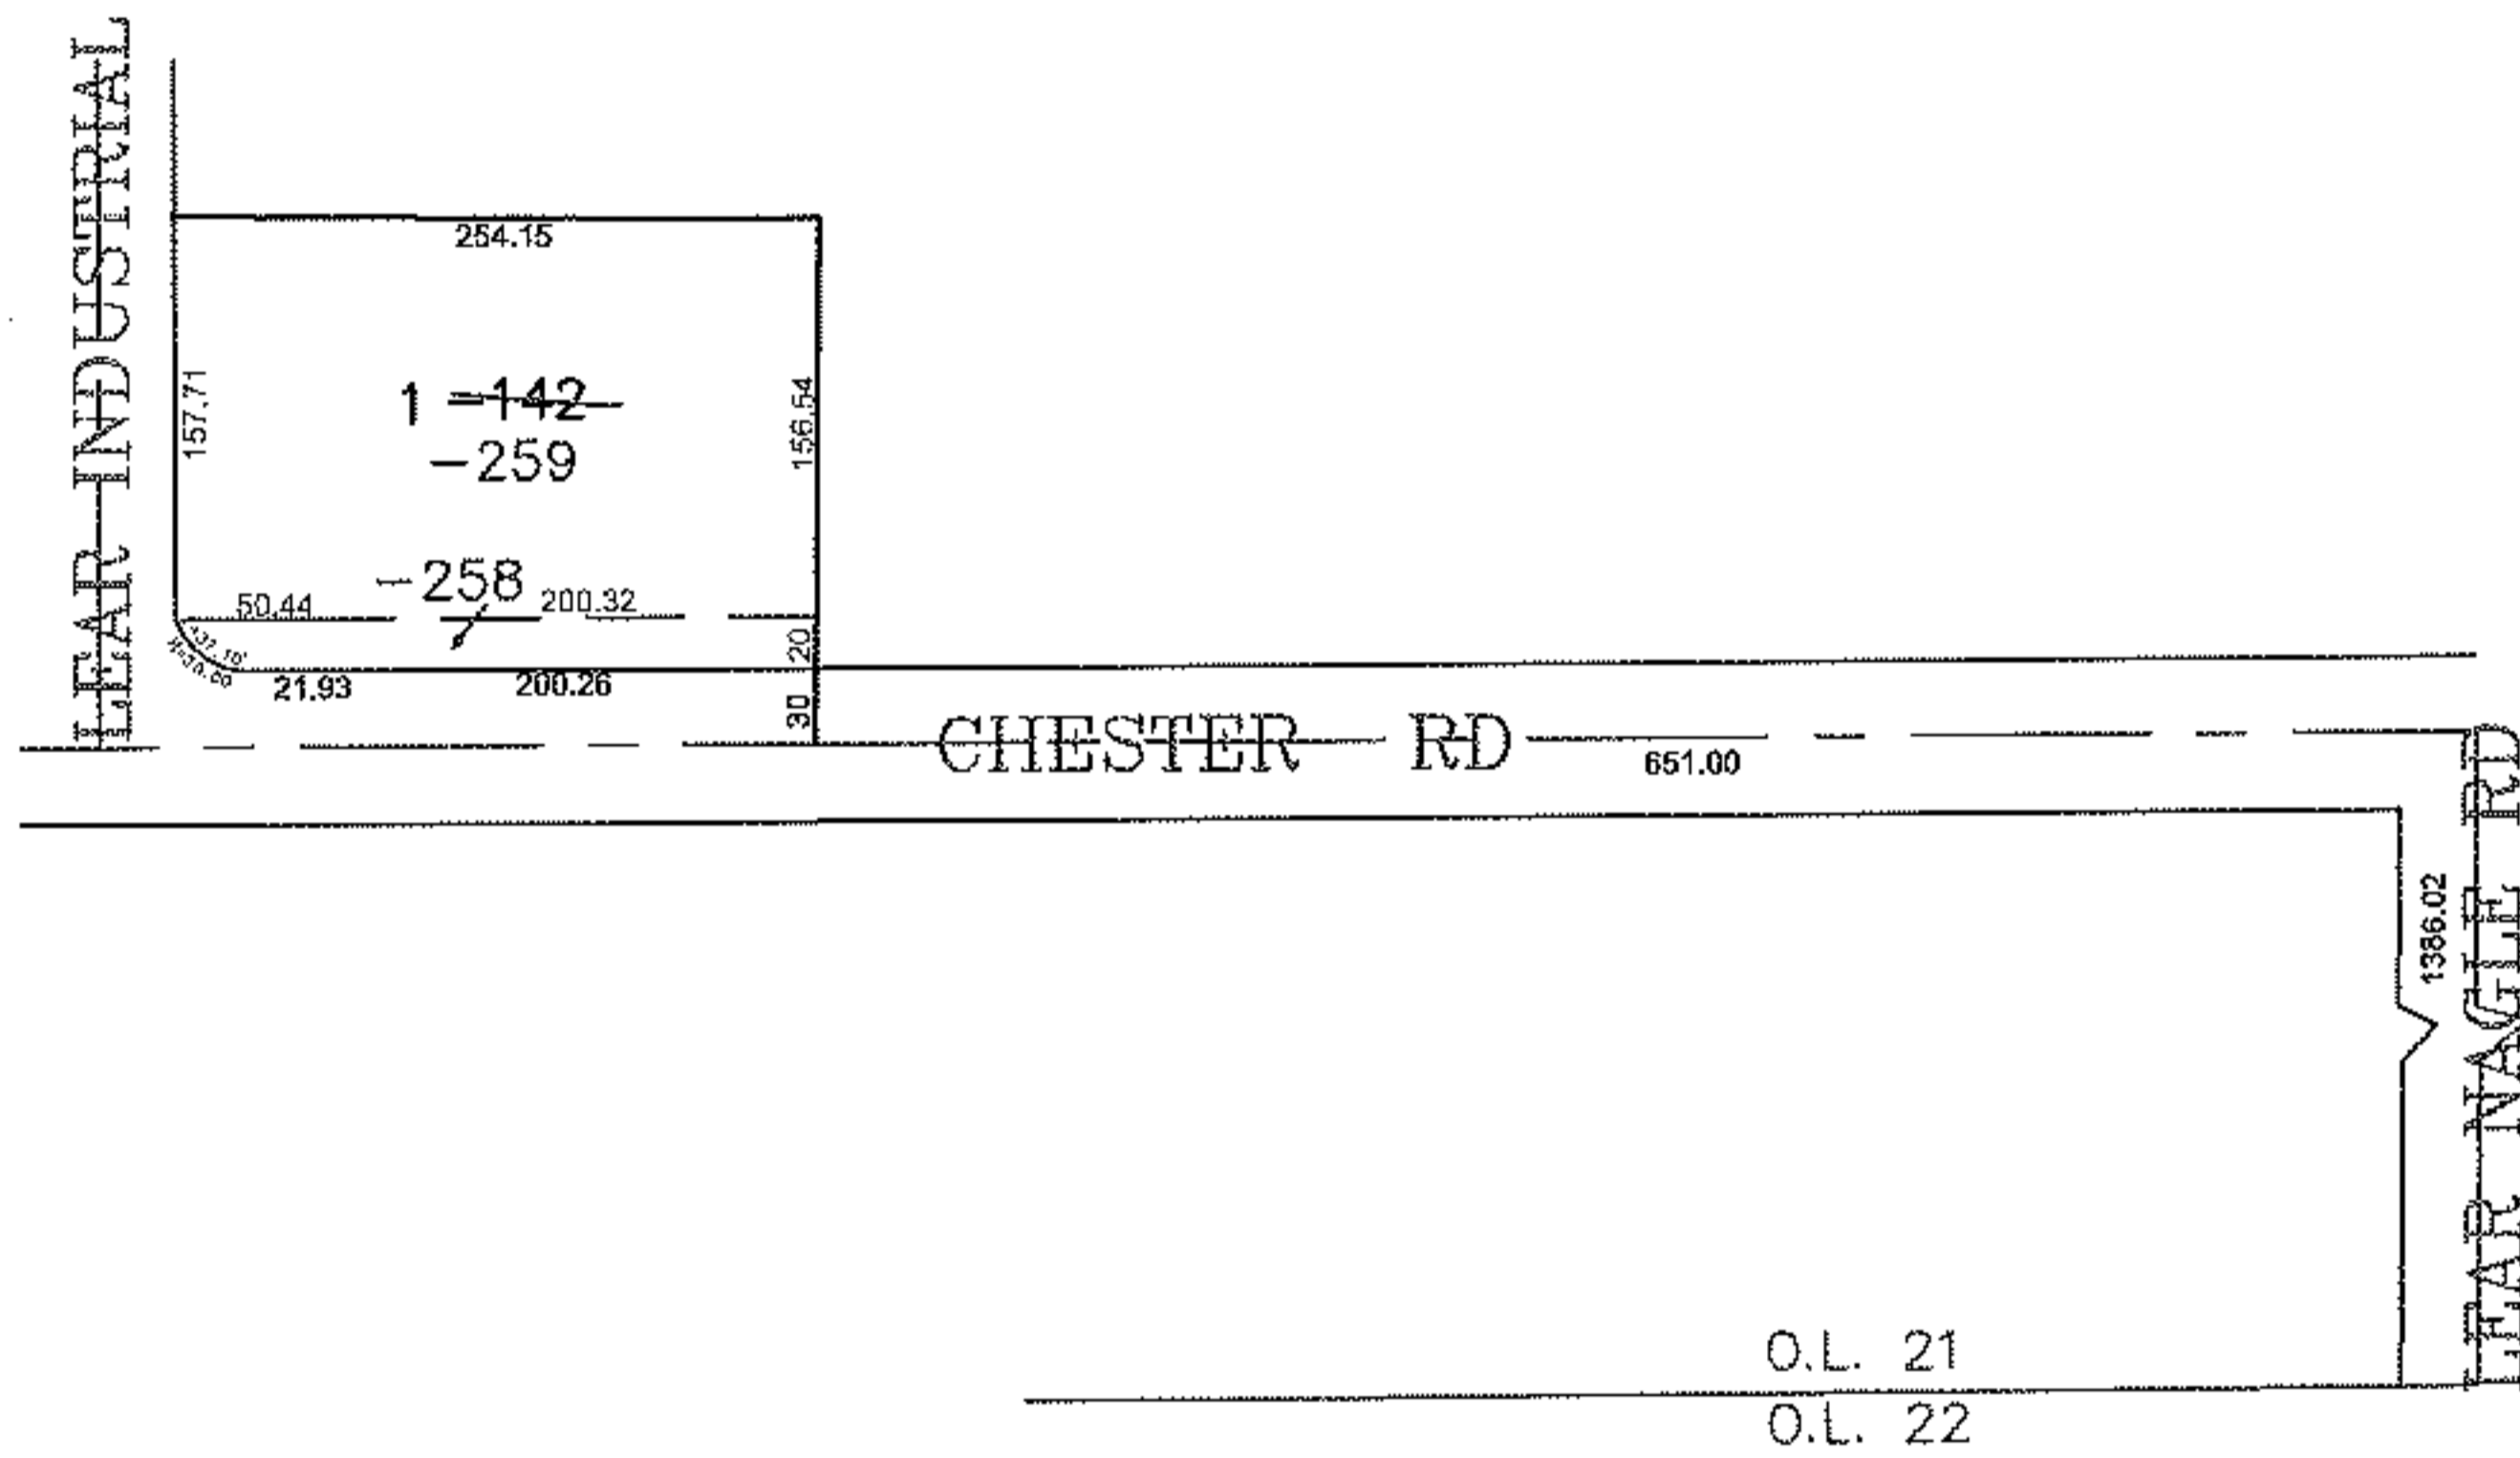


PARENT PARCEL: 04-00-021-000-142

CHILD PARCEL: 04-00-021-000-258, -259

STARTING POINT: CENTERLINE OF LEAR NAGLE RD & O.L. 21

10-00209

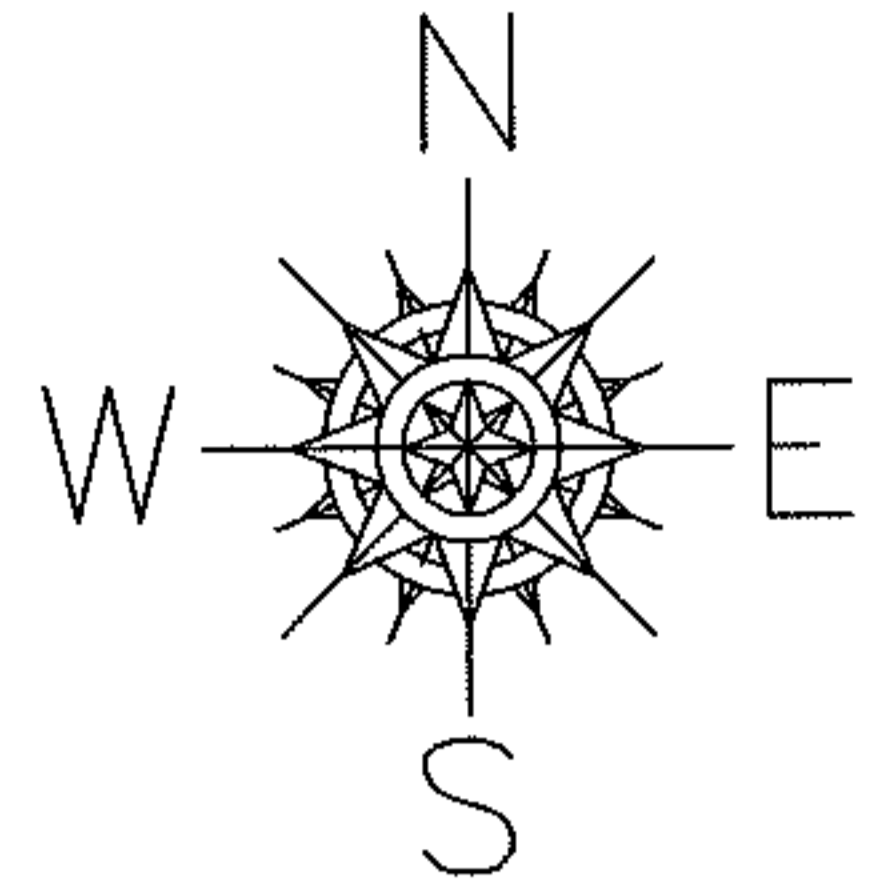

SPLITS/DEEDS PROCESSED
 LORAIN COUNTY TAX MAP DEPARTMENT
 226 MIDDLE AVE. ELYRIA, OHIO

SURVEYED BY: WILLIAM J SALA
 CLOSURE: 0.00 : 10,000
 MAP PAGE(S): 04-00-021-H
 APPROVED BY: JAH DATE: 9-29-2010
 SCALE: 1" = 200' PRIOR INSTRUMENT: 20070217535