
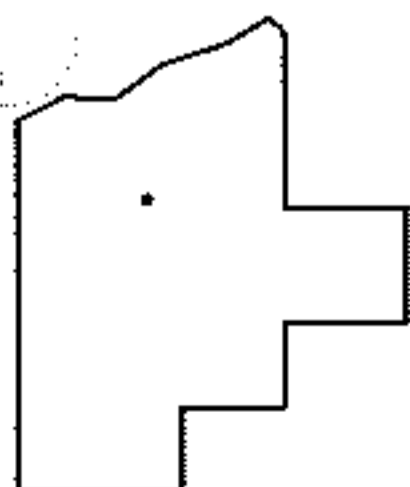
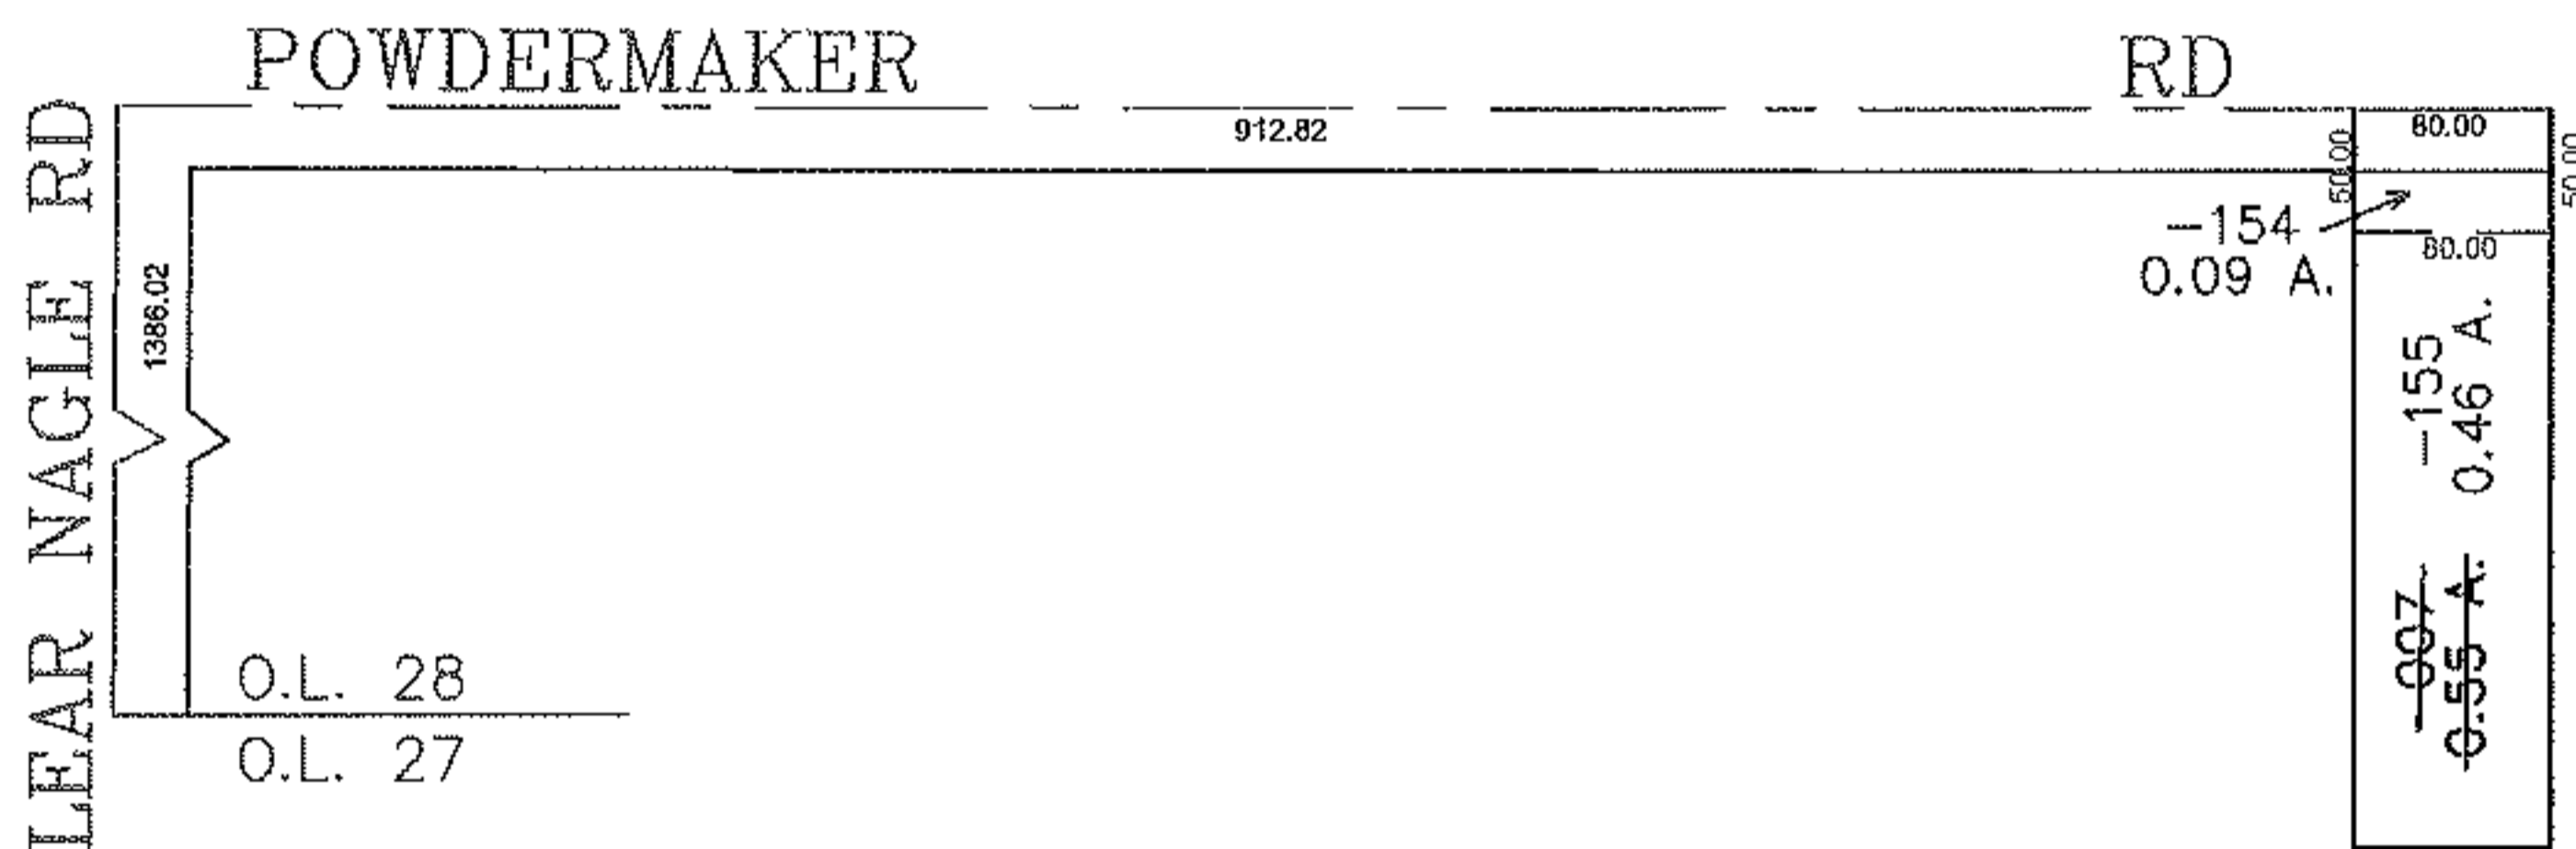


PARENT PARCEL: 04-00-028-102-007

CHILD PARCEL: 04-00-028-102-154, -155

STARTING POINT: CENTERLINE OF O.L. 28 AND LEAR NAGLE RD

10-00210

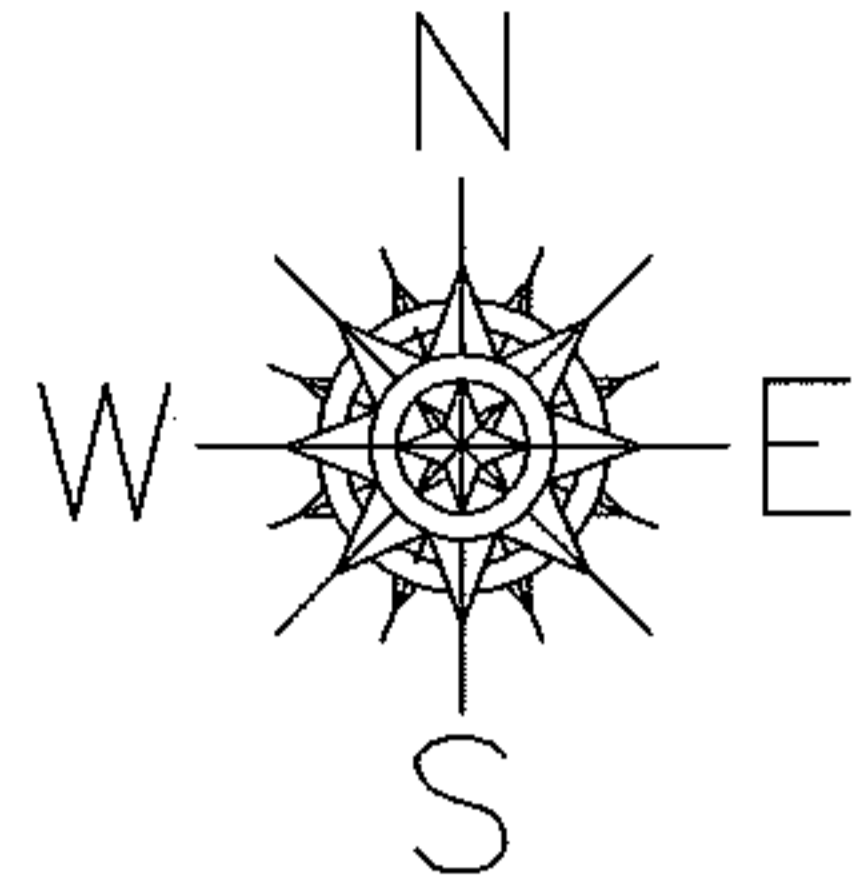

SPLITS/DEEDS PROCESSED

LORAIN COUNTY TAX MAP DEPARTMENT
226 MIDDLE AVE. ELYRIA, OHIO

SURVEYED BY: WILLIAM J SALA
 CLOSURE: 0.00 : 10.000
 MAP PAGE(S): 04-00-028-E
 APPROVED BY: JAH DATE: 9-28-2010
 SCALE: 1" = 200 PRIOR INSTRUMENT: OR 227/667