
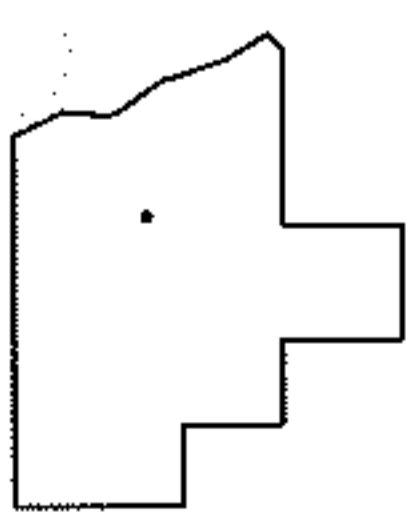
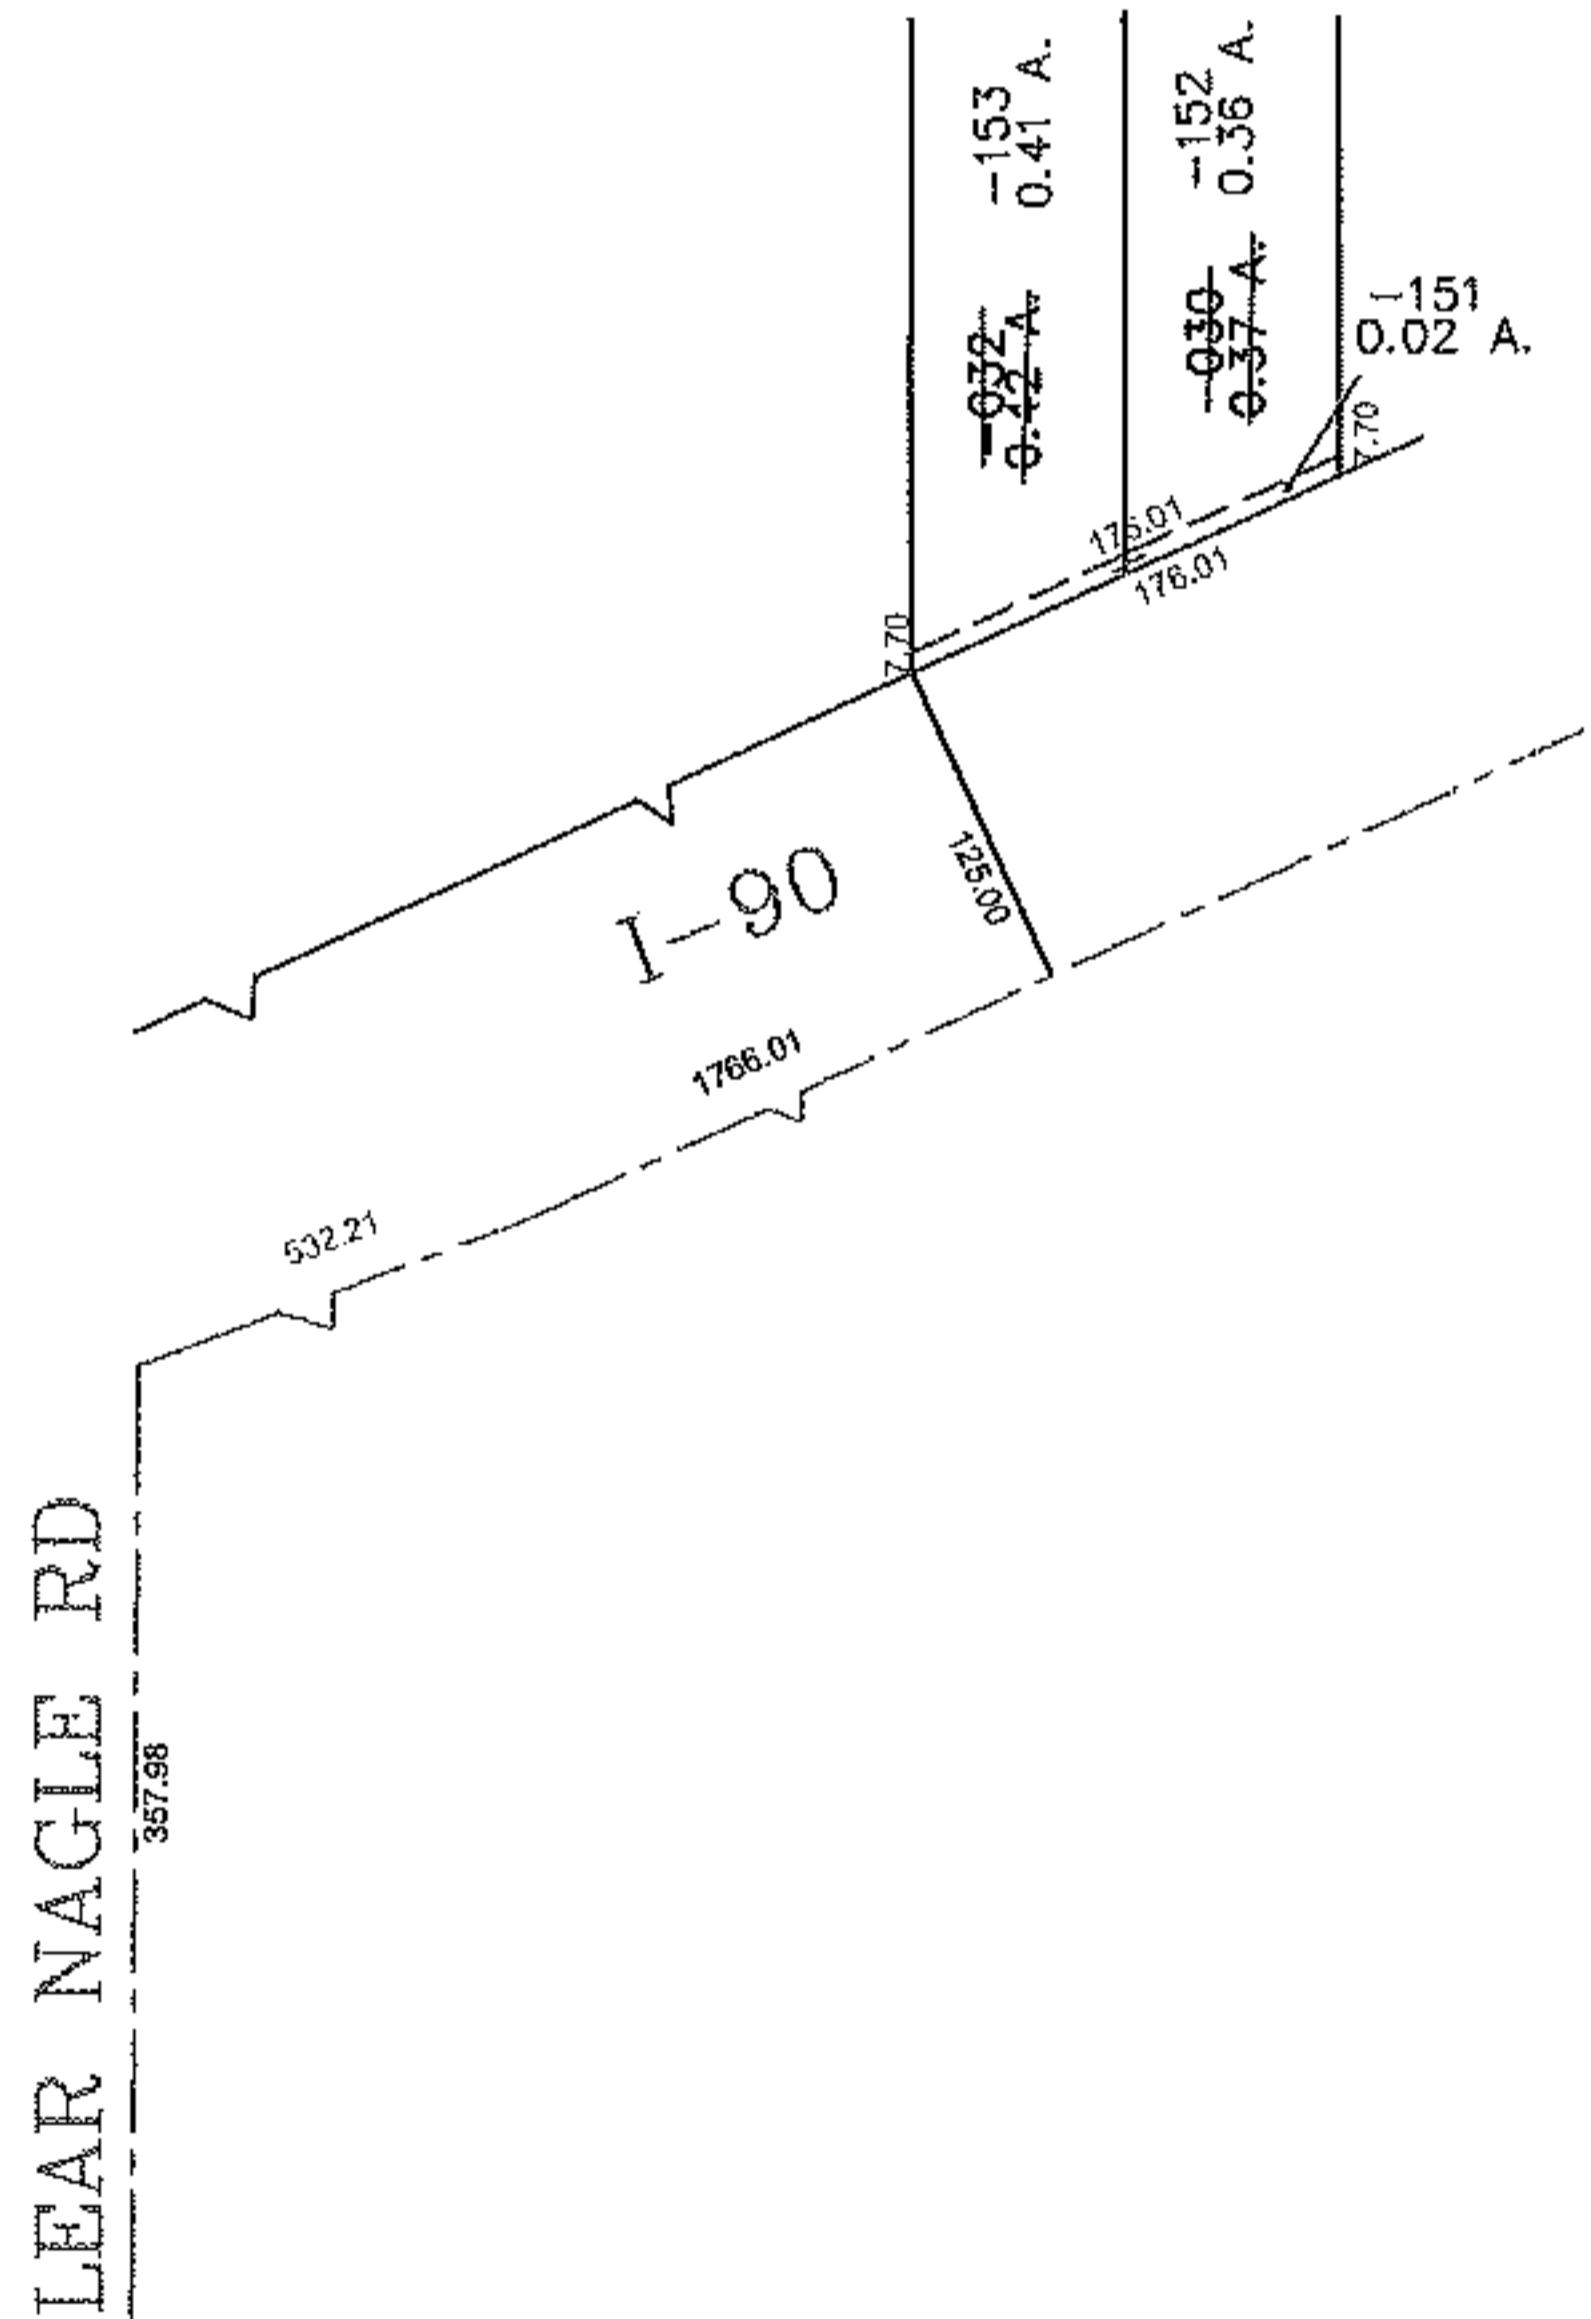


PARENT PARCEL: 04-00-028-102-030, -032  
CHILD PARCEL: 04-00-028-102-151 THRU -153  
STARTING POINT: CENTERLINE OF LEAR NAGLE RD & I-90

10-00211

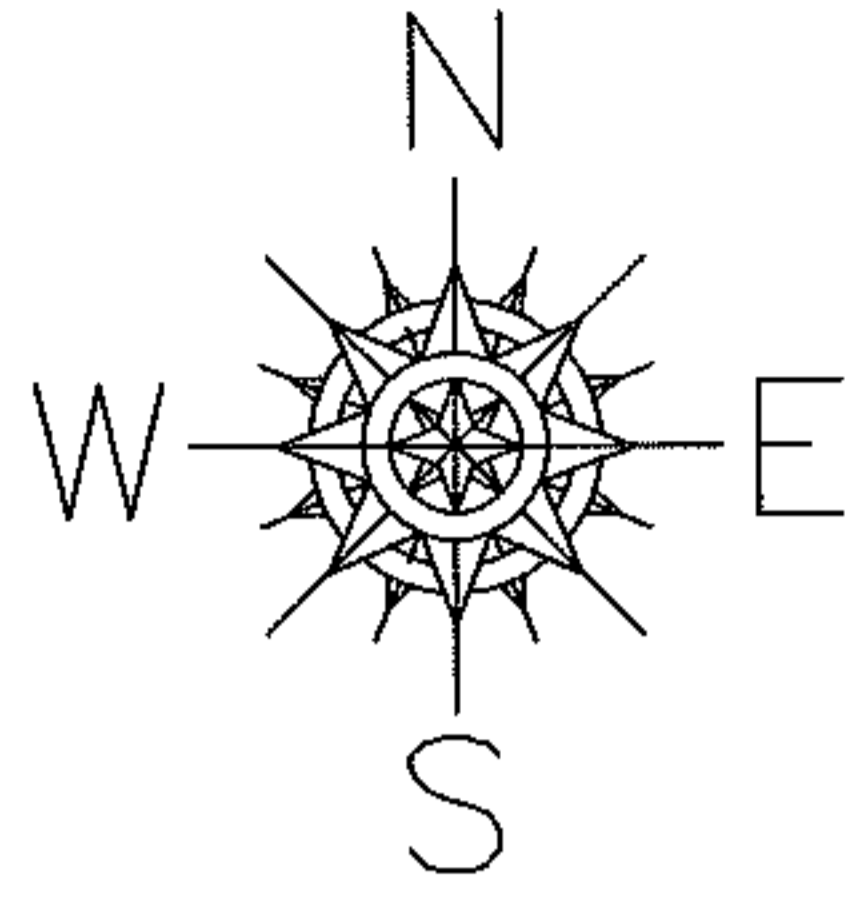

**SPLITS/DEEDS PROCESSED**  
LORAIN COUNTY TAX MAP DEPARTMENT  
226 MIDDLE AVE. ELYRIA, OHIO

SURVEYED BY: WILLIAM J SALA  
CLOSURE: 0.00 : 10,000  
MAP PAGE(S): 04-00-028-E  
APPROVED BY: JAH DATE: 9-28-2010  
SCALE: 1" = 200 PRIOR INSTRUMENT: 20050058504