
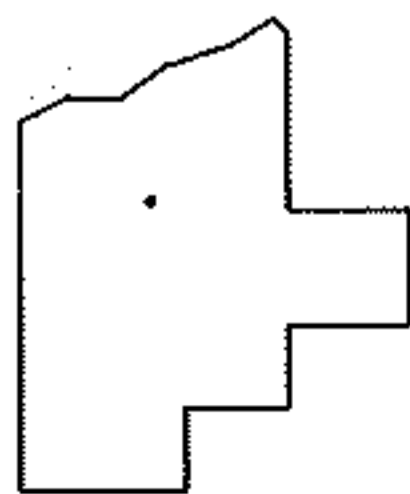
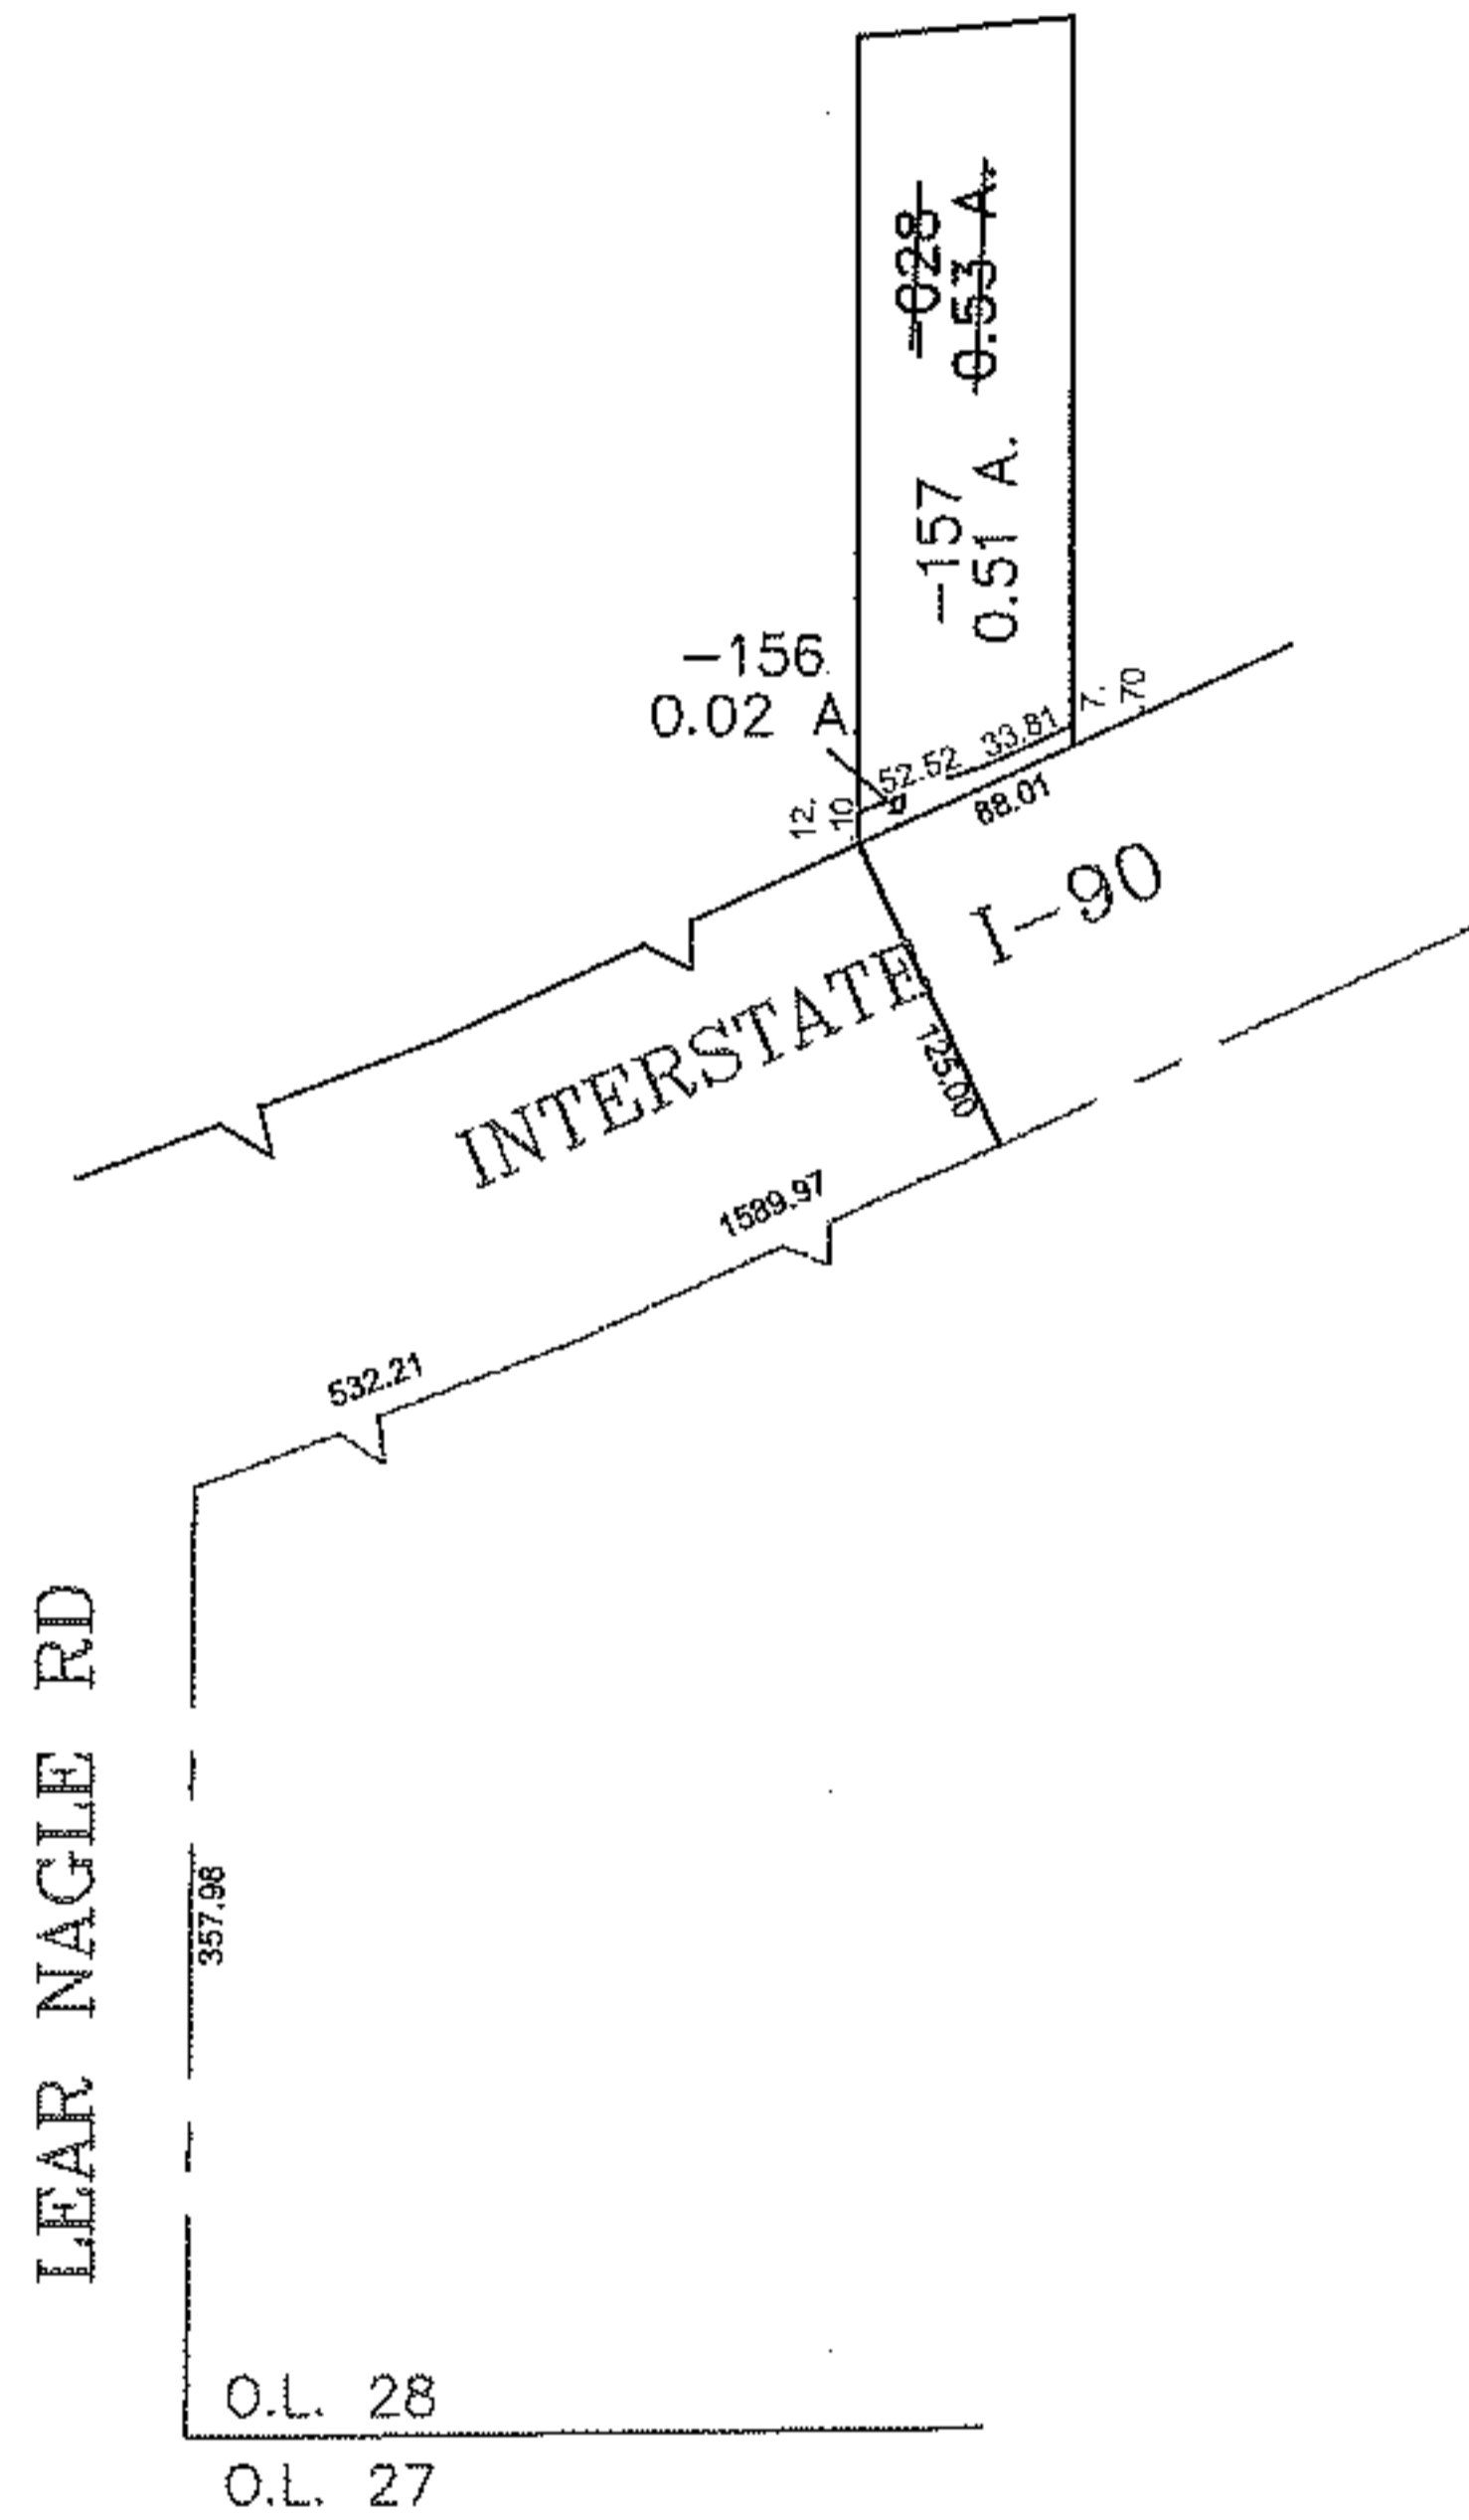


PARENT PARCEL: 04-00-028-102-028

CHILD PARCEL: 04-00-028-102-156, -157

STARTING POINT: CENTERLINE OF LEAR NAGLE RD & O.L. 28

10-00212

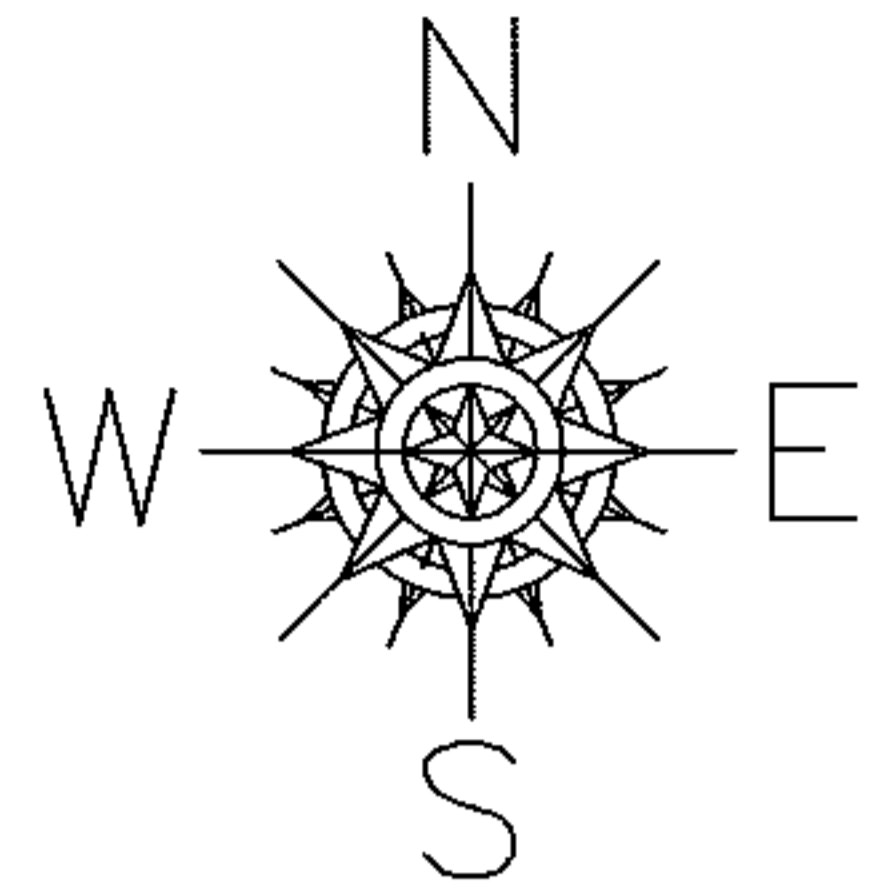

**SPLITS/DEEDS PROCESSED**  
 LORAIN COUNTY TAX MAP DEPARTMENT  
 226 MIDDLE AVE. ELYRIA, OHIO

SURVEYED BY: WILLIAM J SALA  
 CLOSURE: 0.00 : 10,000  
 MAP PAGE(S): 04-00-028-E  
 APPROVED BY: JAH DATE: 10-4-2010  
 SCALE: 1" = 200 PRIOR INSTRUMENT: 20080253086