
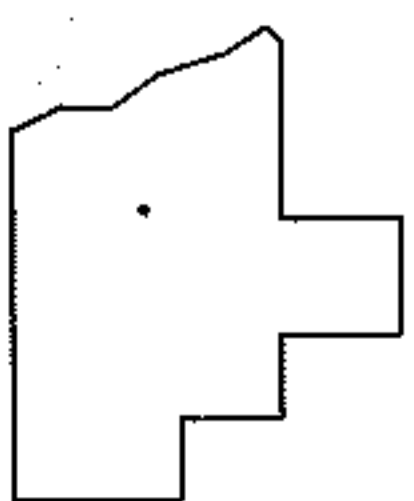
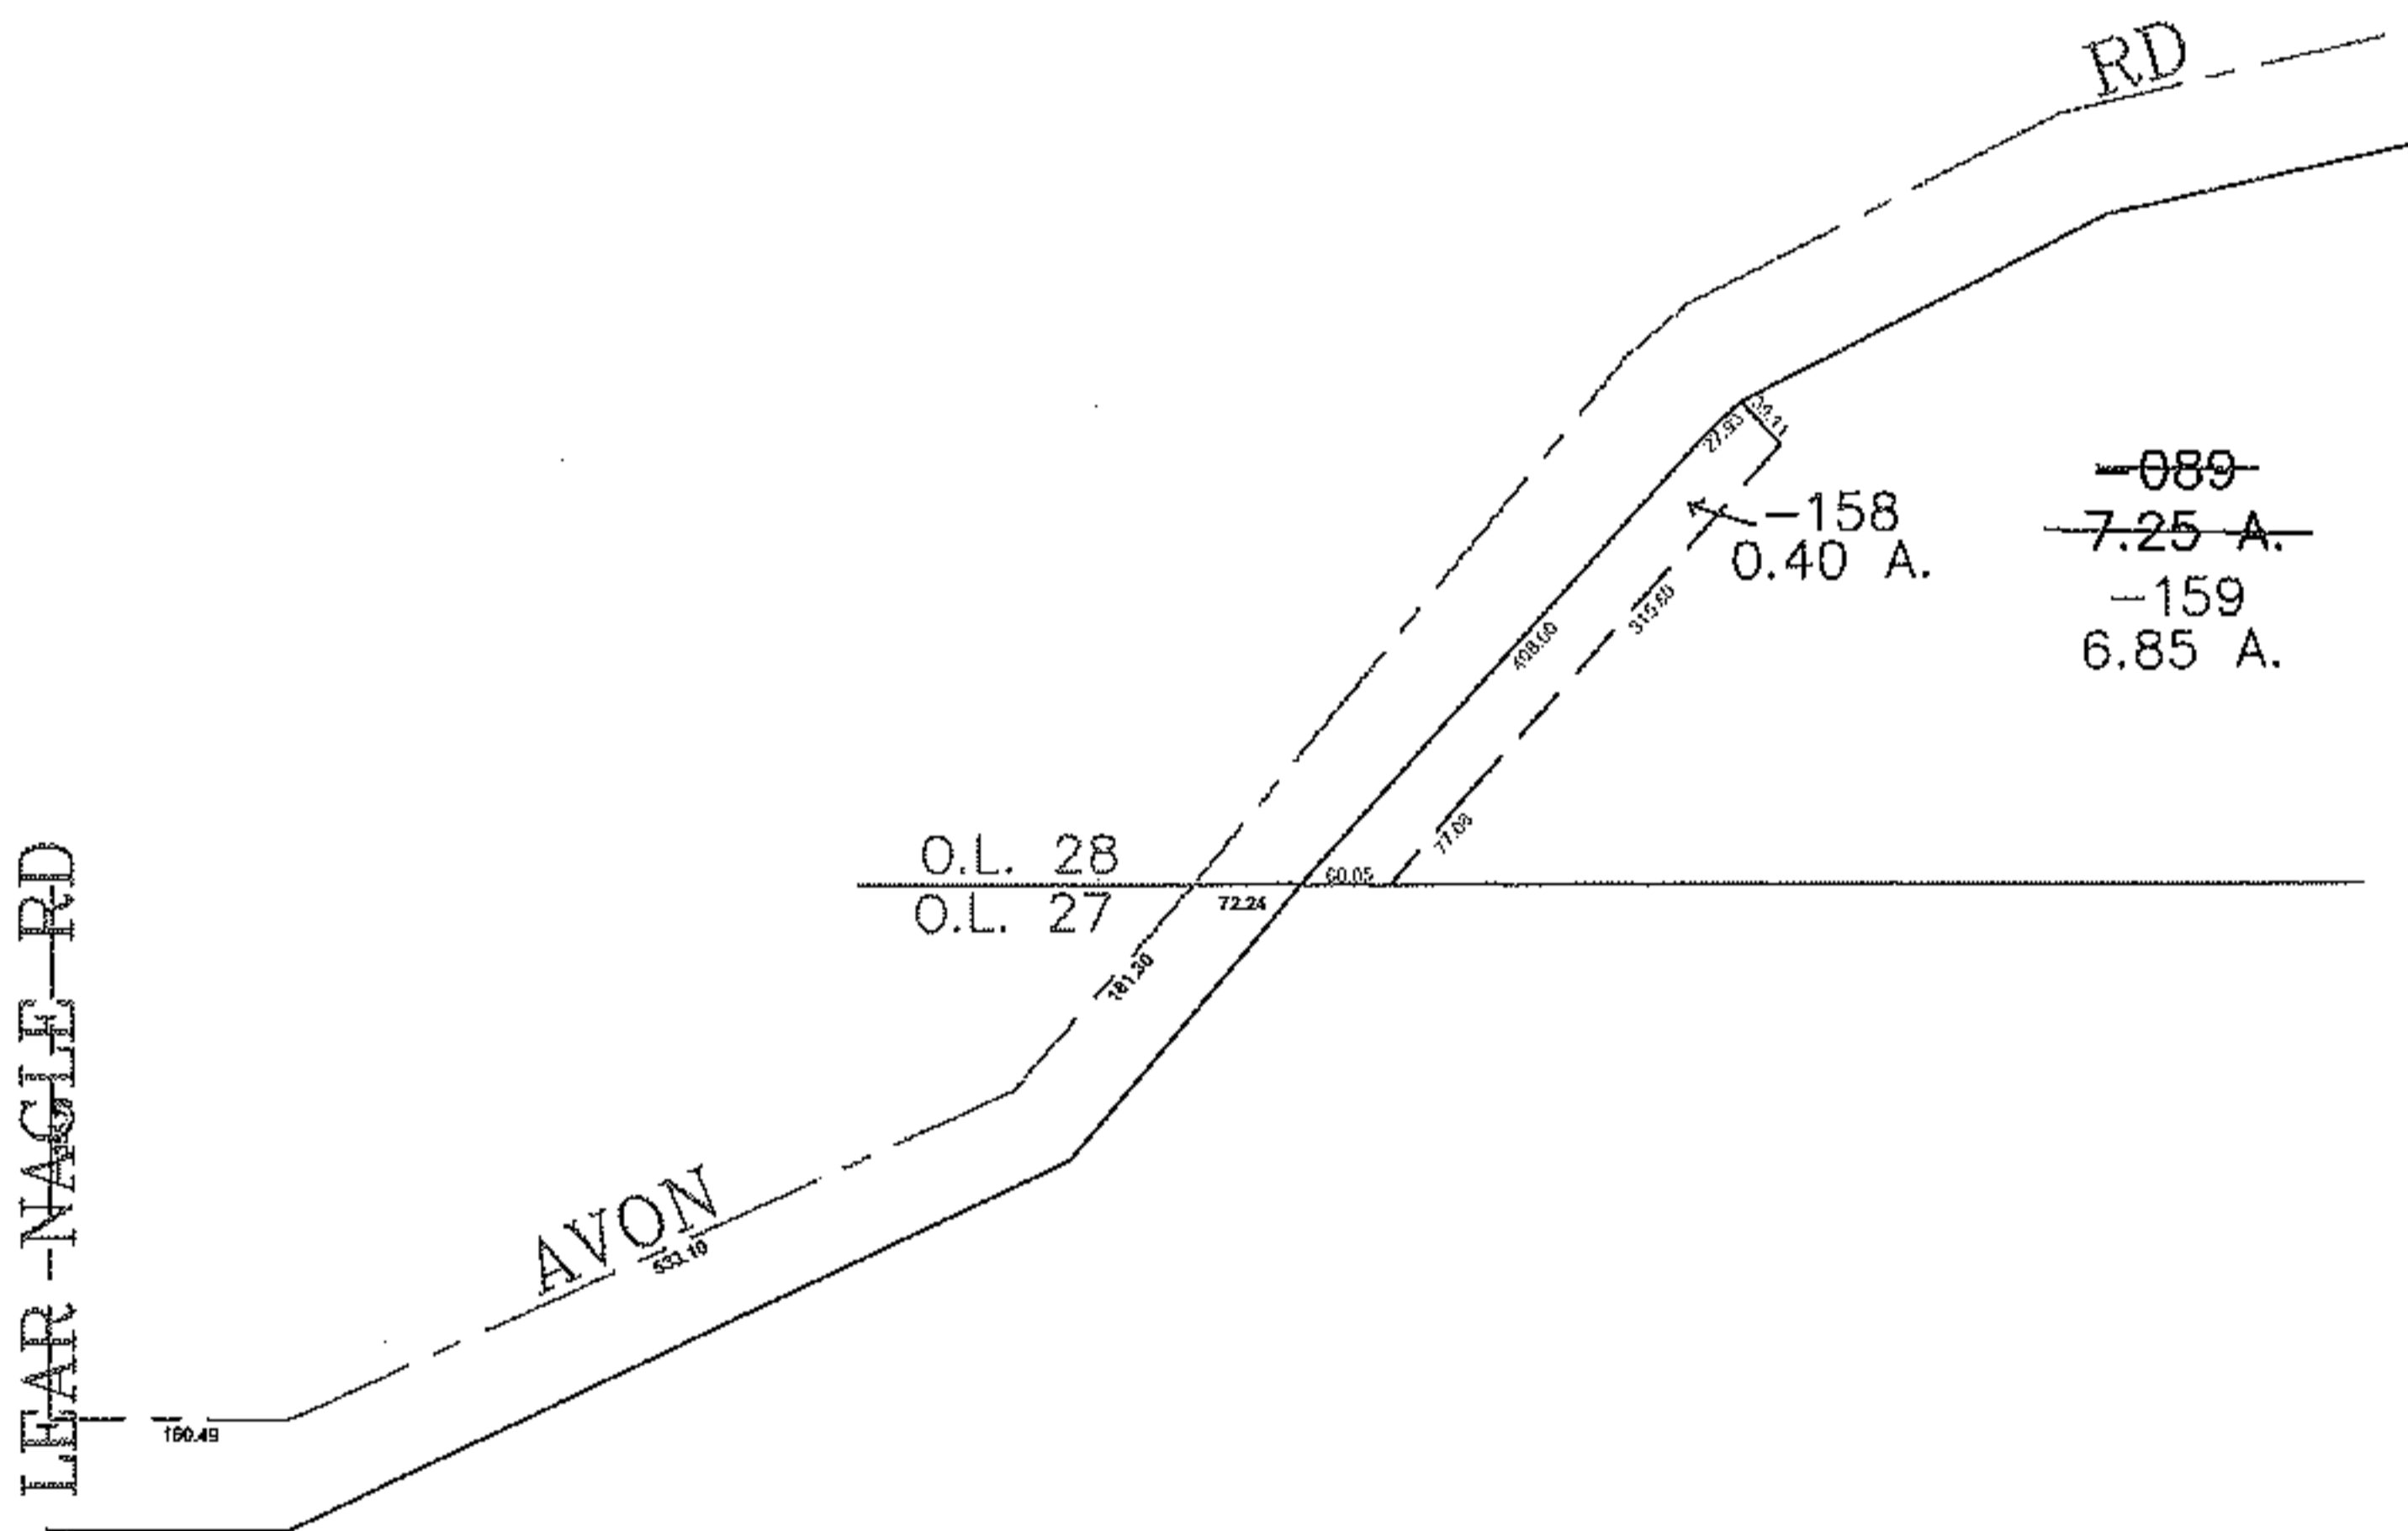


PARENT PARCEL: 04-00-028-102-089

CHILD PARCEL: 04-00-028-102-158, -159

STARTING POINT: CENTERLINE OF LEAR NAGLE RD. & O.L. 27

10-00213

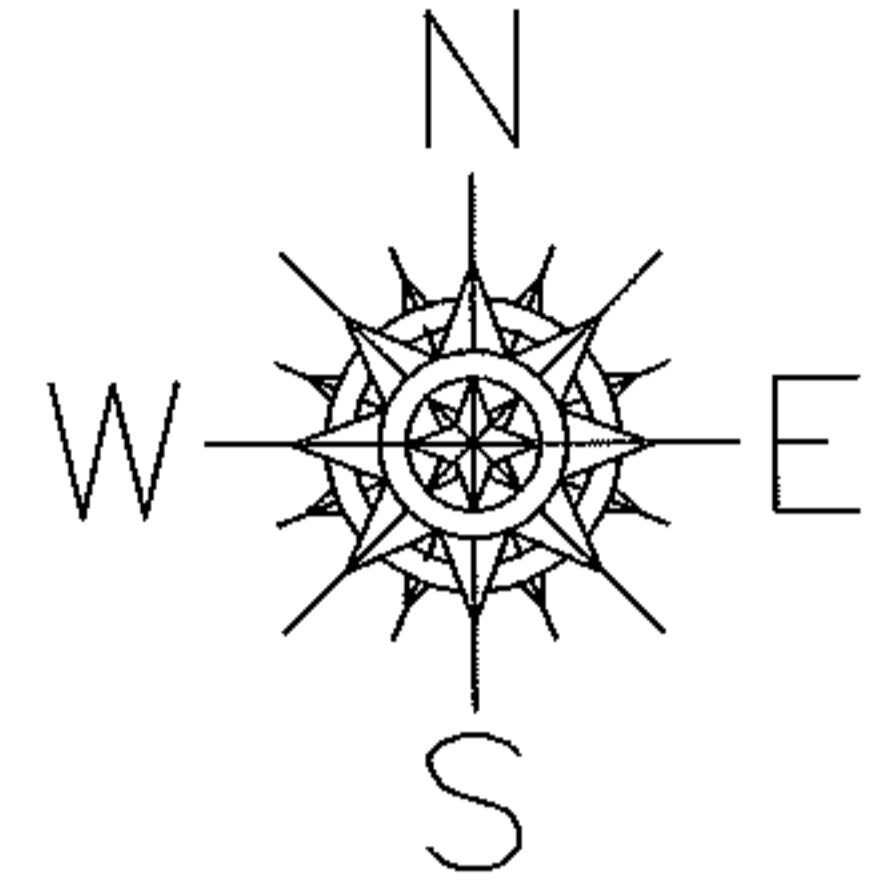

SPLITS/DEEDS PROCESSED
LORAIN COUNTY TAX MAP DEPARTMENT
226 MIDDLE AVE. ELYRIA, OHIO

SURVEYED BY: WILLIAM J SALA
CLOSURE: 0.00 : 10.000
MAP PAGE(S): 04-00-028-E
APPROVED BY: JAH DATE: 10-5-2010
SCALE: 1" = 300' PRIOR INSTRUMENT: 19980560129