
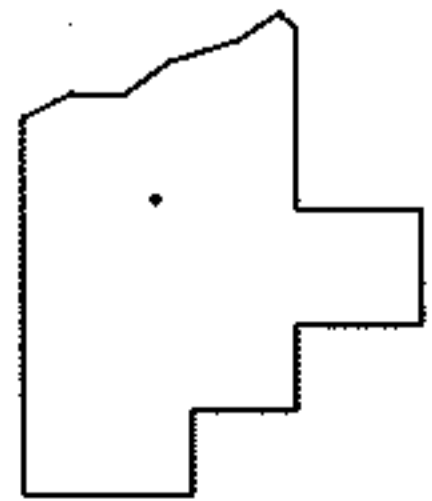


PARENT PARCEL: 04-00-028-101-090

CHILD PARCEL: 04-00-028-101-096, -097

10-00214

STARTING POINT: SOUTHWEST CORNER OF SEC. 28

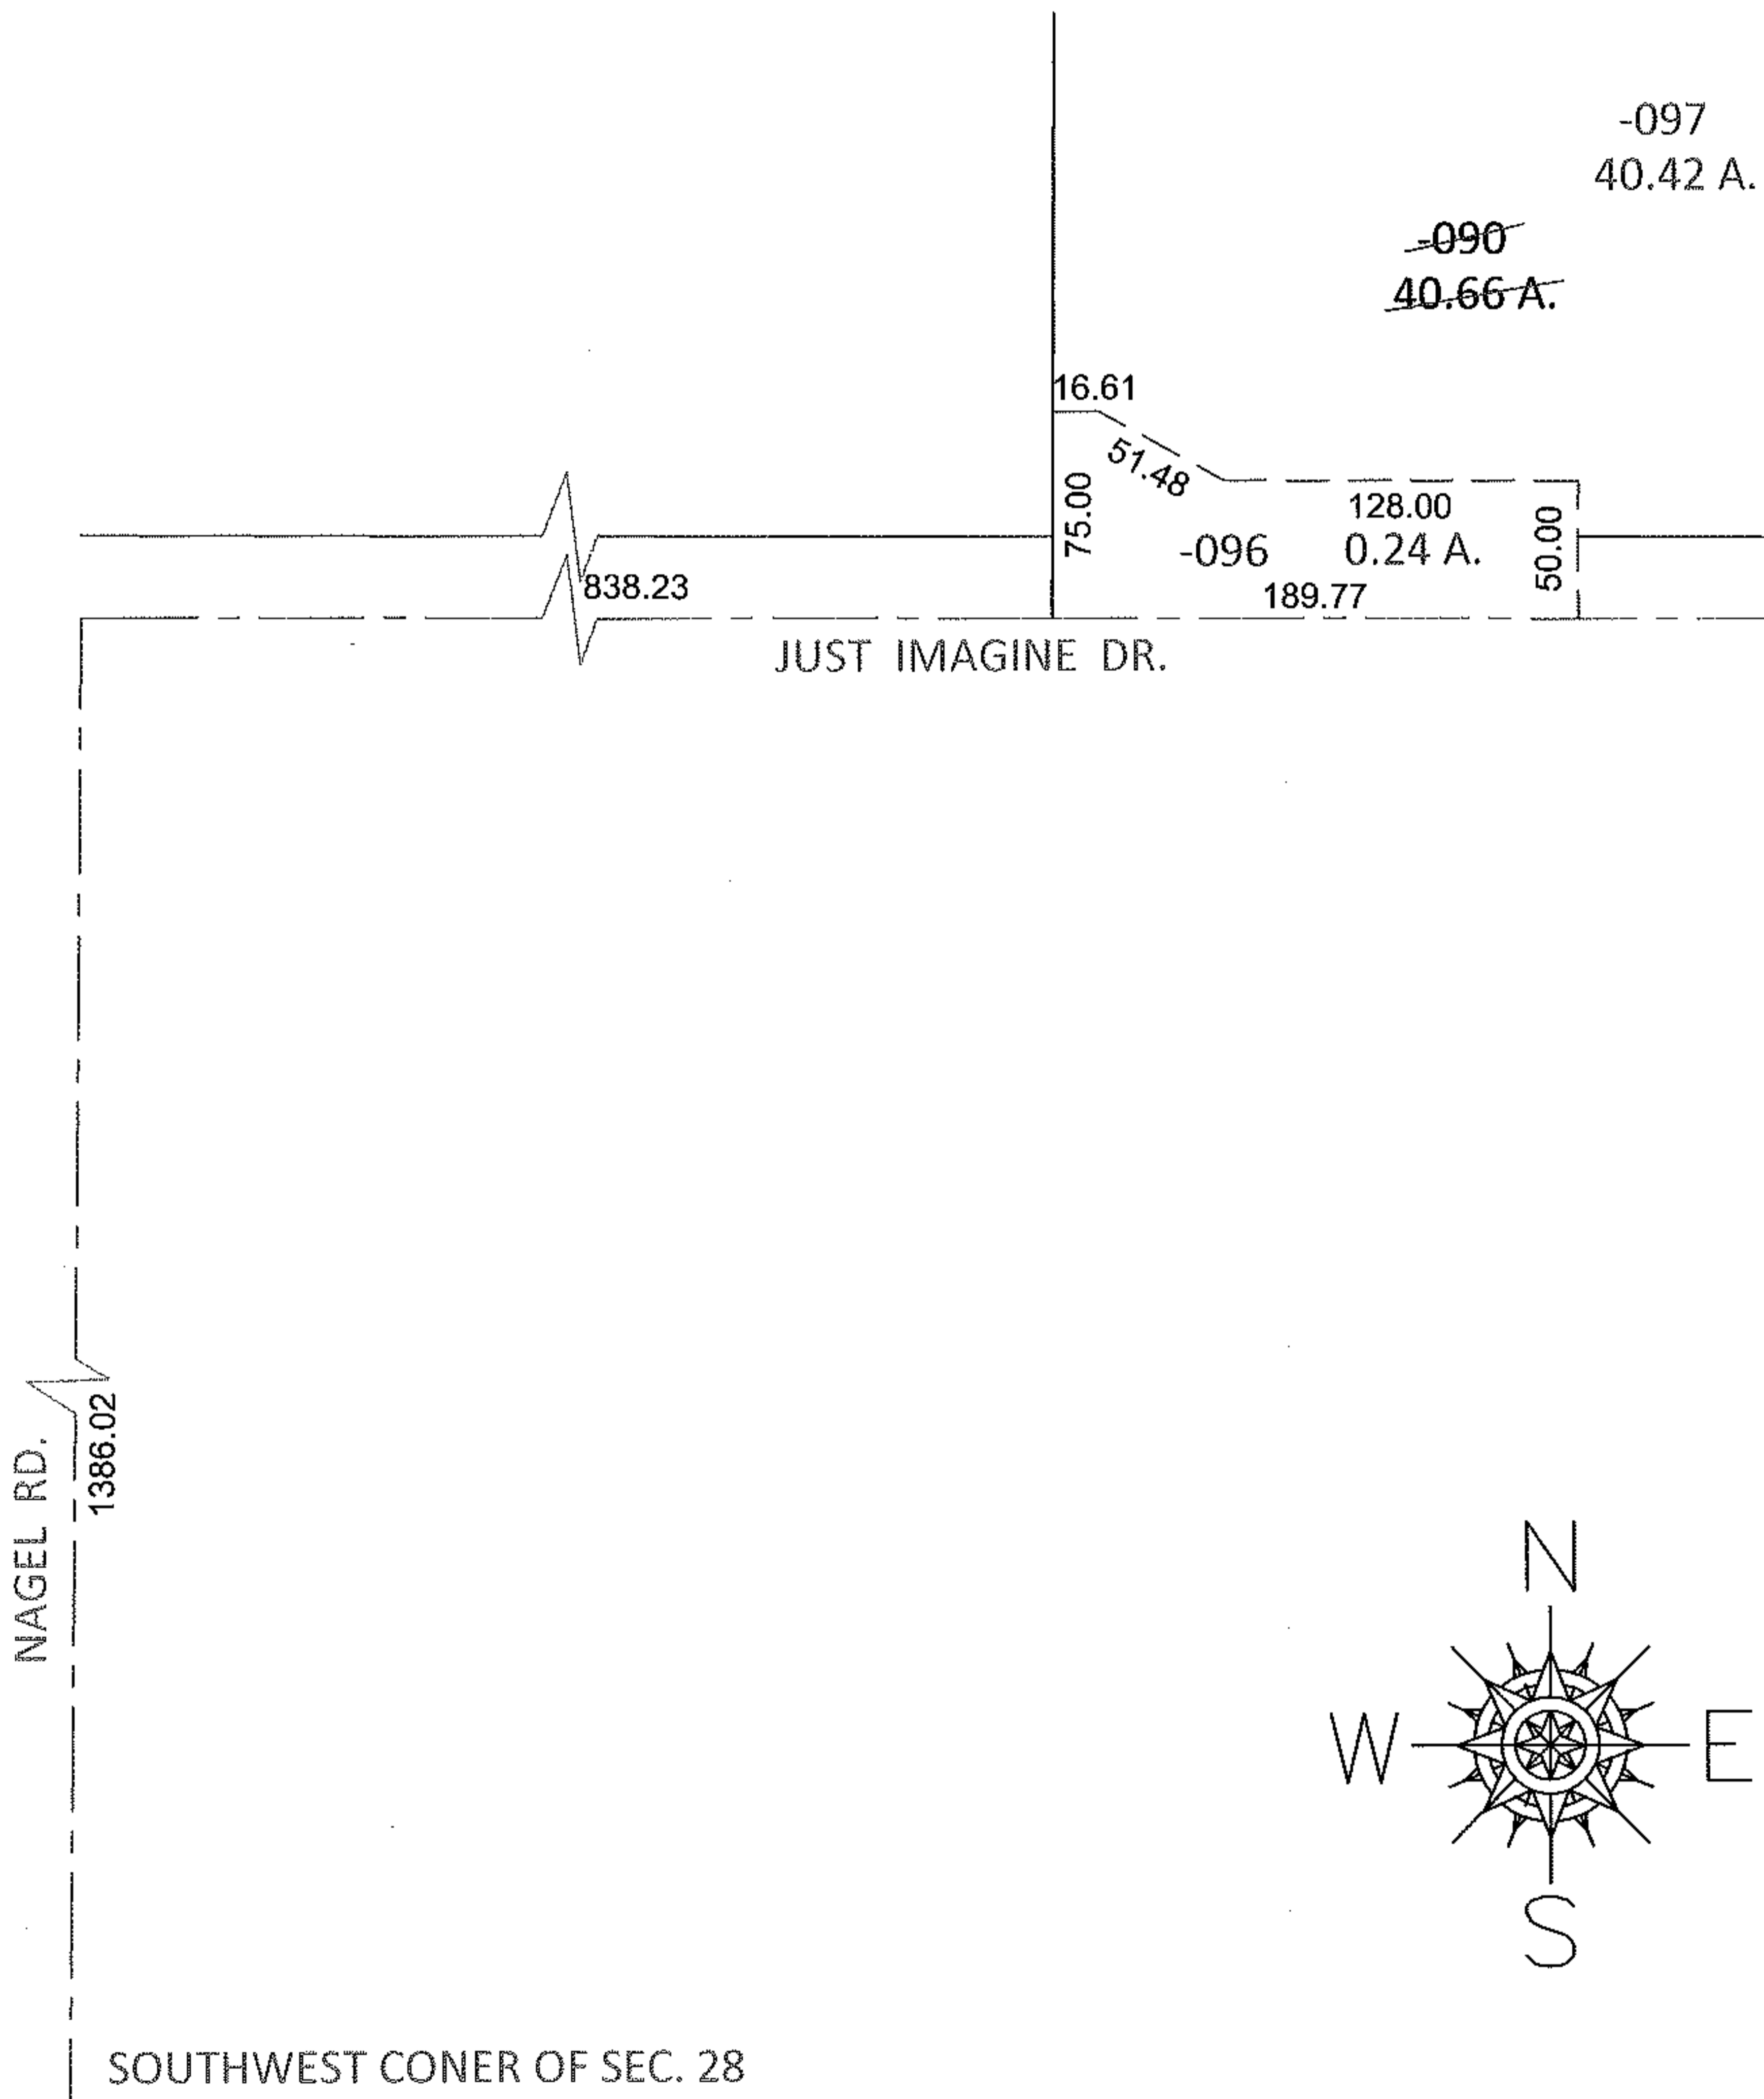

**SPLITS/DEEDS PROCESSED**

LORAIN COUNTY TAX MAP DEPARTMENT  
226 MIDDLE AVE. ELYRIA, OHIO

SURVEYED BY: WILLIAM J. SALA

CLOSURE: .01:10,000

MAP PAGE(S): 4-00-028-E & F

APPROVED BY: RRM DATE: 11-16-10

SCALE: 1"= 100 PRIOR INST.: 20080241560