
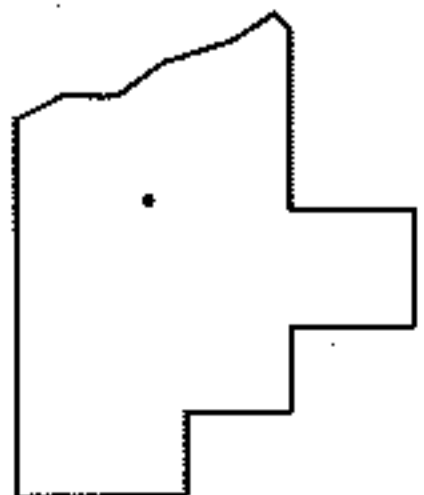
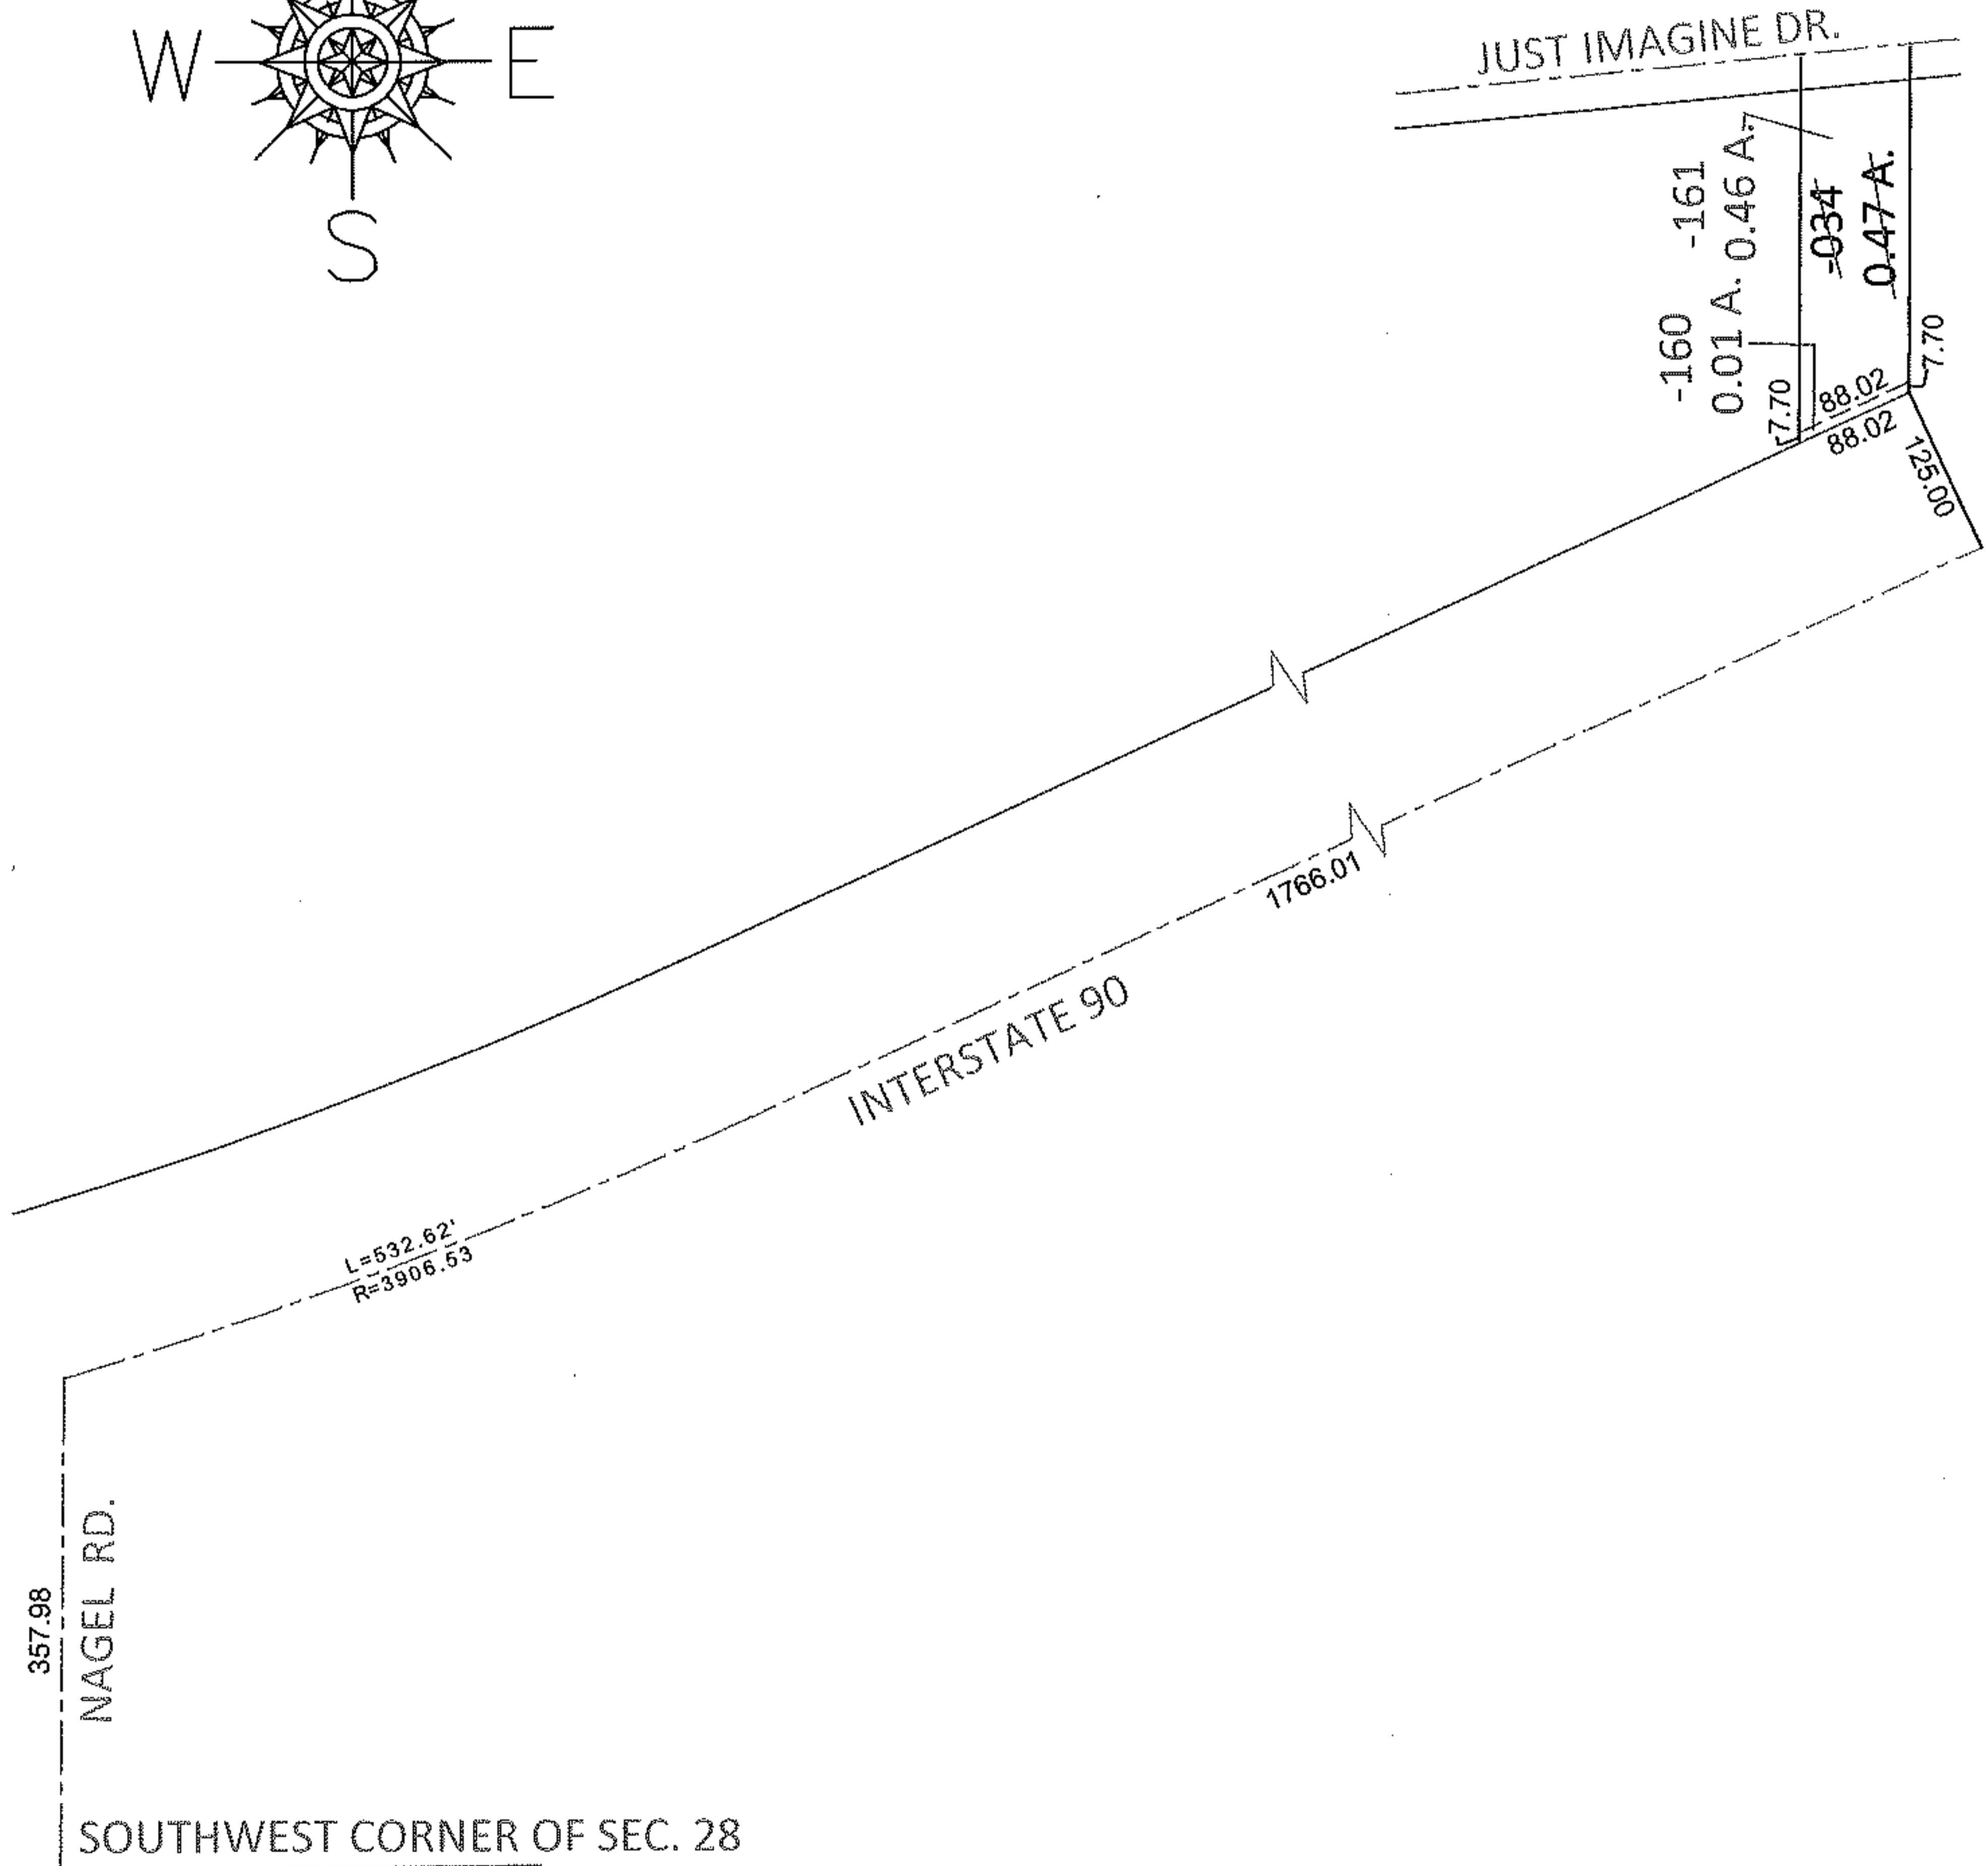


PARENT PARCEL: 04-00-028-102-034

CHILD PARCEL: 04-00-028-102-160, -161

10-00215

STARTING POINT: SOUTHWEST CORNER OF SEC. 28

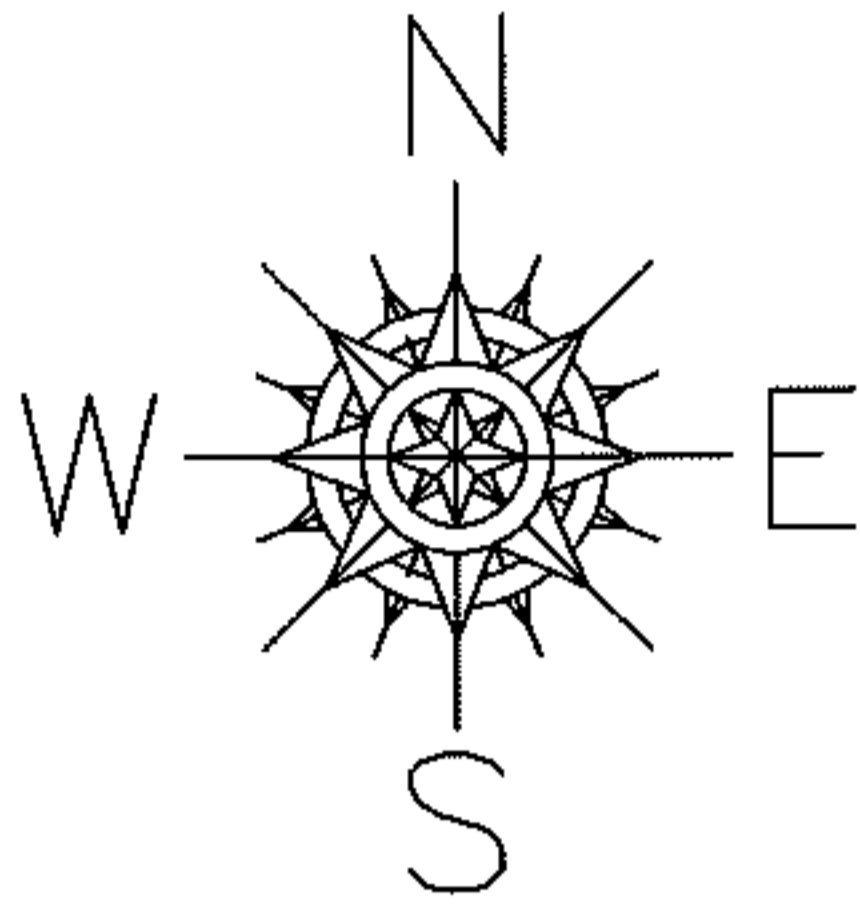

SPLITS/DEEDS PROCESSED

LORAIN COUNTY TAX MAP DEPARTMENT
226 MIDDLE AVE. ELYRIA, OHIO

SURVEYED BY: WILLIAM J. SALA

CLOSURE: .00:10,000

MAP PAGE(S): 4-00-028-E

APPROVED BY: RRM DATE: 11-16-10

SCALE: 1" = 200 PRIOR INST.: OR 758/760