
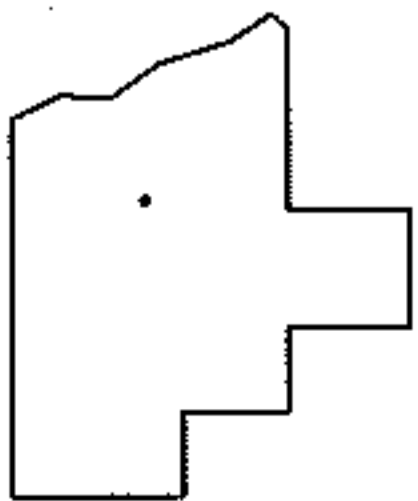
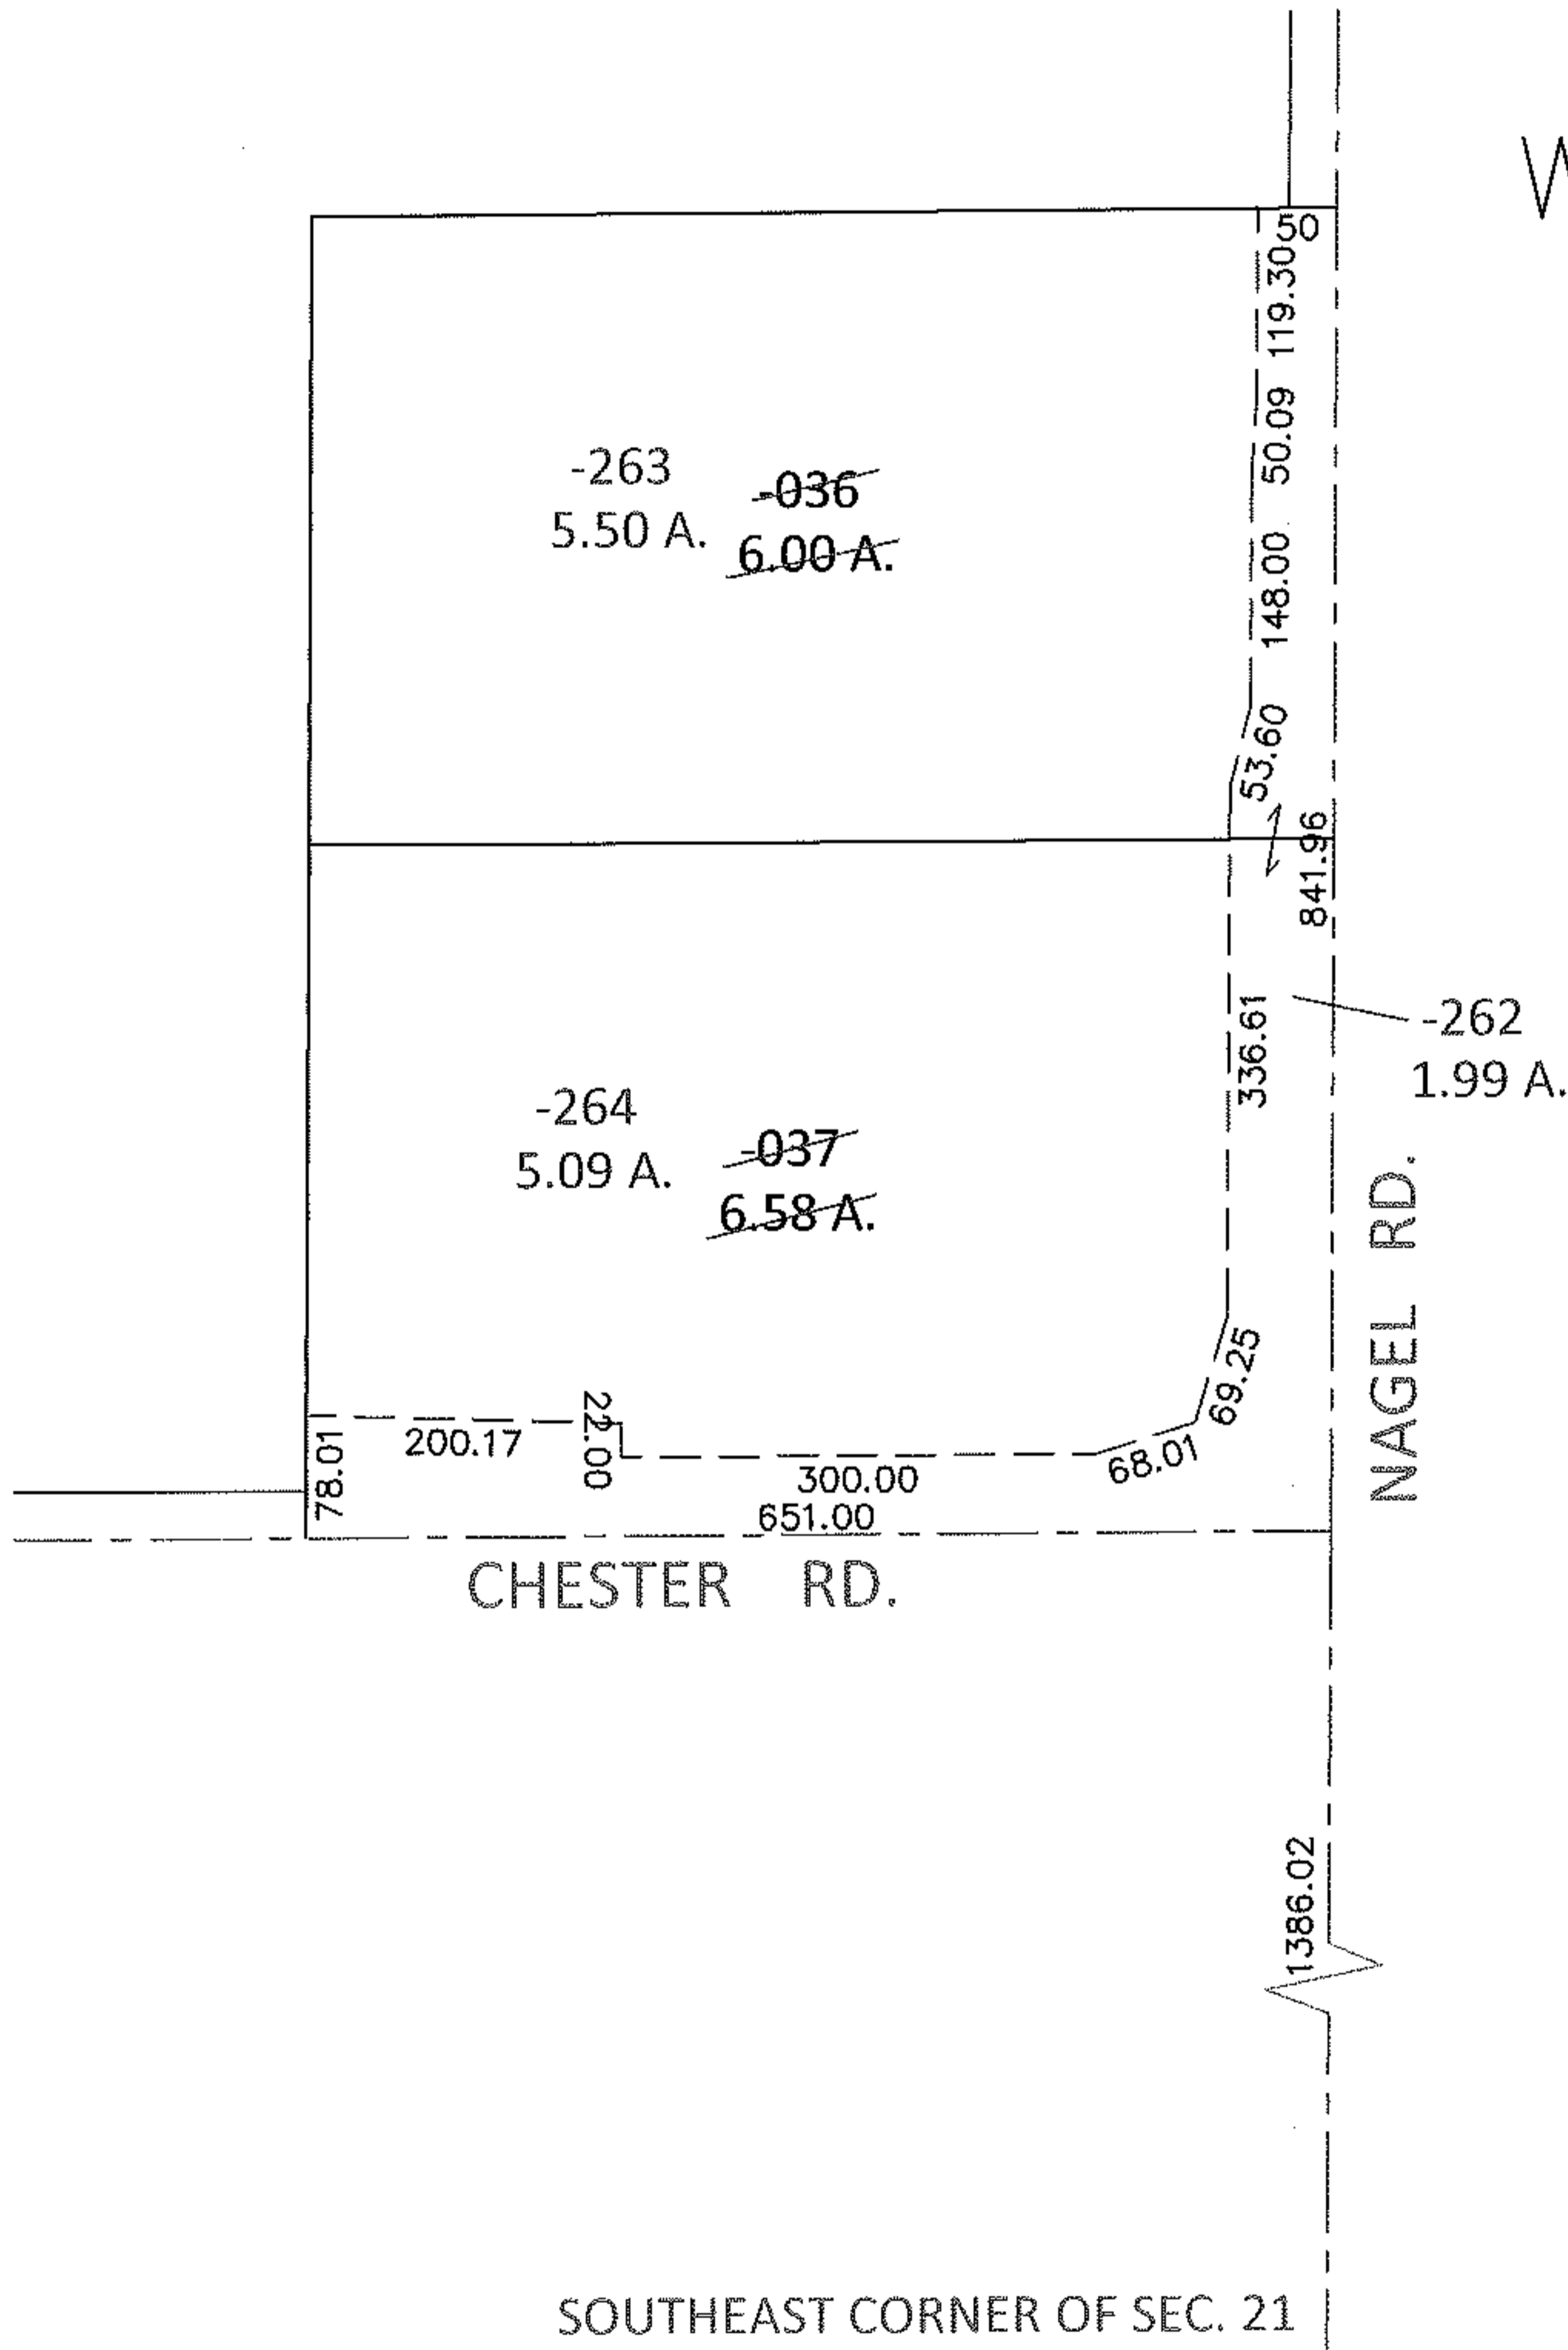


PARENT PARCEL: 04-00-021-000-036, -037

CHILD PARCEL: 04-00-021-000-262 THRU -264

STARTING POINT: SOUTHEAST CORNER OF SEC. 21

10-00216

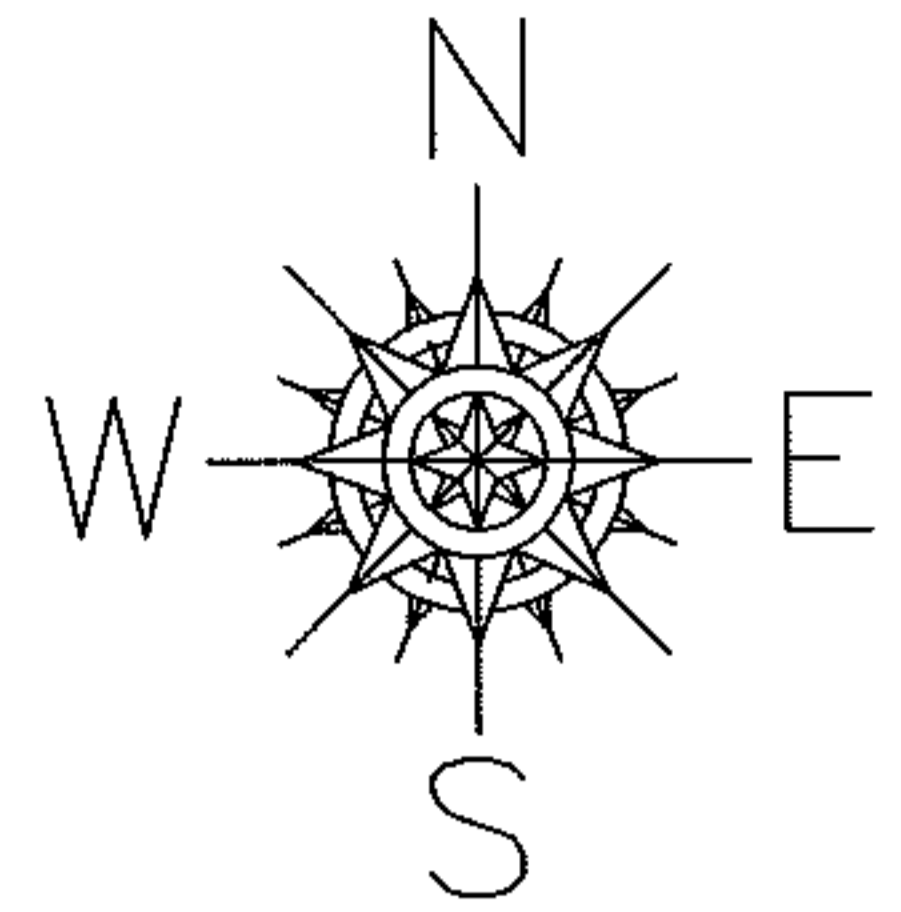

SPLITS/DEEDS PROCESSED

LORAIN COUNTY TAX MAP DEPARTMENT
226 MIDDLE AVE. ELYRIA, OHIO

SURVEYED BY: WILLIAM J. SALA

CLOSURE: .01:10,000

MAP PAGE(S): 4-00-021-H

APPROVED BY: RRM DATE: 11-17-10

SCALE: 1" = 200 PRIOR INST.: OR 746/627