
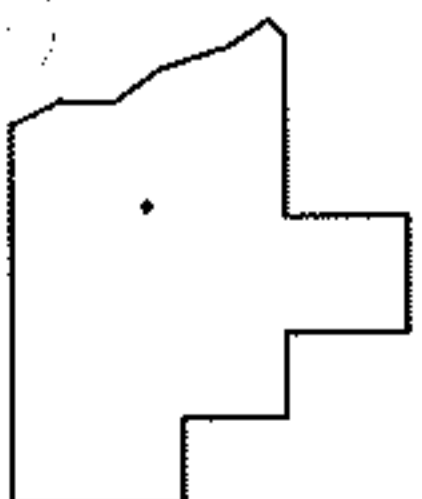
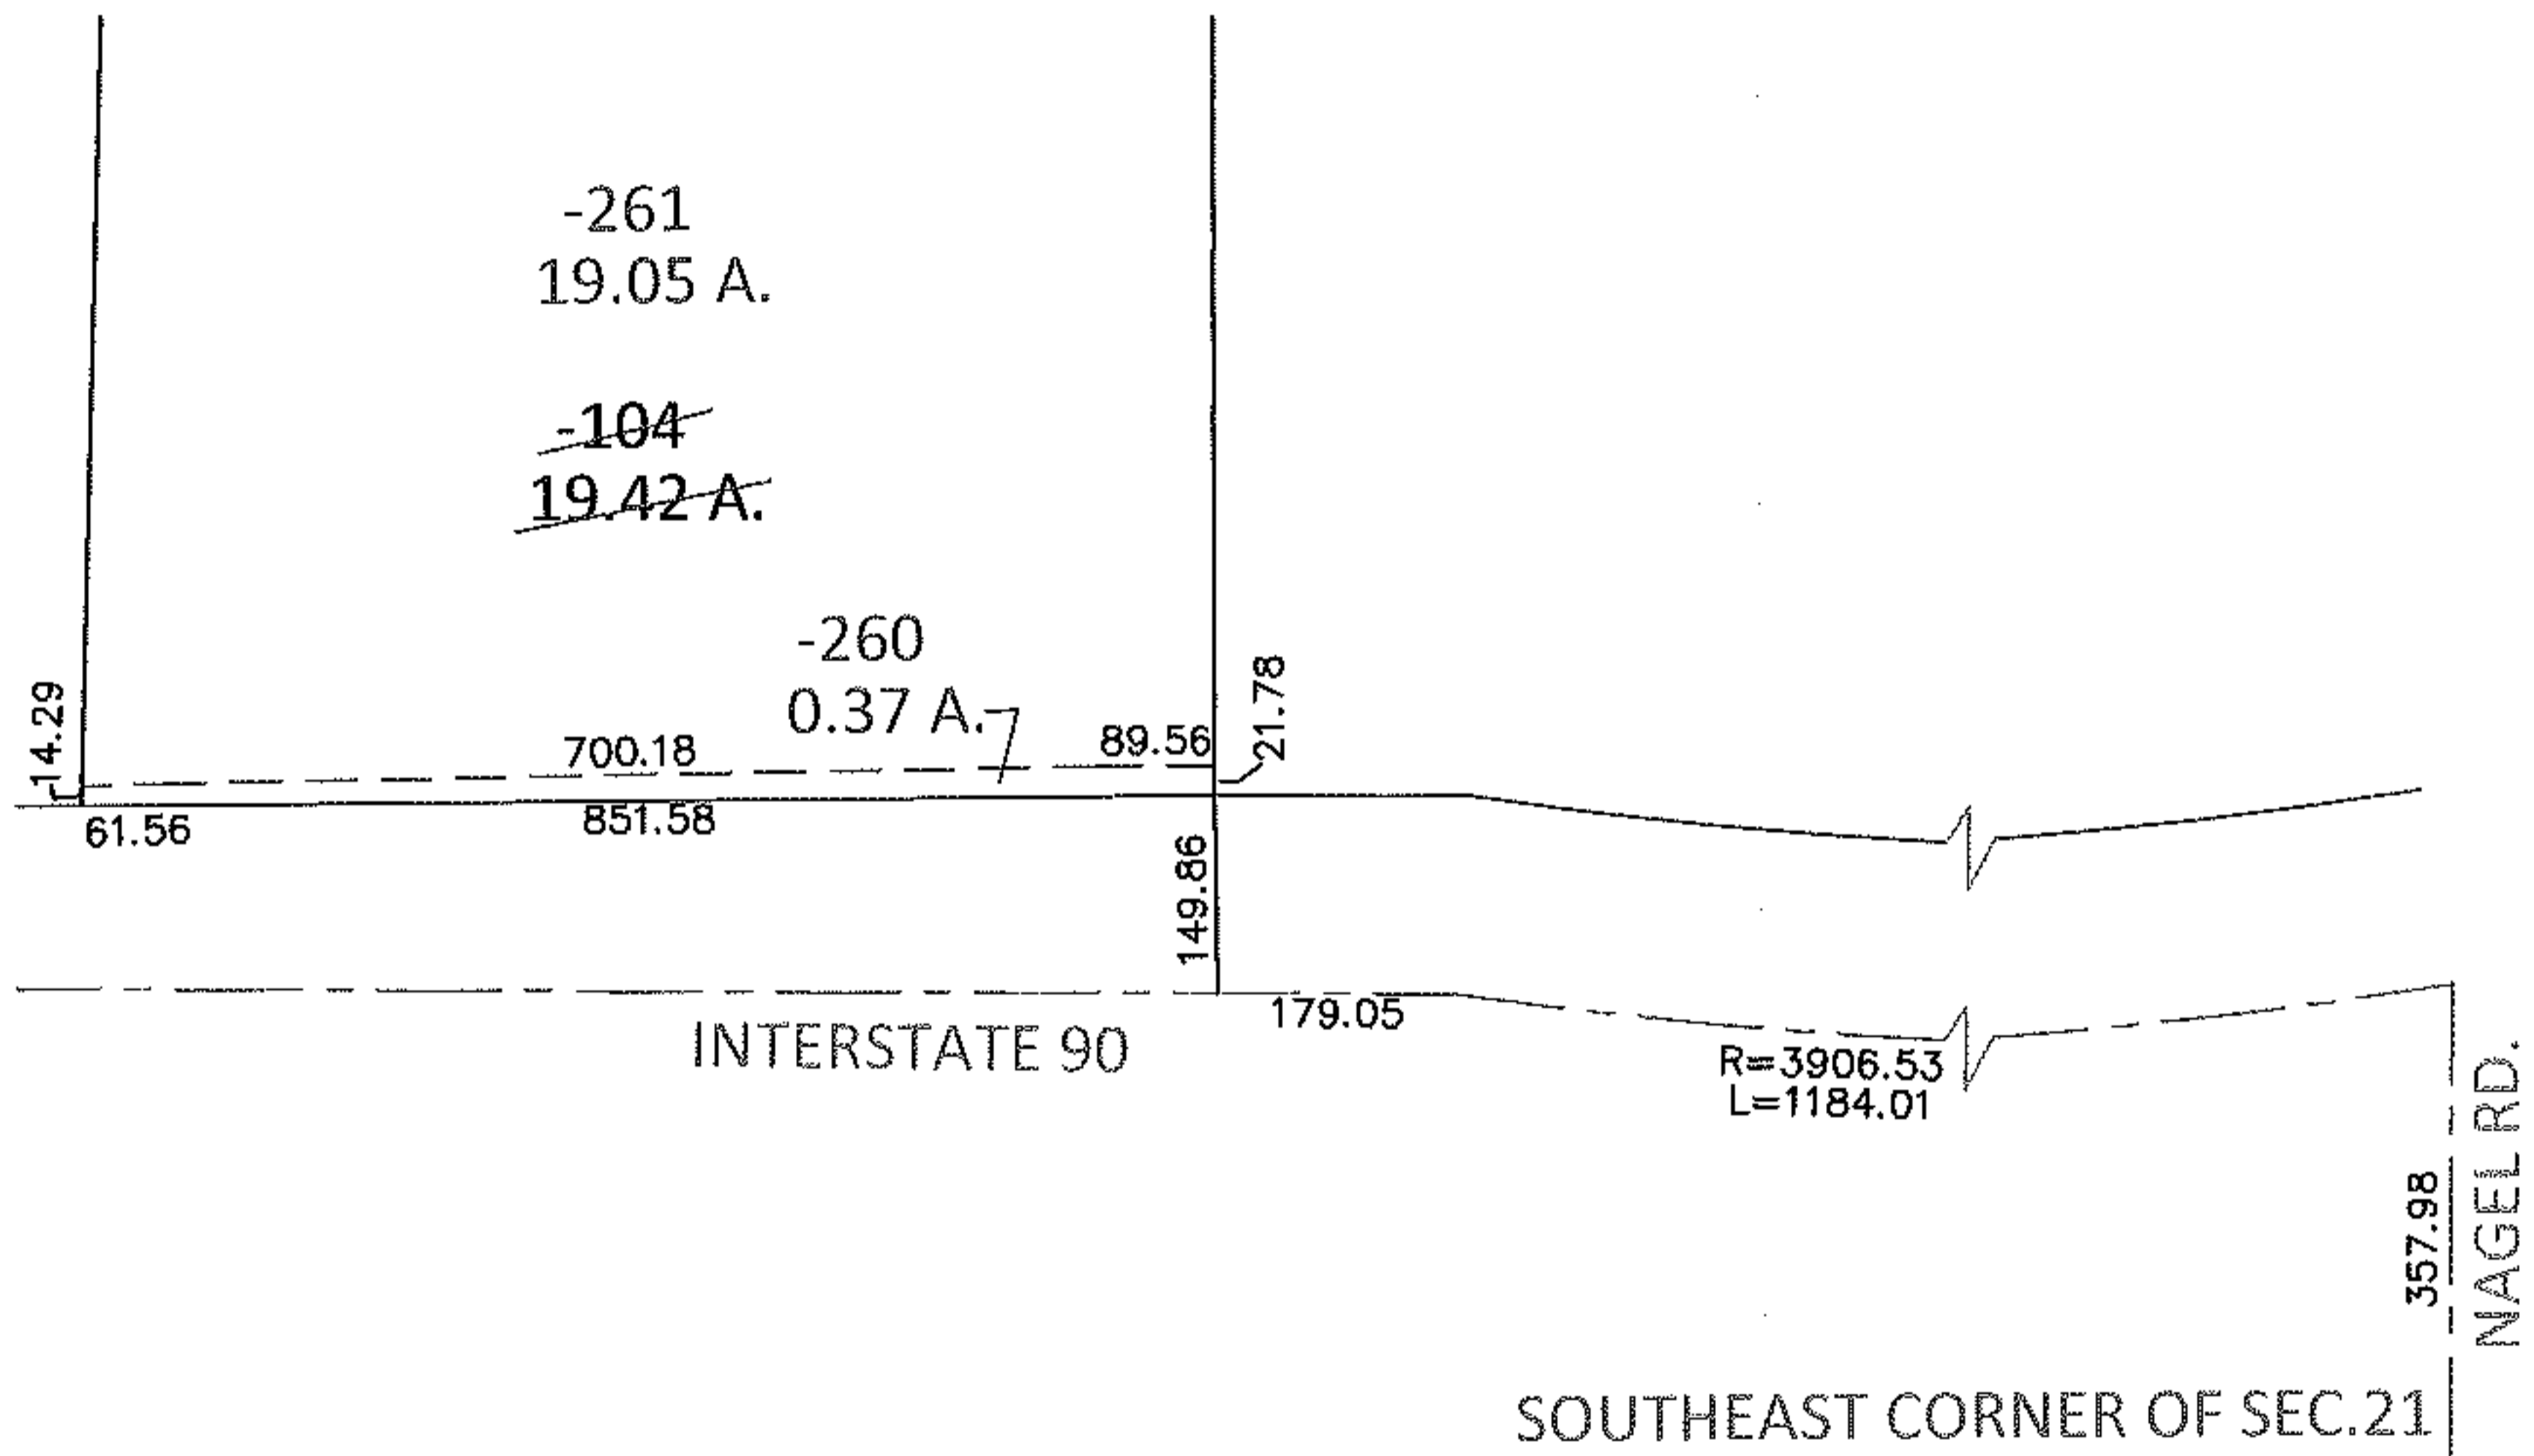


PARENT PARCEL: 04-00-021-000-104

CHILD PARCEL: 04-00-021-000-260, -261

10-00217

STARTING POINT: SOUTHEAST CORNER OF SEC. 21

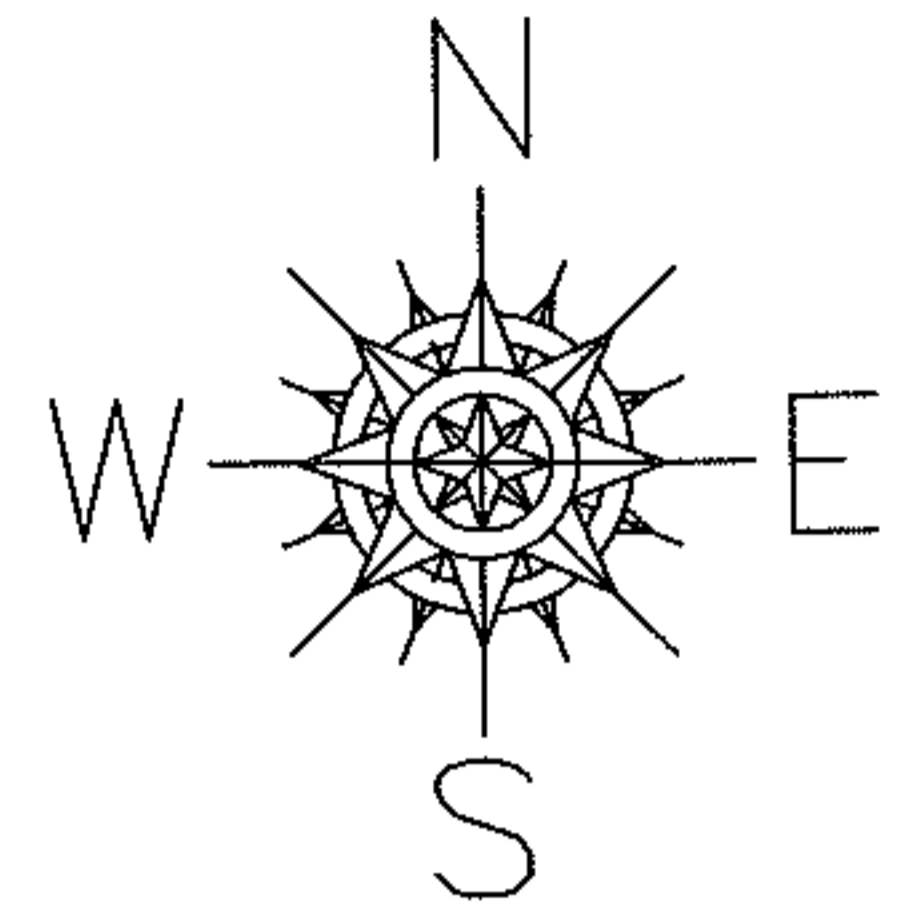

SPLITS/DEEDS PROCESSED

LORAIN COUNTY TAX MAP DEPARTMENT
226 MIDDLE AVE. ELYRIA, OHIO

SURVEYED BY: WILLIAM J. SALA

CLOSURE: .01:10,000

MAP PAGE(S): 4-00-021-G

APPROVED BY: RRM DATE: 11-17-10

SCALE: 1"= 300 PRIOR INST.: OR 22/947