


PECK - WADSWORTH 10044

SEE 17-D

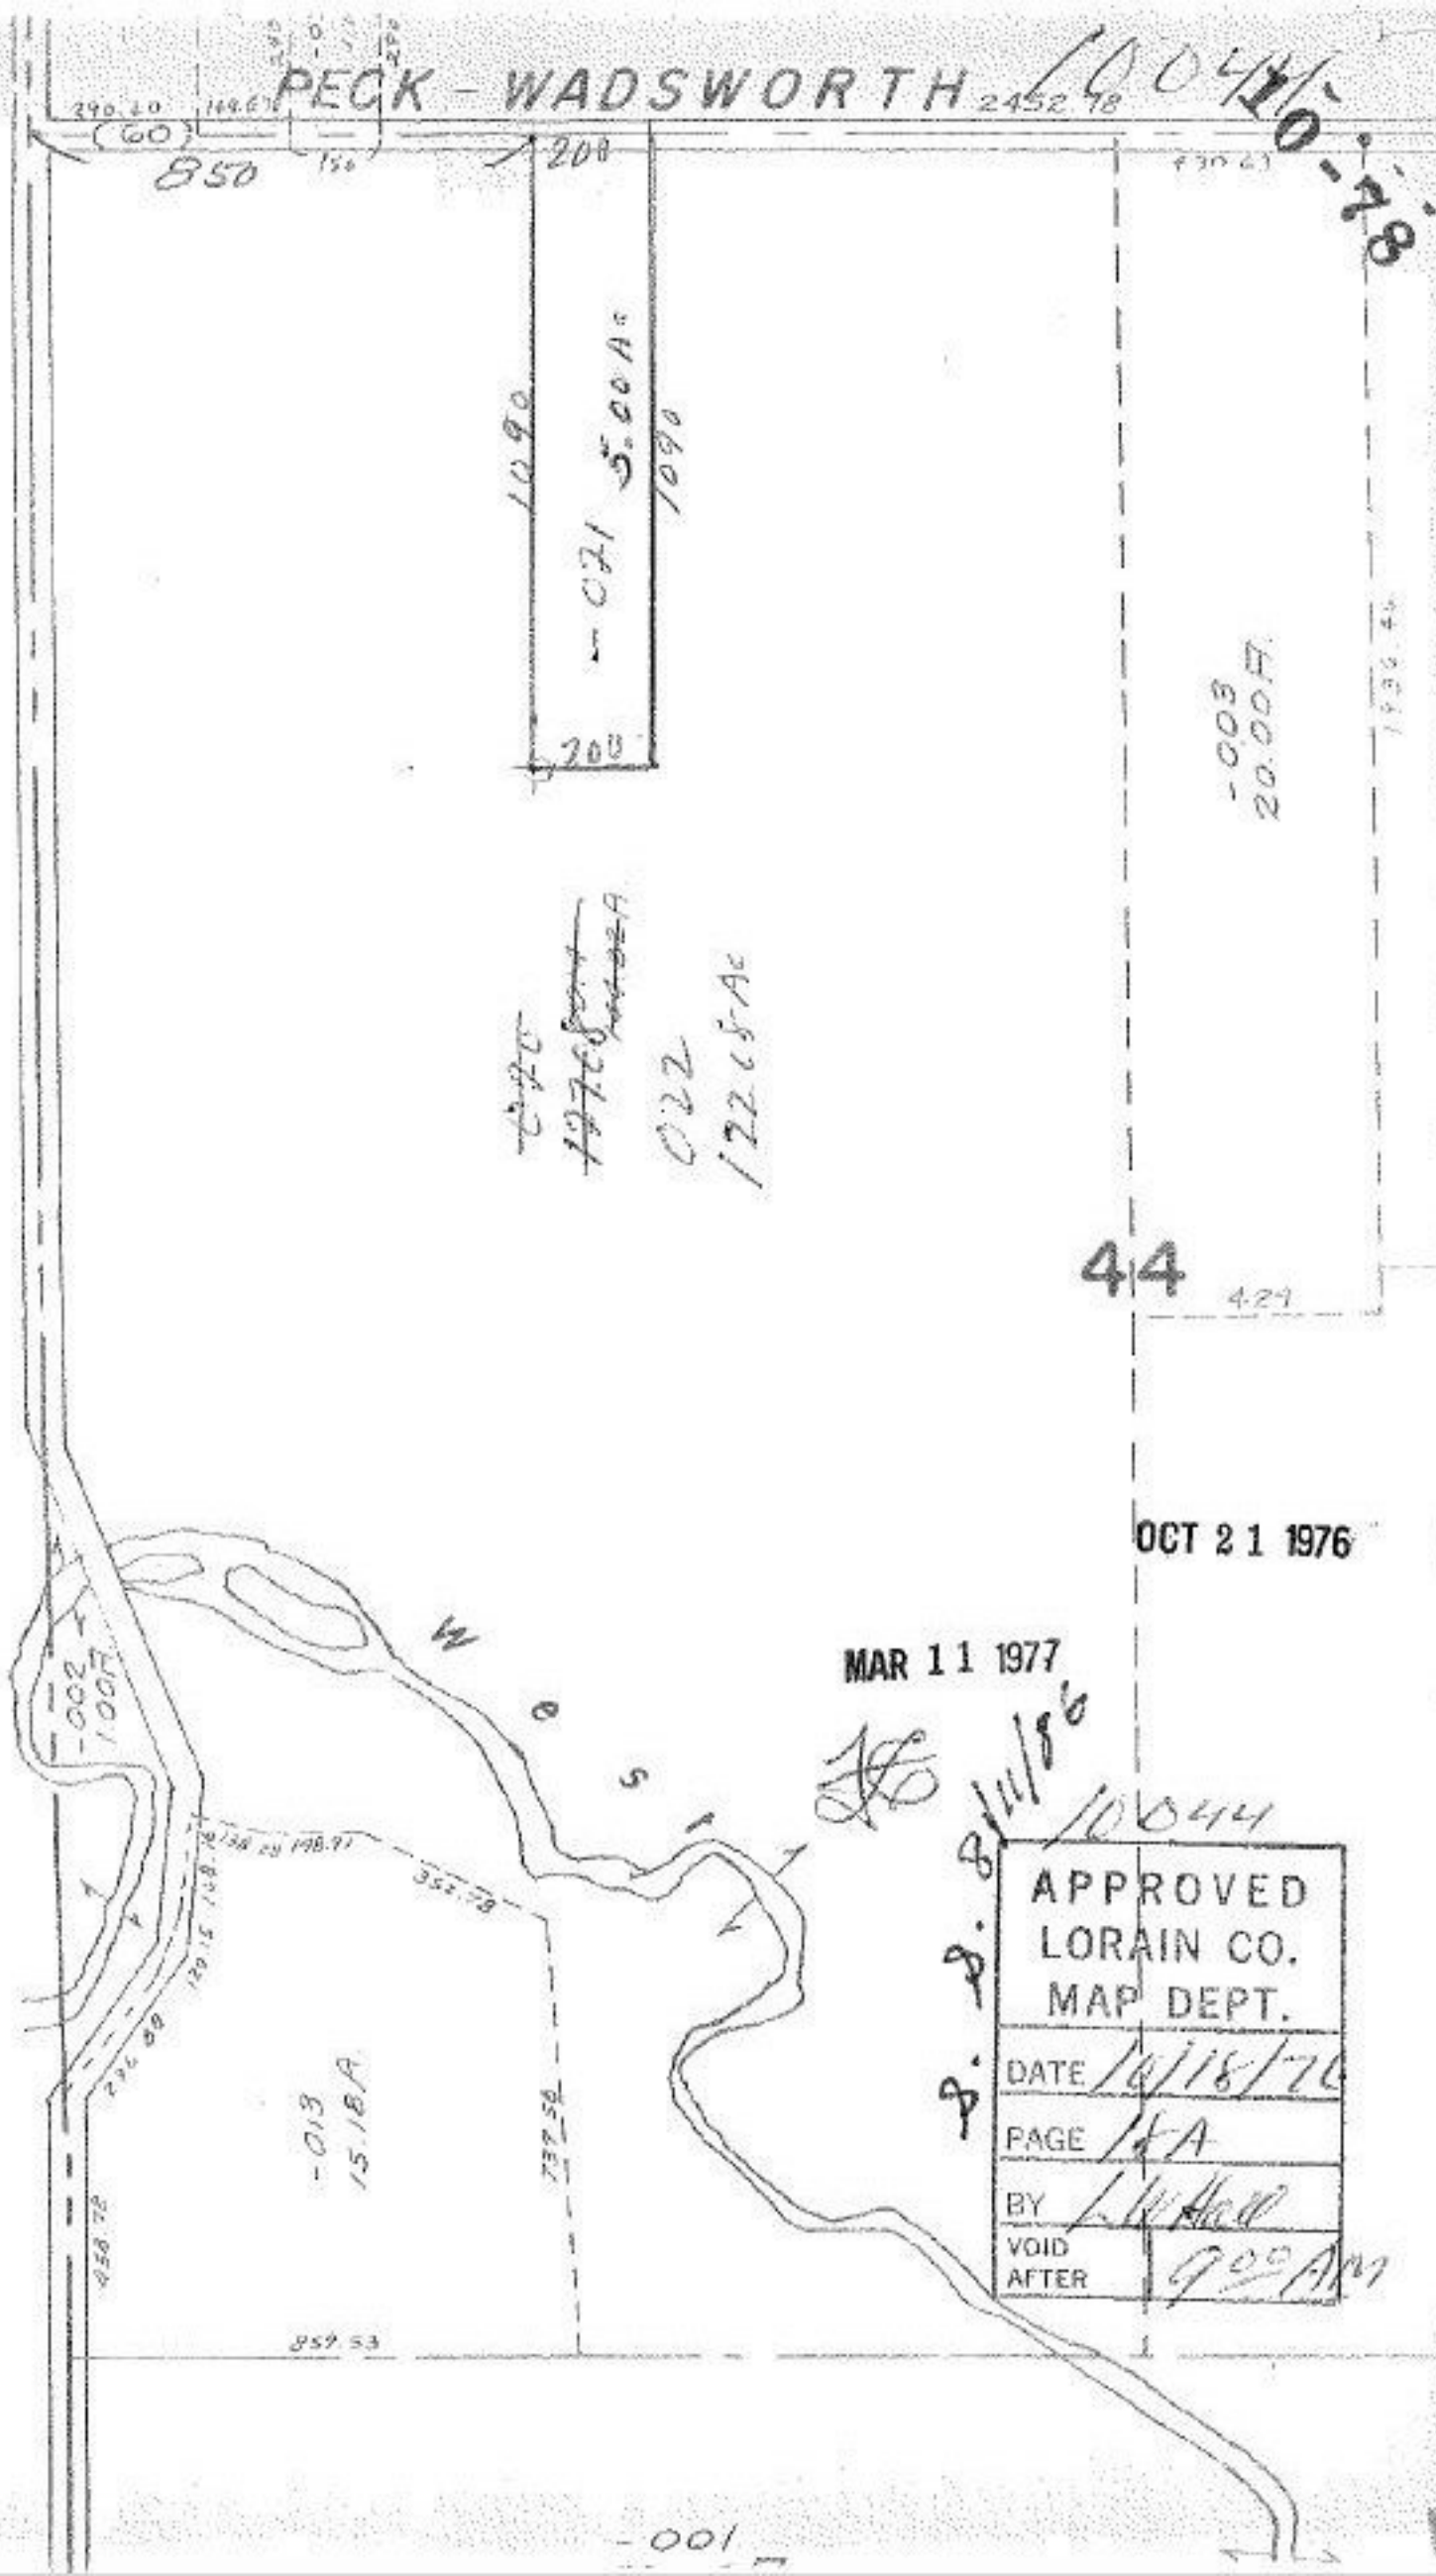

-021 5.00 Ac
1090
200

~~020~~
1976
022
122.68 Ac

-003
20.00 Ac

44

OCT 21 1976

MAR 11 1977

10044

APPROVED LORAIN CO. MAP DEPT.	
DATE	10/18/76
PAGE	18A
BY	L. W. Hall
VOID AFTER	9:00 AM

-013
15.18 Ac

-001