


10-052

10-052 ✓

044
10.40Ac

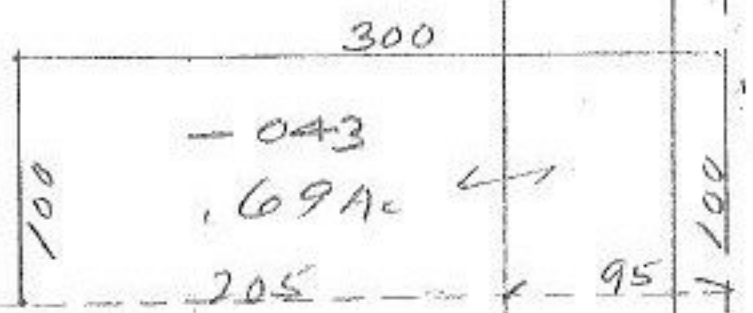

- 033
14.03 A
///

DEC 2 1976

10-052

APPROVED
L. W. HALL CO.
NEW DEPT.
DATE 10/19/76
PAGE 09-00-004A
BY L. W. Hall
VOID AFTER 11:05

OCT 27 1976

373.93

///

29