


10-069-10-10  
87-10-10  
SEE 9-00-10

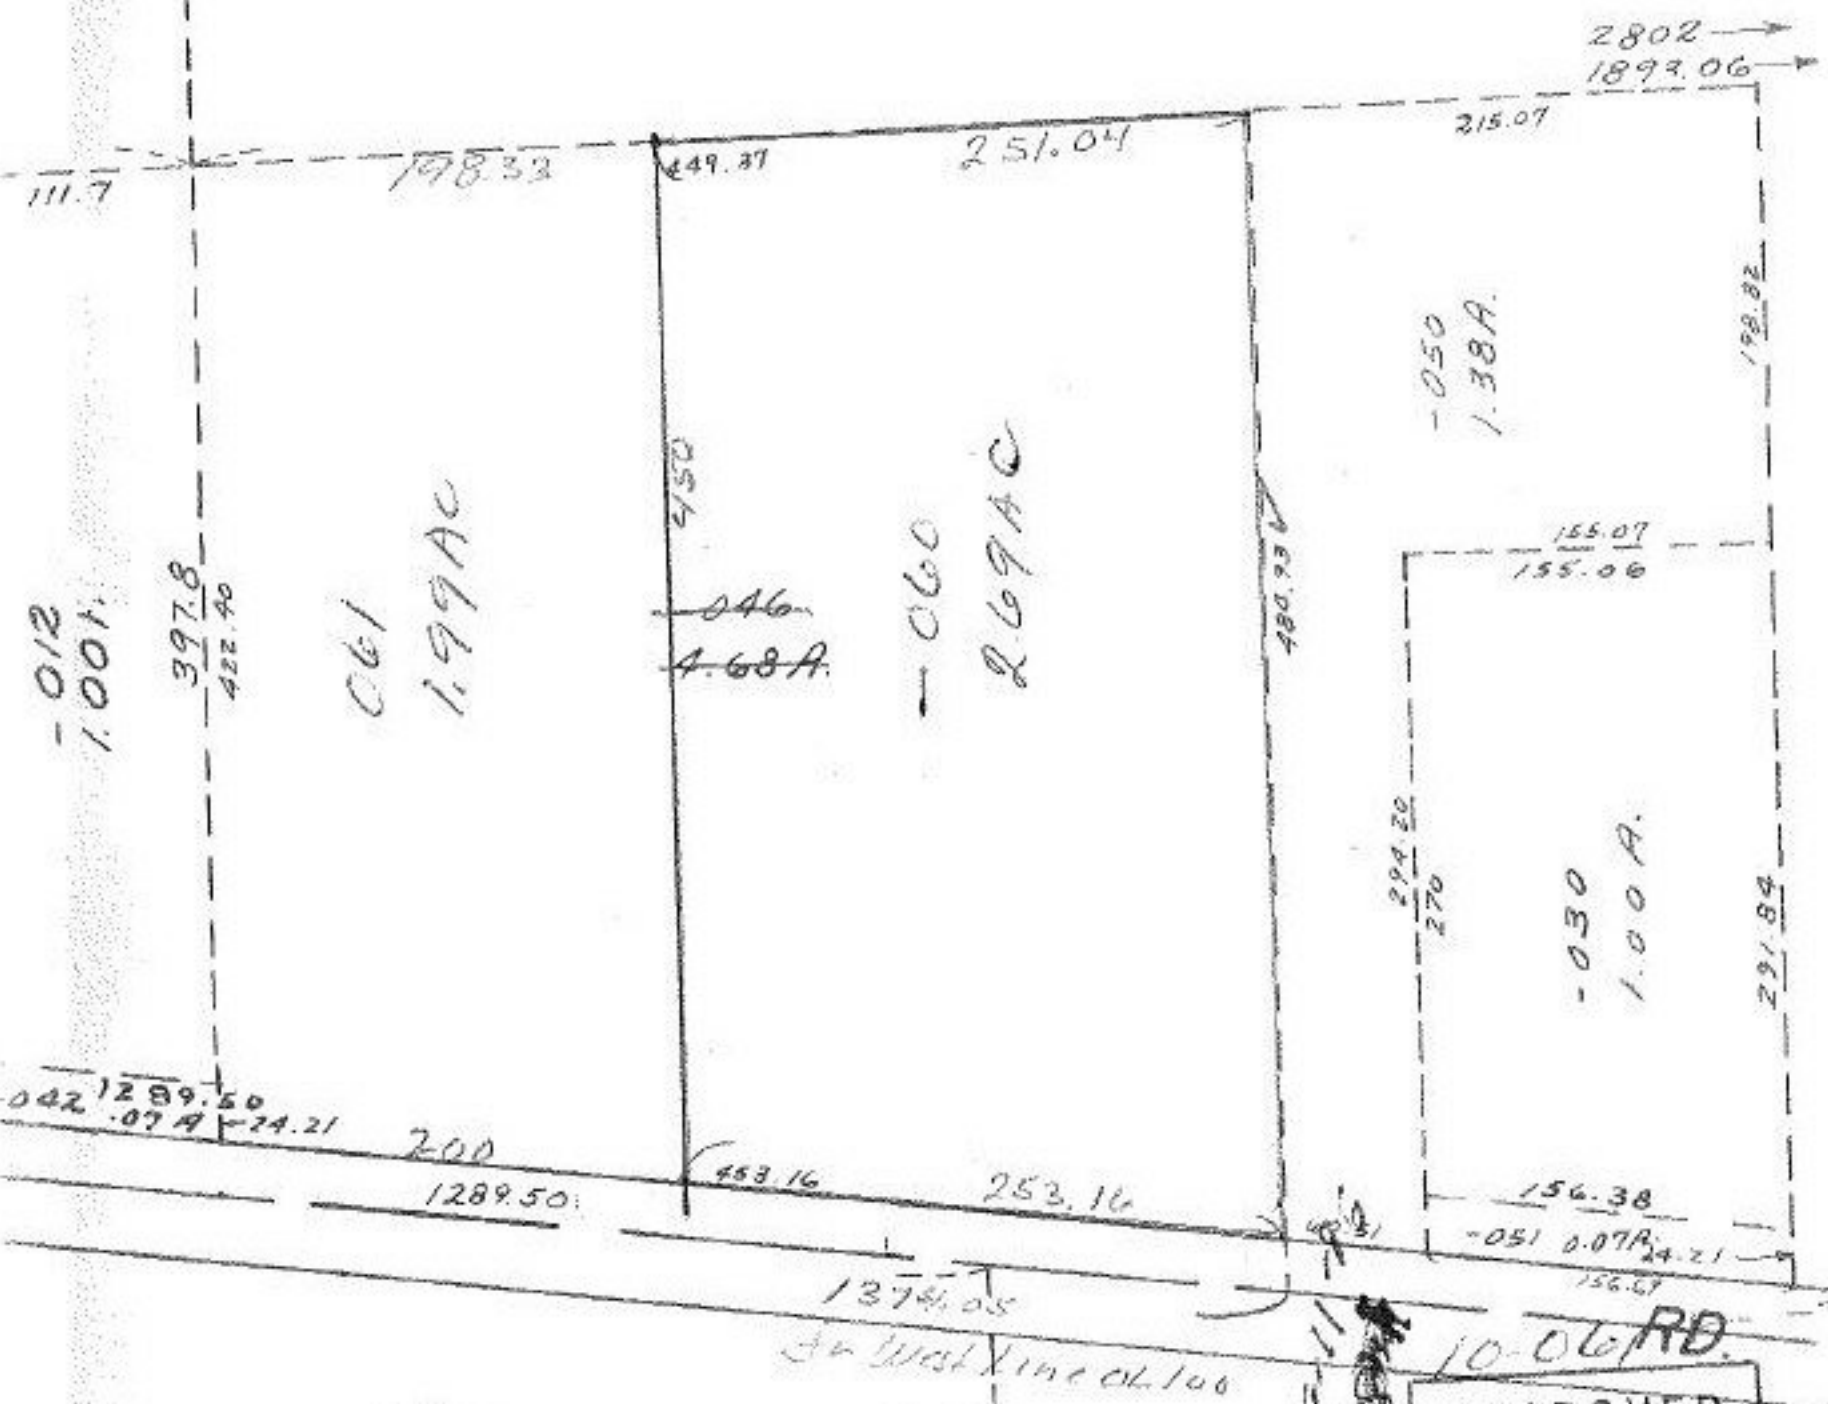

OCT 25 1976  
DEC 2 1976  
*[Signature]*

APPROVED LORAIN CO. MAP DEPT.	
DATE	10/21/76
PAGE	9-00-100A
BY	L.W. Hall
VOID AFTER	1200 Noob