



100711  
287

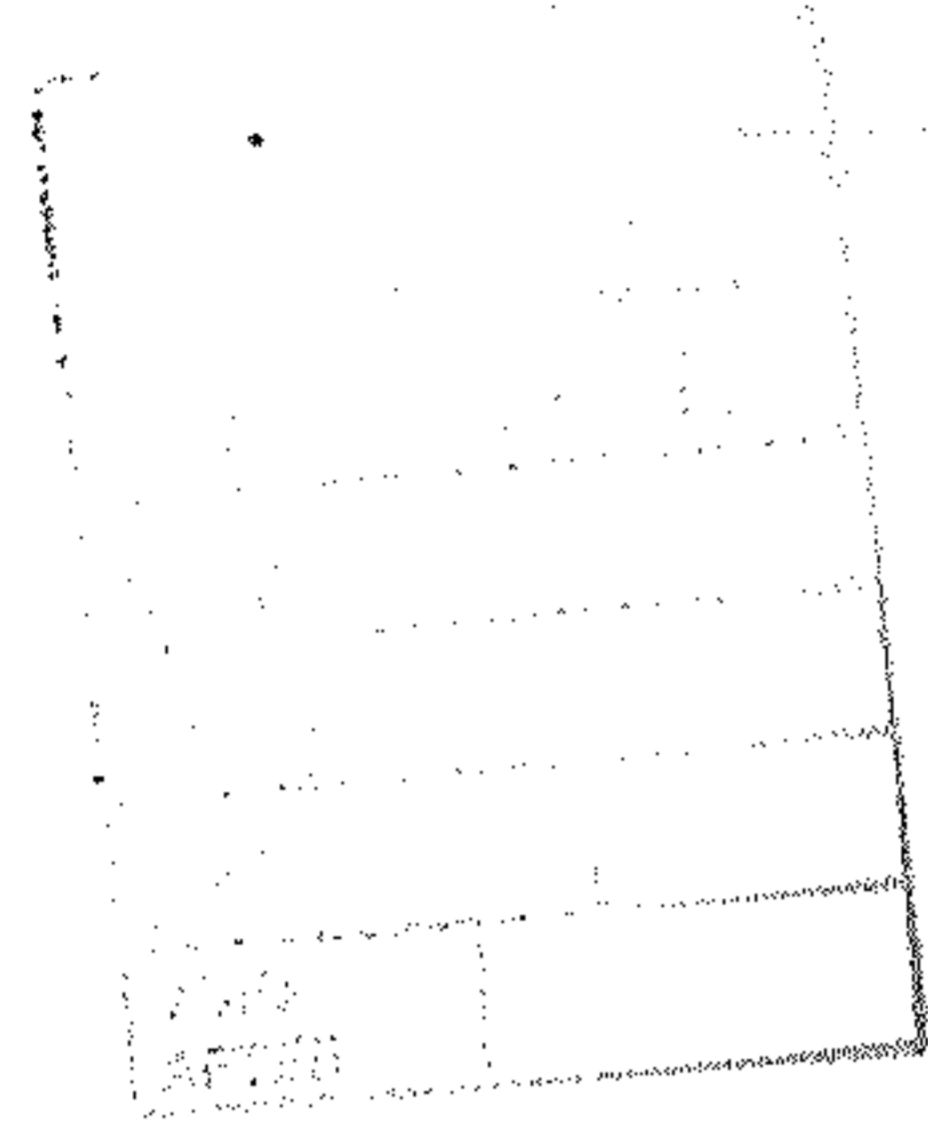

10-071  
~~013~~ -047  
19.06 A. 17.58 A.C

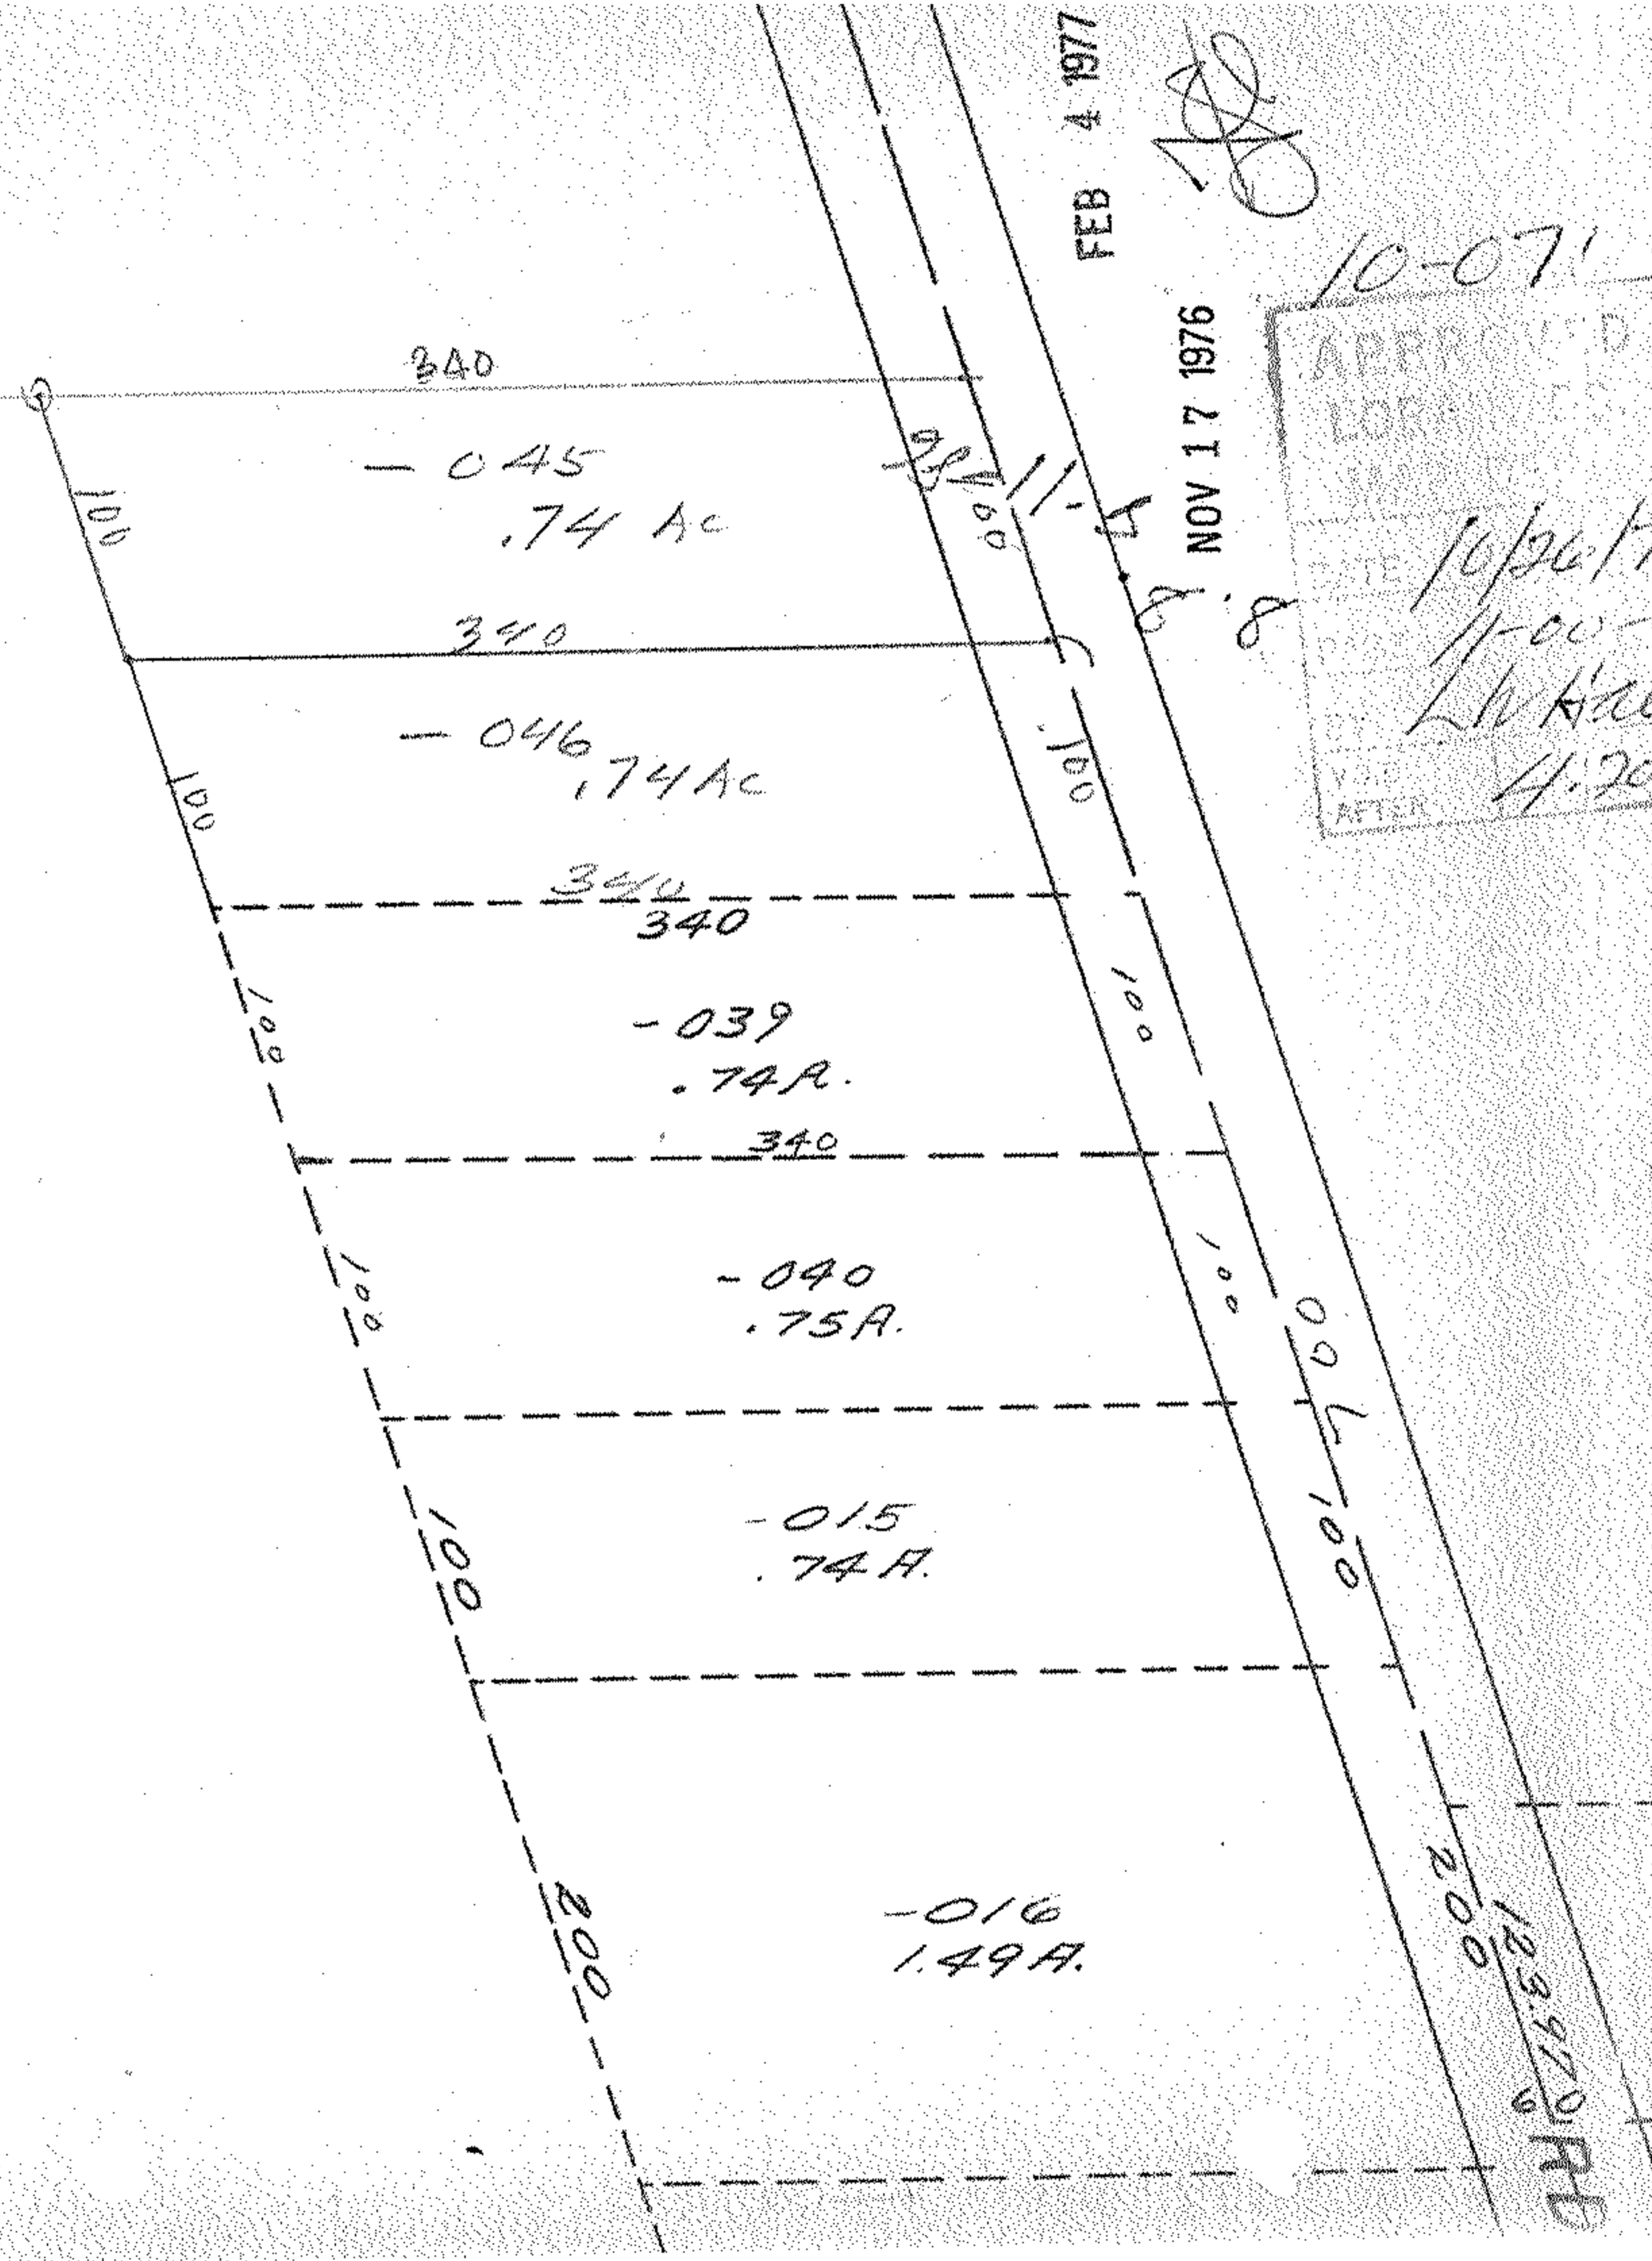

FEB 4 1977

NOV 17 1976

10-071  
APPROVED  
10/26/76  
11-00-098A  
L.H. Hall  
4:20 PM

PT. -09A  
PT. A3.42 A.

