



101

10-1078

-030  
11.42A

~~076~~  
~~8.87A~~

-078  
8.17Ac

JAN 18 1977

NOV 17 1976


10-107

APPROVED  
LORAIN CO.  
MAP DEPT.  
DATE 11/12/76  
PAGE 07-00-0284  
BY LW Hall  
VOID AFTER 30PM

10-107

APPROVED  
LORAIN CO.  
MAP DEPT.  
DATE 11/12/76  
PAGE 7-00-028C  
BY LW Hall  
VOID AFTER 30PM

163.12  
54.22  
107.23

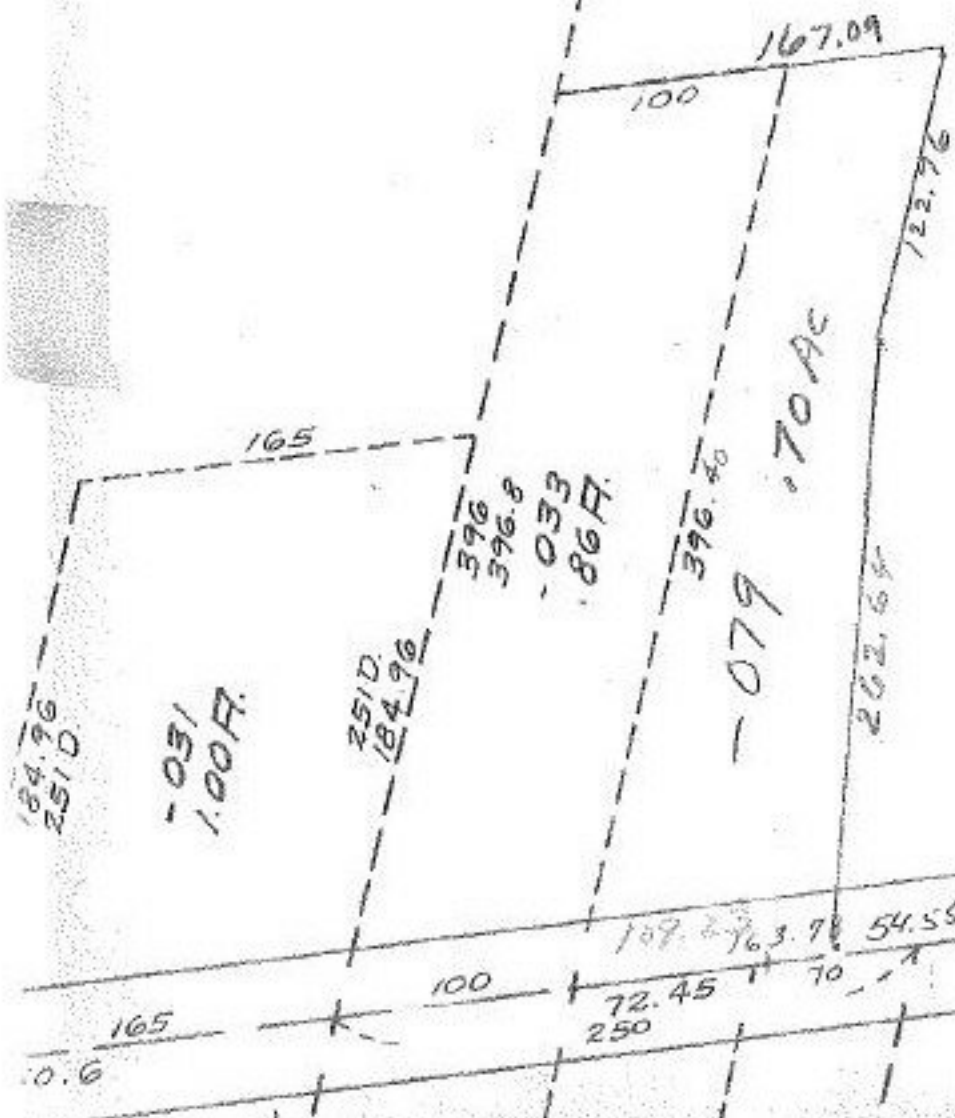

8-7-86 L.L.

274.5

84°09'

