

COLUMBUS WEST RIVER 972

10-118  
Cemetery  
-011  
7.00A.

~~016~~  
~~17.96~~

028  
16.03

Lot 10

~~016~~  
~~17.96A.~~


028  
16.03A

FEB 10 1977

NOV 17 1976

10-118  
APPROVED  
LORAIN CO.  
MAP DEPT.

DATE 11/17/76  
PAGE 12-00-046A  
BY L.W. RACK  
VOID AFTER 1:30 PM

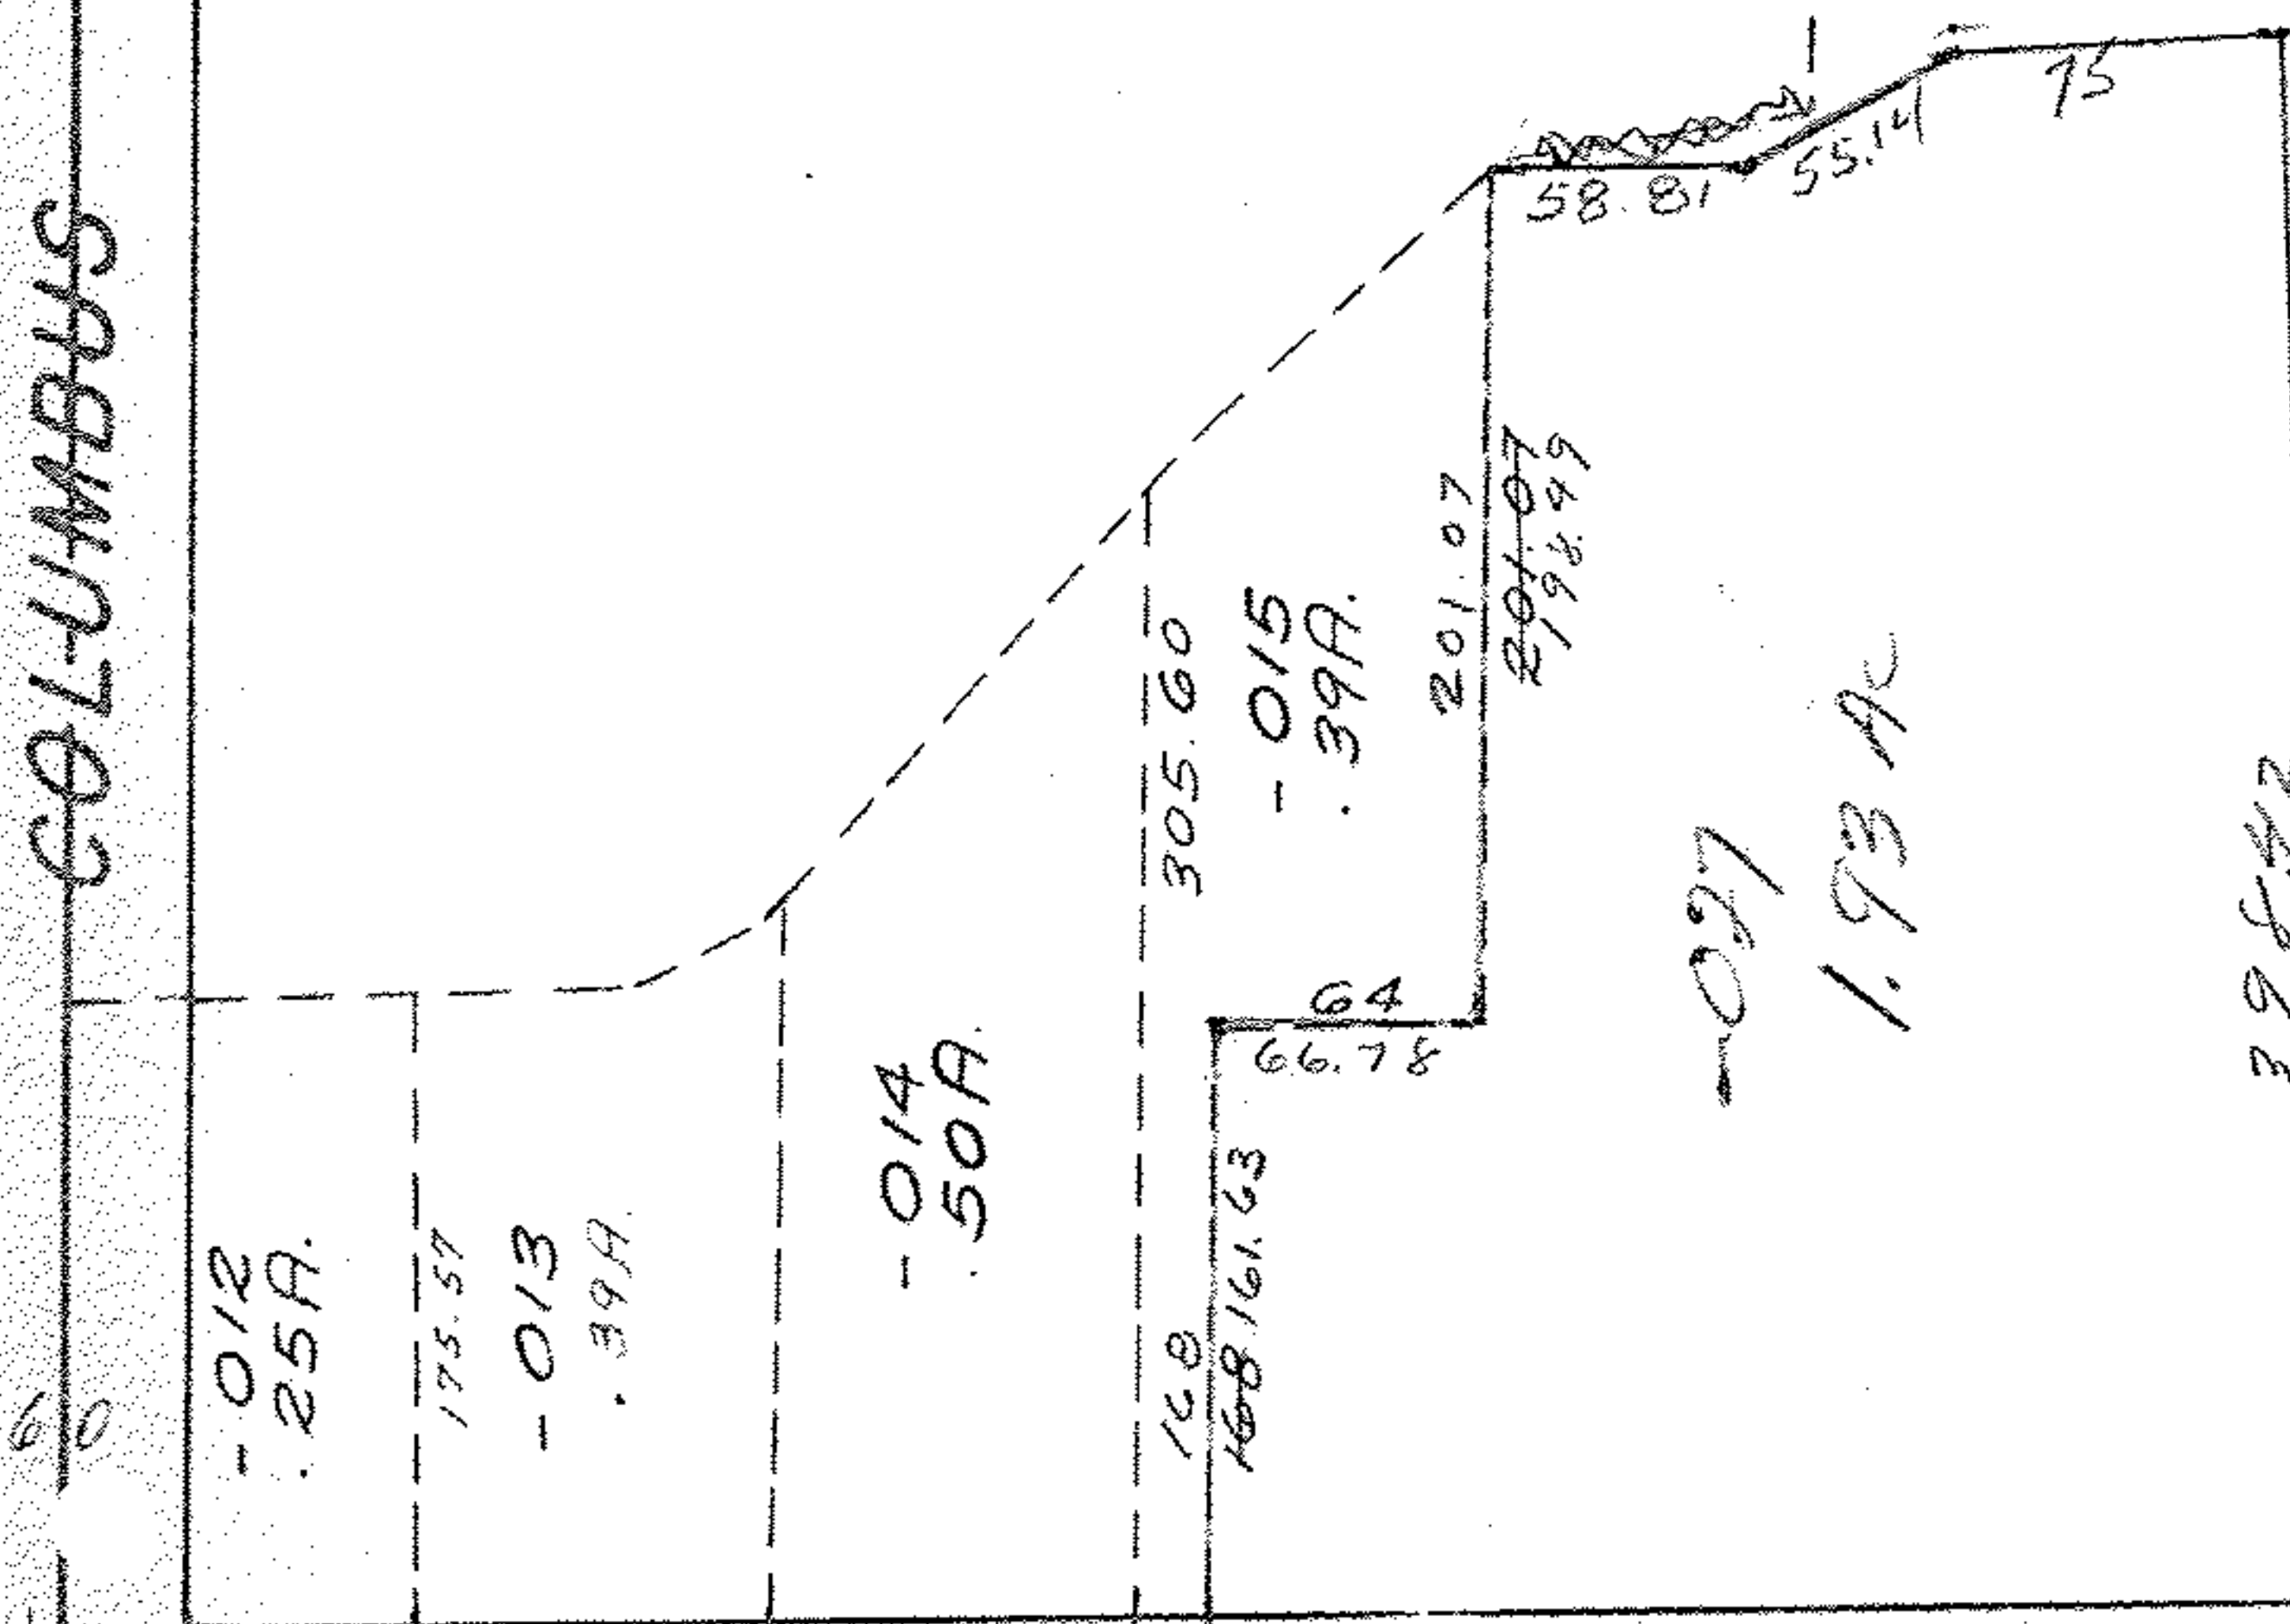

ELYRIA TWINSBURG

SFF 12-00-046-A

82

RD.

0  
# Var.