

462

10120

10-120

~~003~~  
~~155.00 A.~~

005  
151.00 A G

64


FEB 25 1977

NOV 22 1976

8-7-86 L.L.

10-120

APPROVED
LORAIN CO.
MAP DEPT.
DATE 11/18/76
PAGE 16 F
BY L.W. Hall
VOID AFTER 9:15 AM

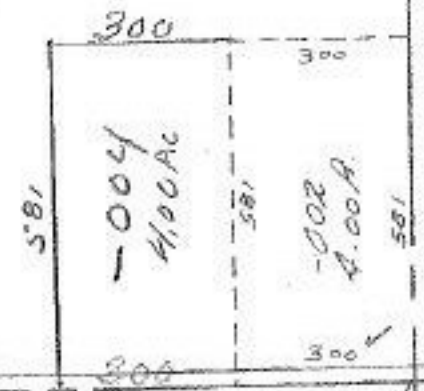

LAW

2692.8

-001  
72.00 A.

1164.7	325.65	175	125
919.39	5.40 A		
320.40	3.79 A		

64.7