


10-129

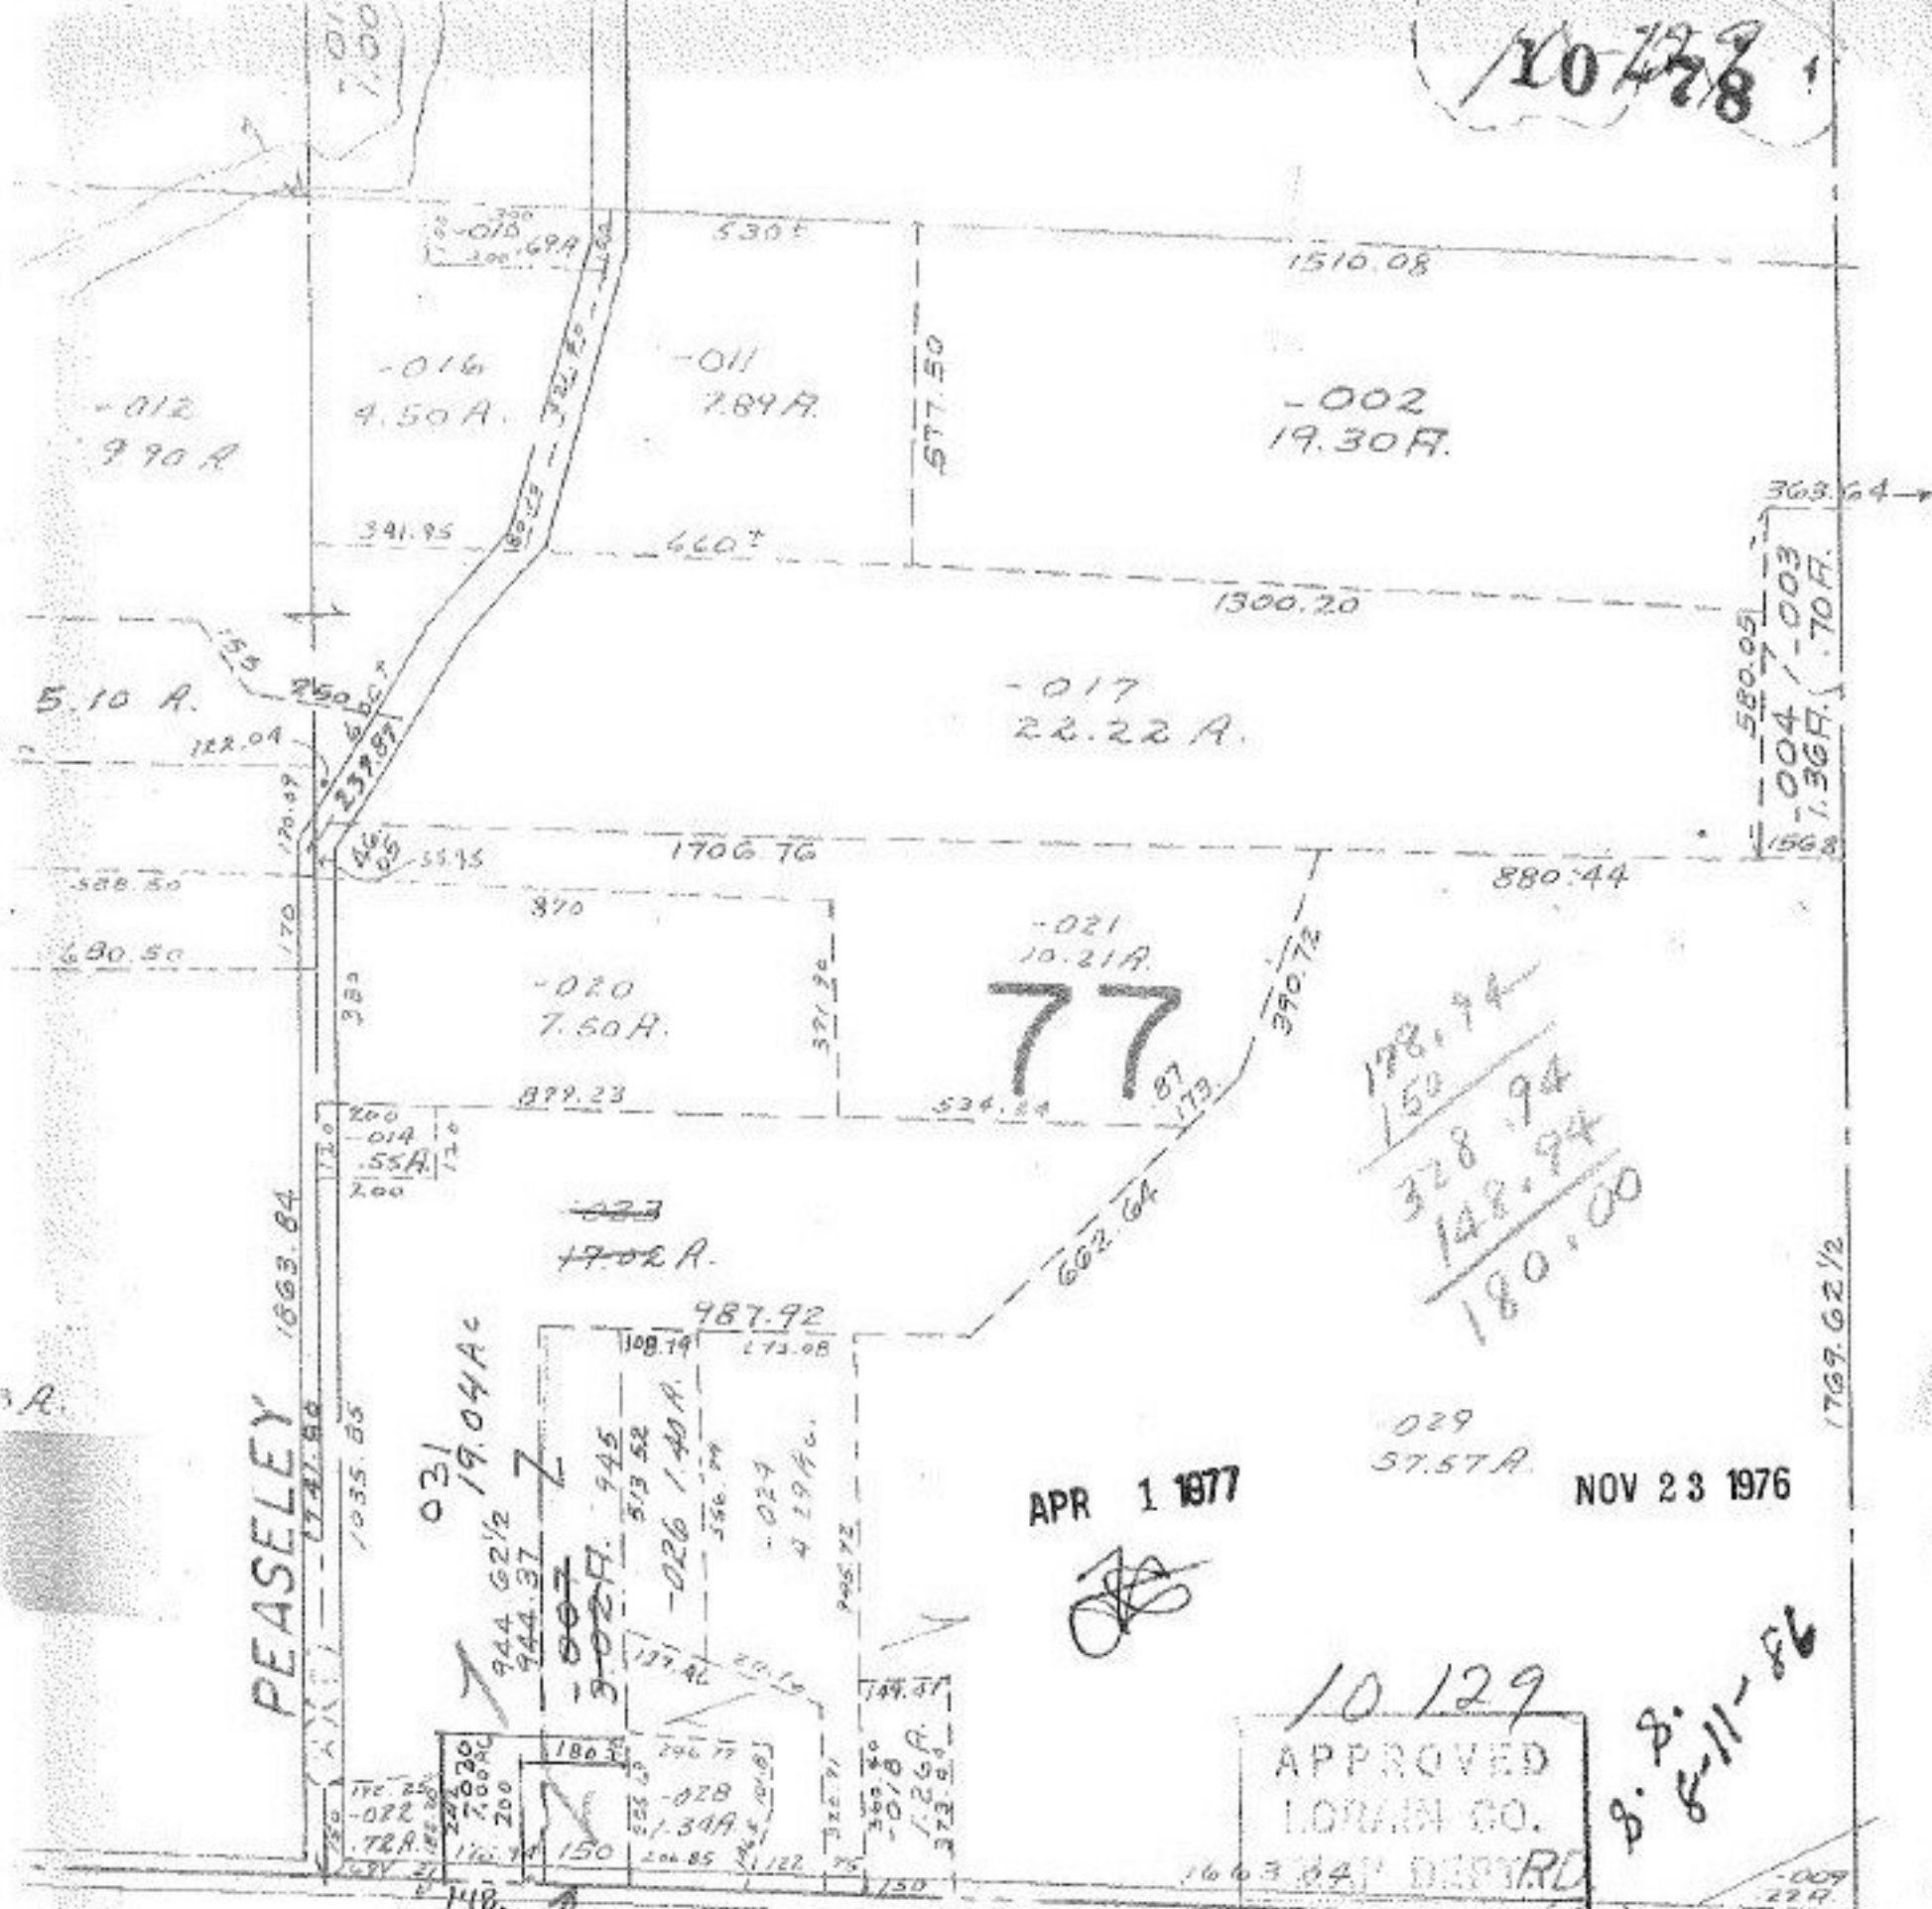

10 129  
 APPROVED  
 LOWIN CO.  
 DEPT. 11/22/76  
 BY L.W. Hall HIO  
 VOID AFTER 8:30 AM

LOTS 51, 52, 61, 62,  
 67, 68, 77, 78