




PT. 956  
 PT. 900A  
 -060  
 8.55 AC

See Also  
 (112) C-141

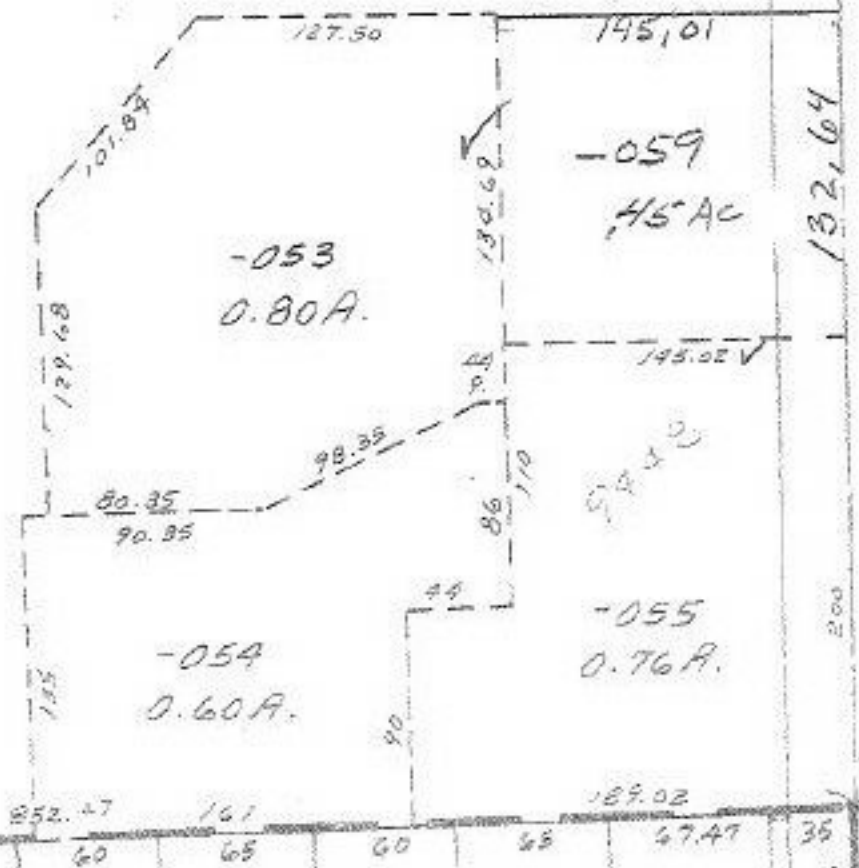

DATE	11-23-76
PAGE	6-142
BY	K. W. Hall
VOID AFTER	

MS  
 AUG 13 1977  
 DEC 3 1976

10/1/35  
 62-79