


9862
8980

10-139

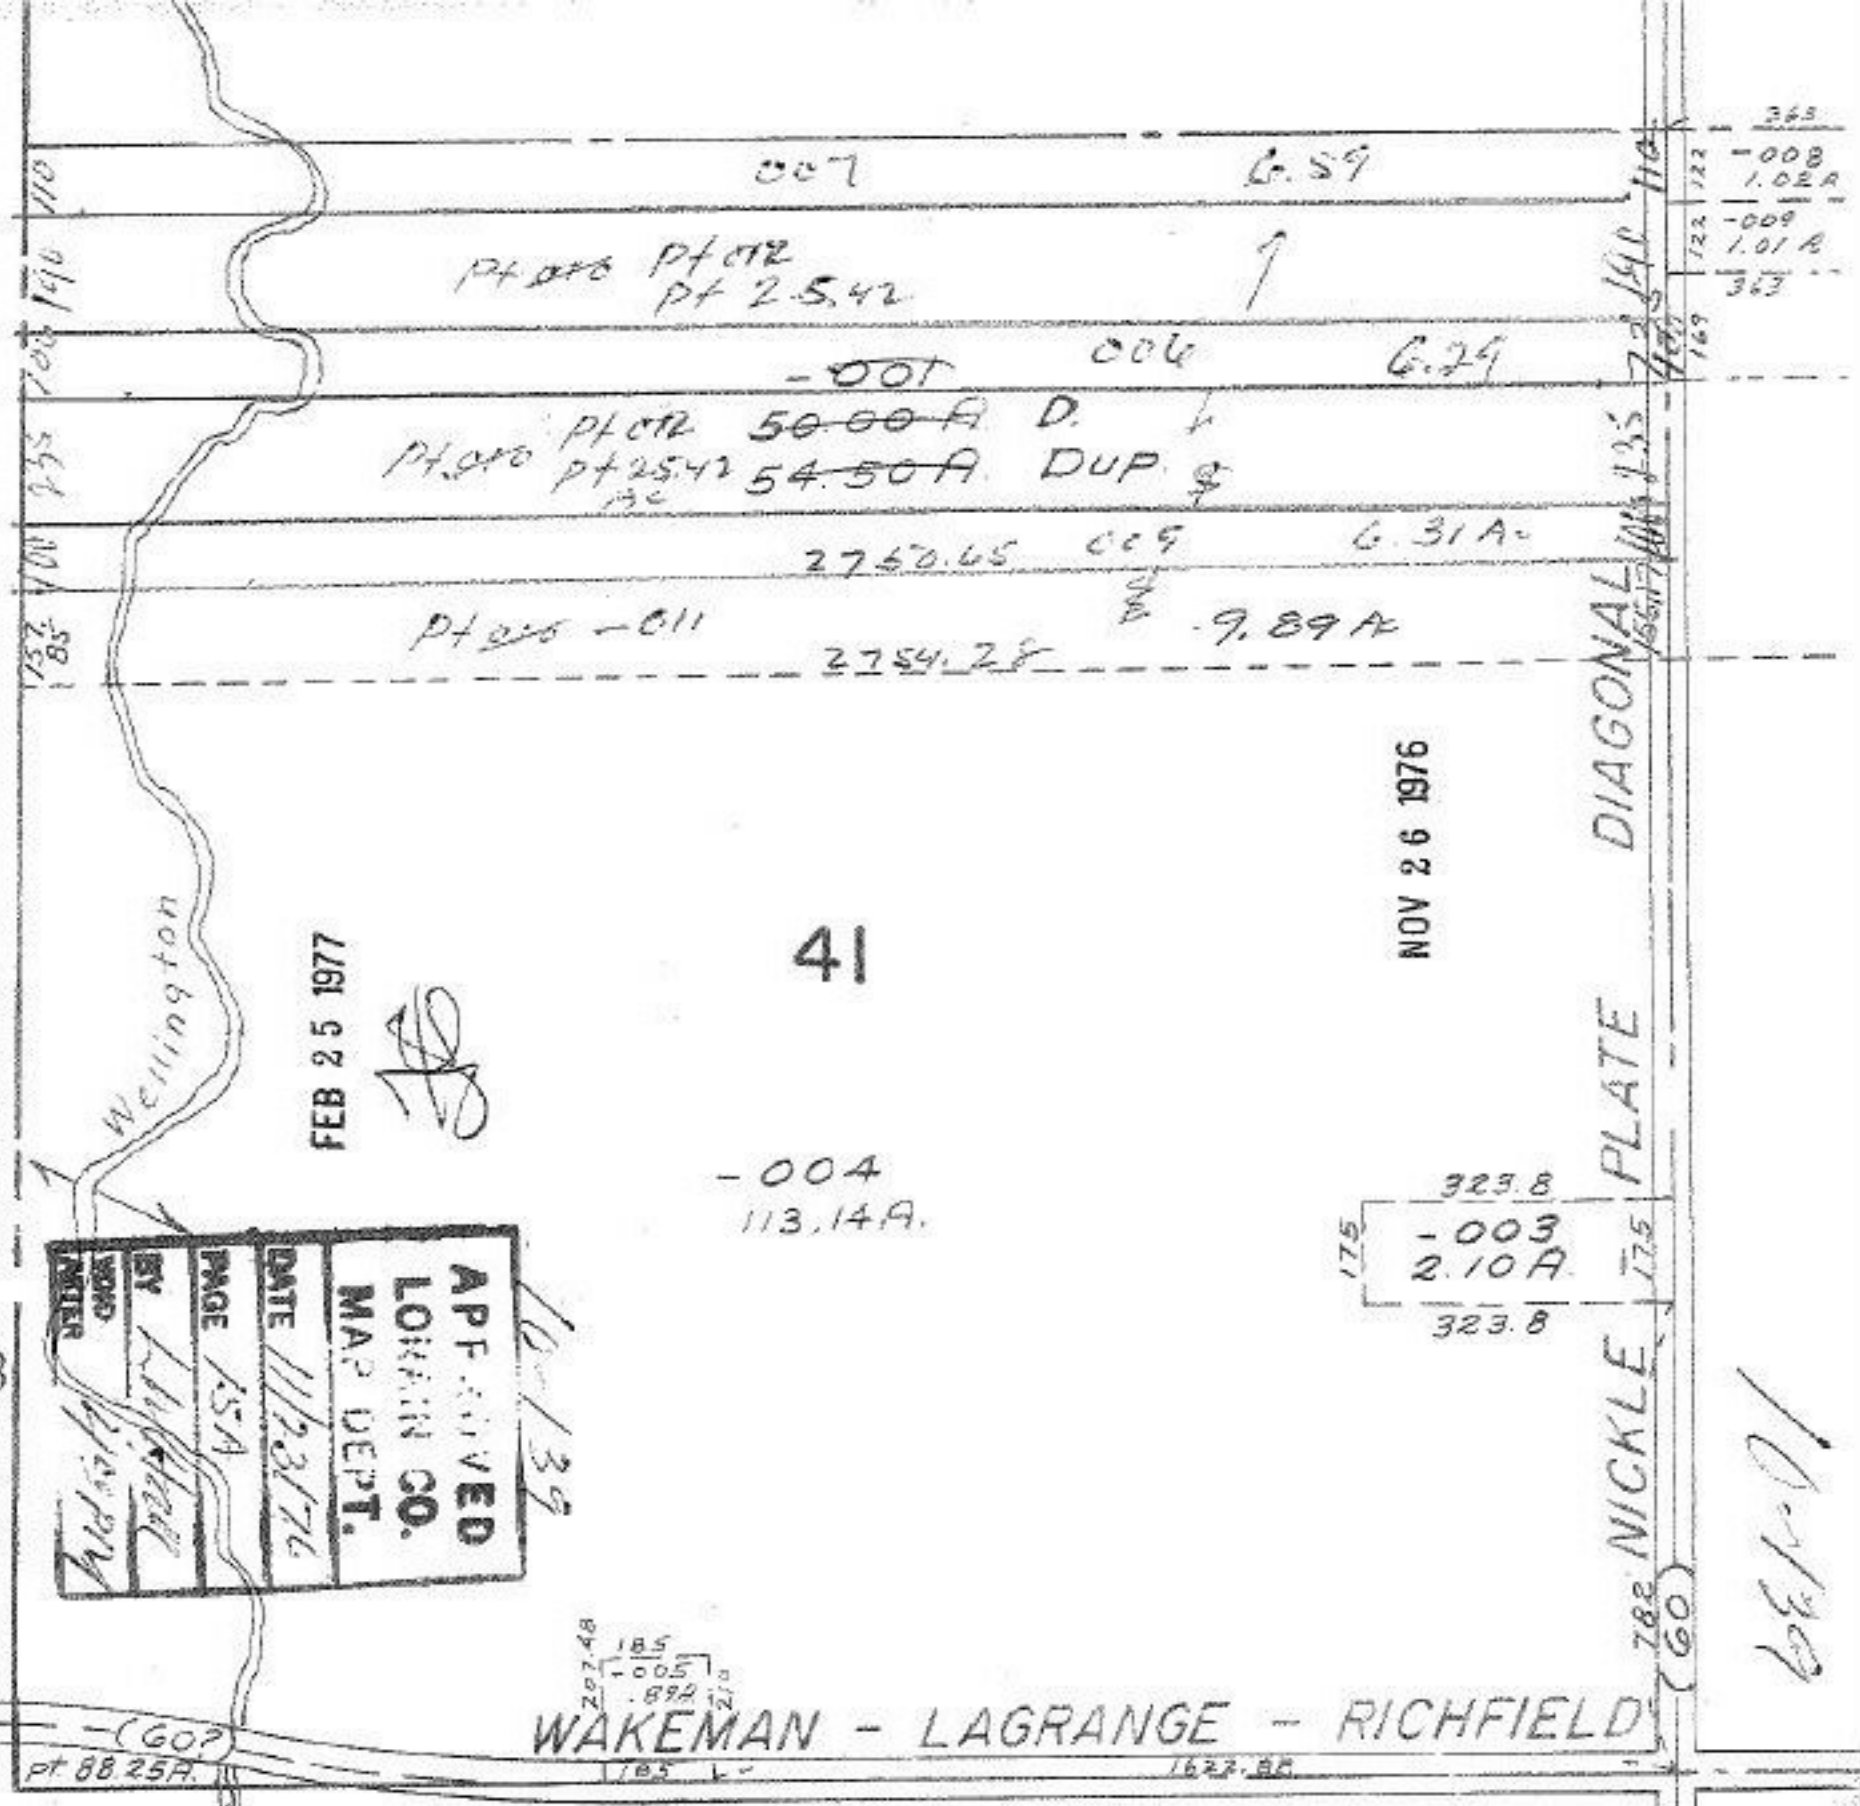

L.L. 8-1-86

APPROVED
LOKAIN CO.
MAP DEPT.
DATE 11/23/76
BY [Signature]
PROJECT [Signature]

10-139

303

WAKEMAN - LAGRANGE - RICHFIELD

LAGRANGE TWP.