

10-781

10-141

NOV 26 1976

APR 15 1977

10741

SEE


4-00-012-B

See 4-00-012B Also

APPROVED	DATE 11/24/76
LORAIN CO.	PAGE 4-00-012-F 1012B
MAP DEPT.	BY L.W. Hadd
	VOID AFTER 11:00 AM

7-7 98-L-8

PT. ~~020~~  
 PT. A1 ~~020~~?  
 C61  
 39.77

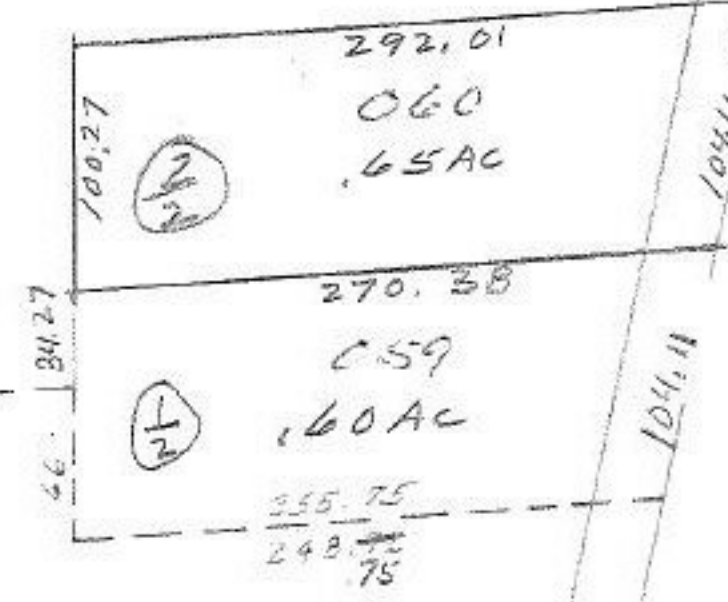

-027

87A