


10-147 82-0

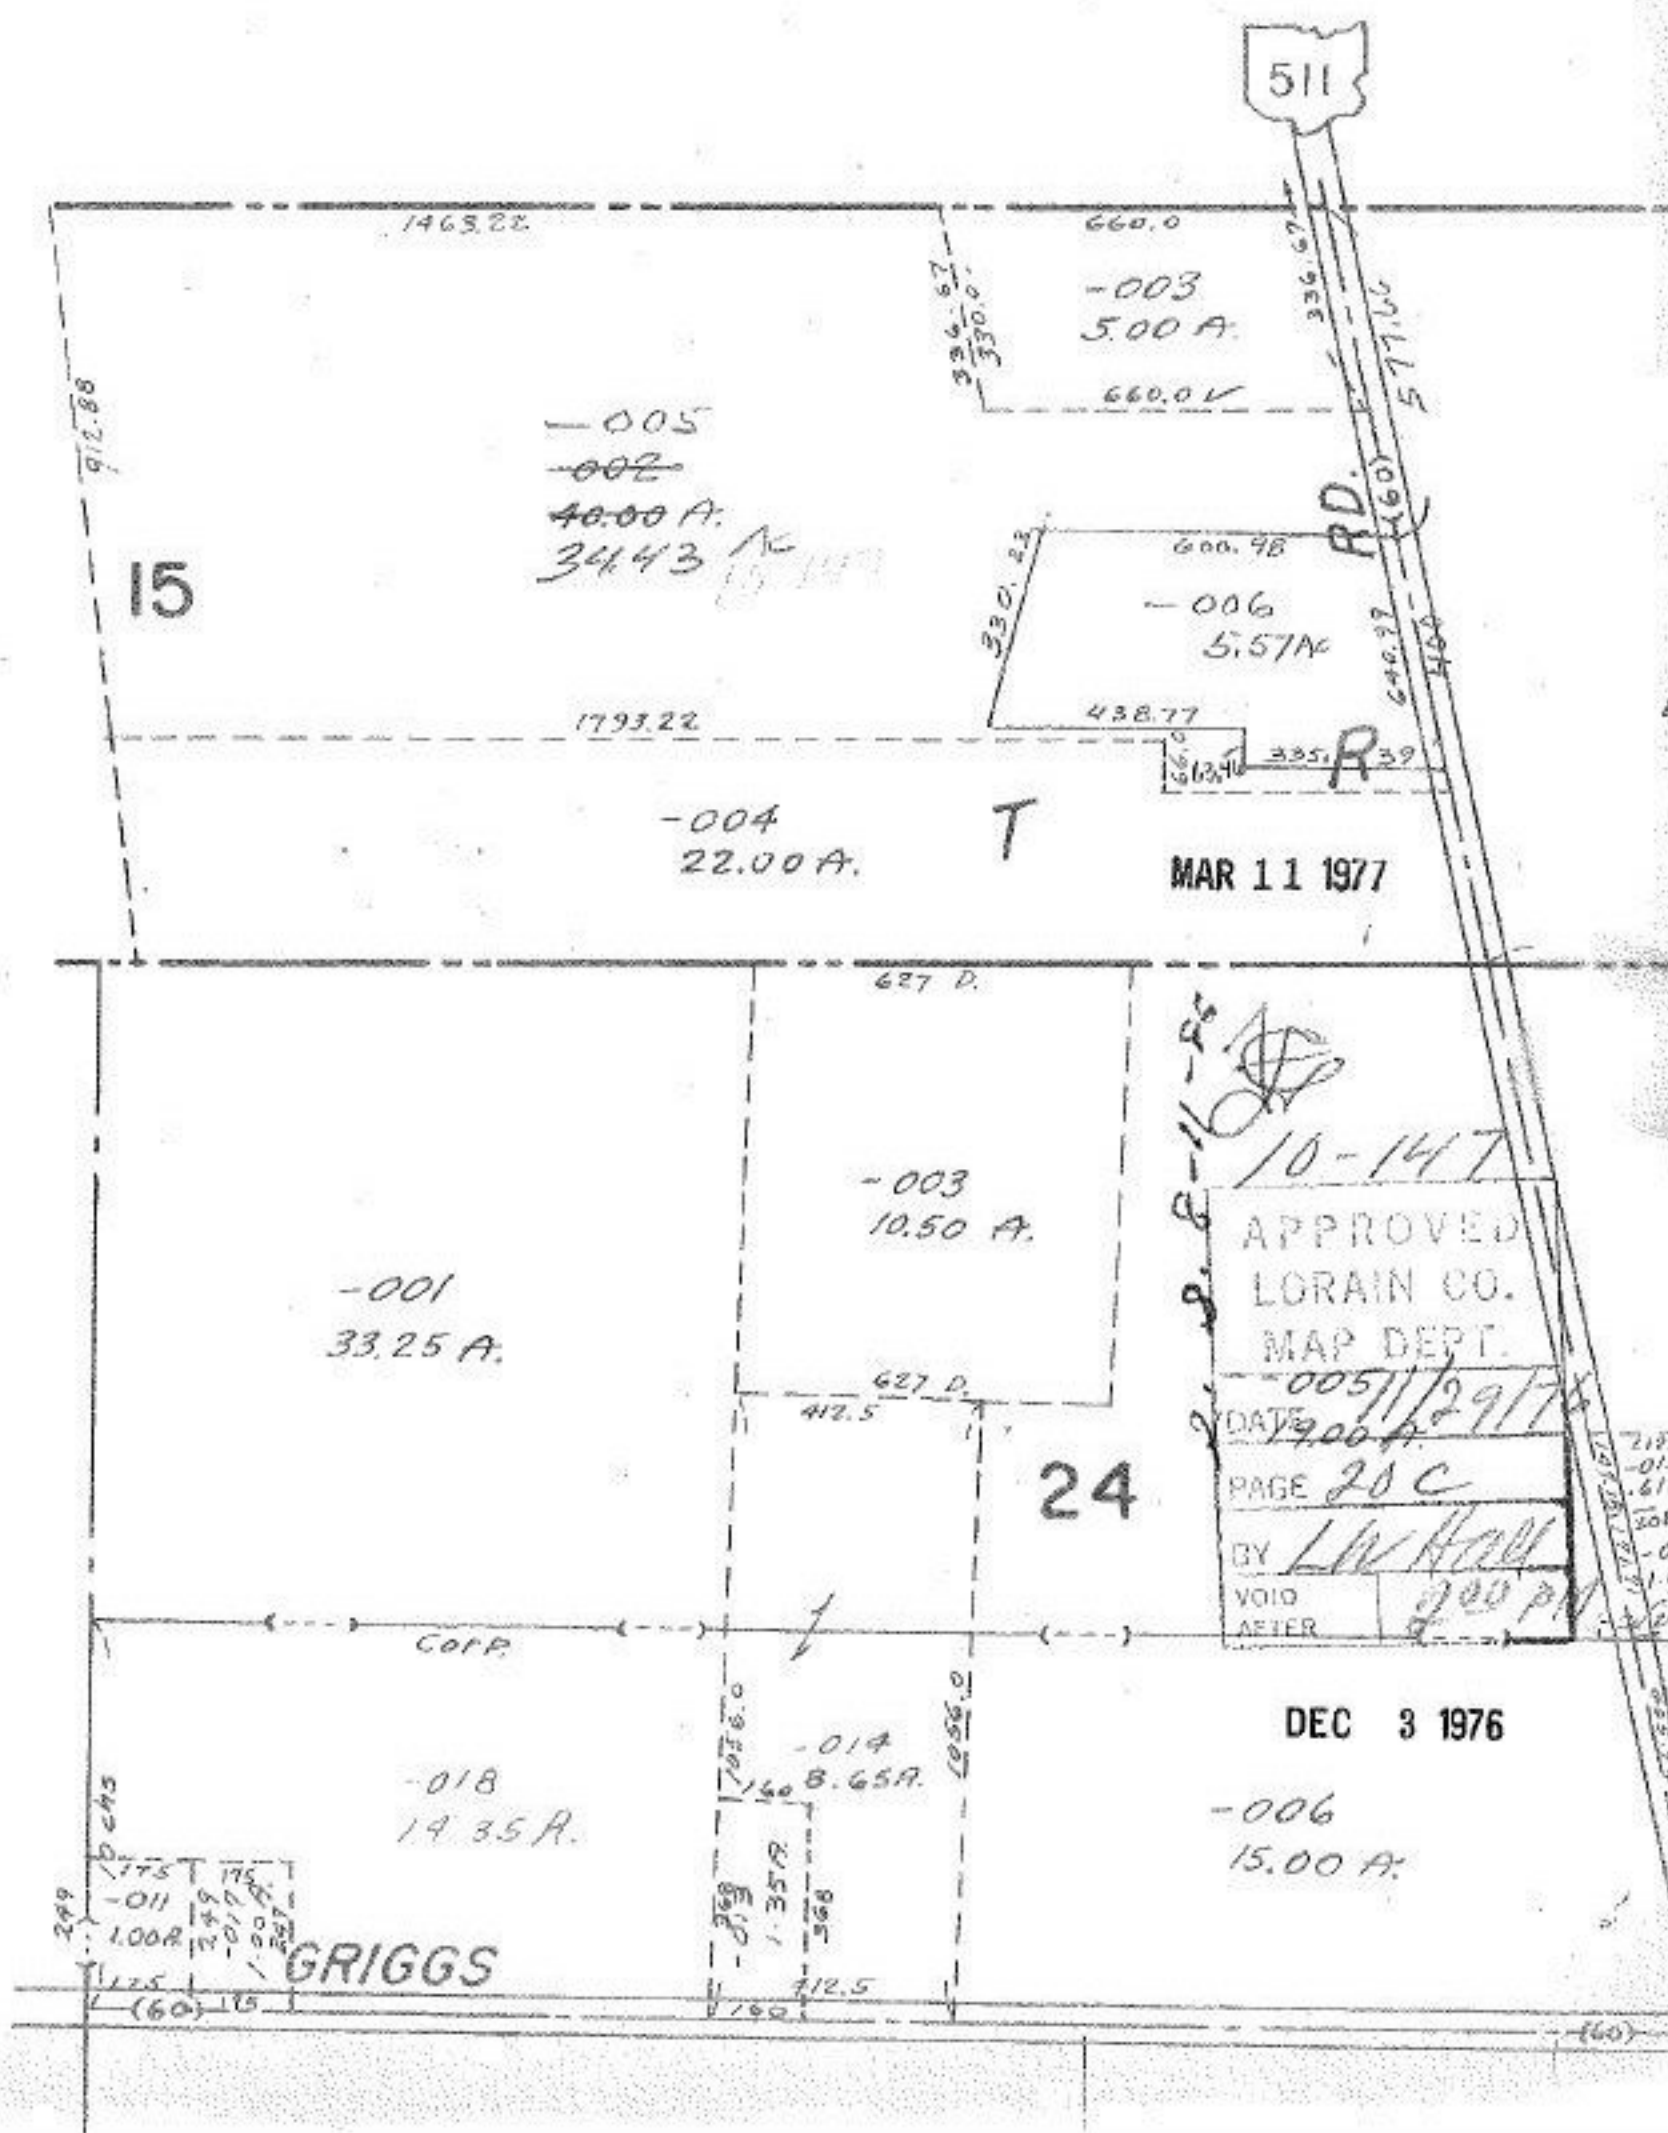

-005
~~-002~~
 40.00 A.
 3443 AC

-003
 5.00 A.
 660.0 V

-006
 5.57 AC

-004
 22.00 A.

MAR 11 1977

-001
 33.25 A.

-003
 10.50 A.

24

-018
 19.35 A.

-014
 8.65 A.

-006
 15.00 A.

APPROVED
 LORAIN CO.
 MAP DEPT.

DATE 005/1/29/77
 9.00 A.

PAGE 20 C

BY LW Hall

VOID AFTER 200 PM

DEC 3 1976

GRIGGS