


10-781

10156

103

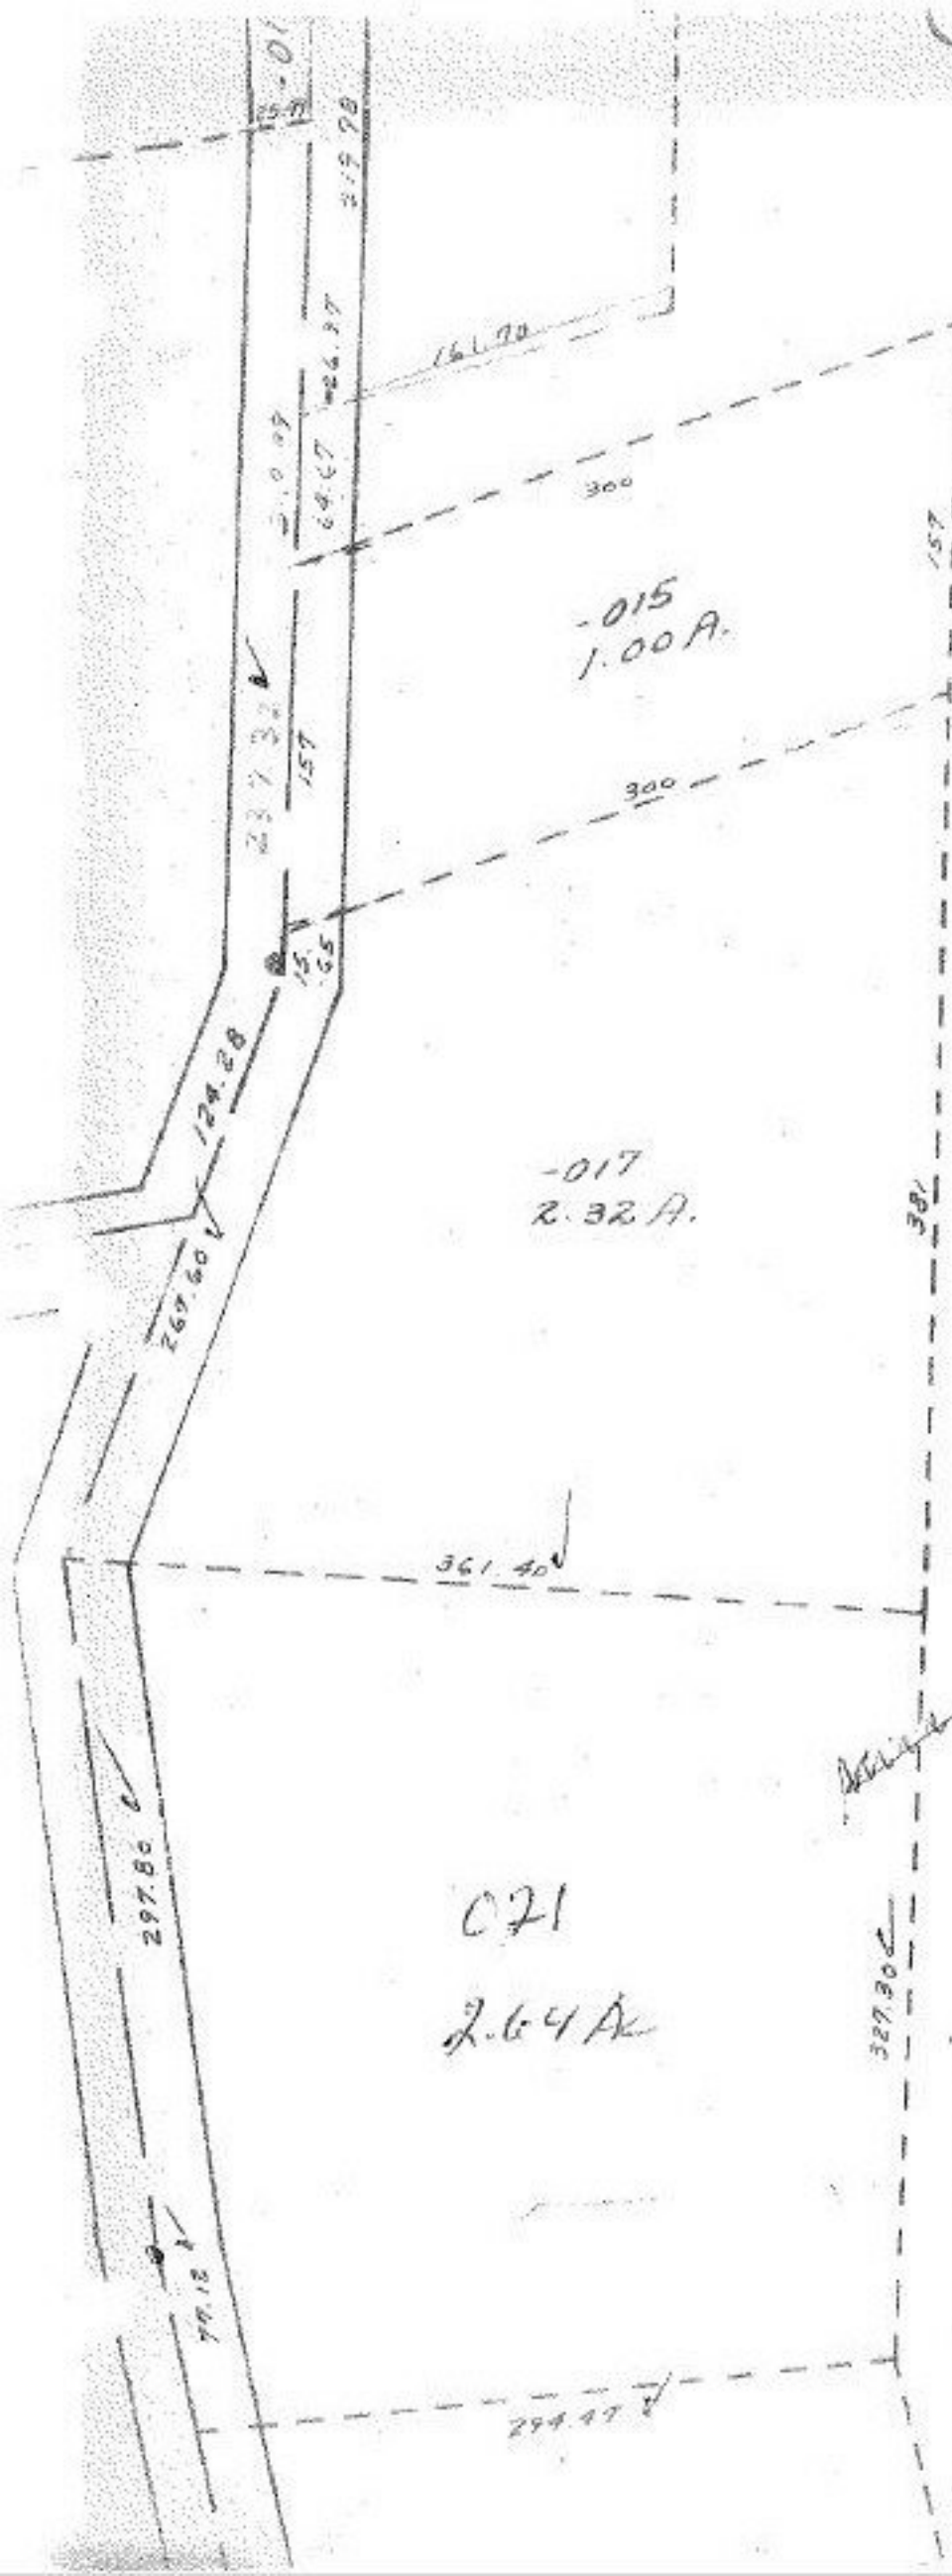

020  
77.22 A.

022  
14.58 AC

-017  
2.32 A.

021  
2.64 A.

*Handwritten note*

10-156

APPROVED	
LORAIN CO.	
MAP DEPT.	
DATE	12/1/76
PAGE	1-00-028 B
BY	L.W. Hall
VOID AFTER	11 00

DEC 3 1976 -013  
*[Signature]* 4.13 A.

APR 1 1977

8-11-86  
 1100  
 AM