


10-168-78 (1)

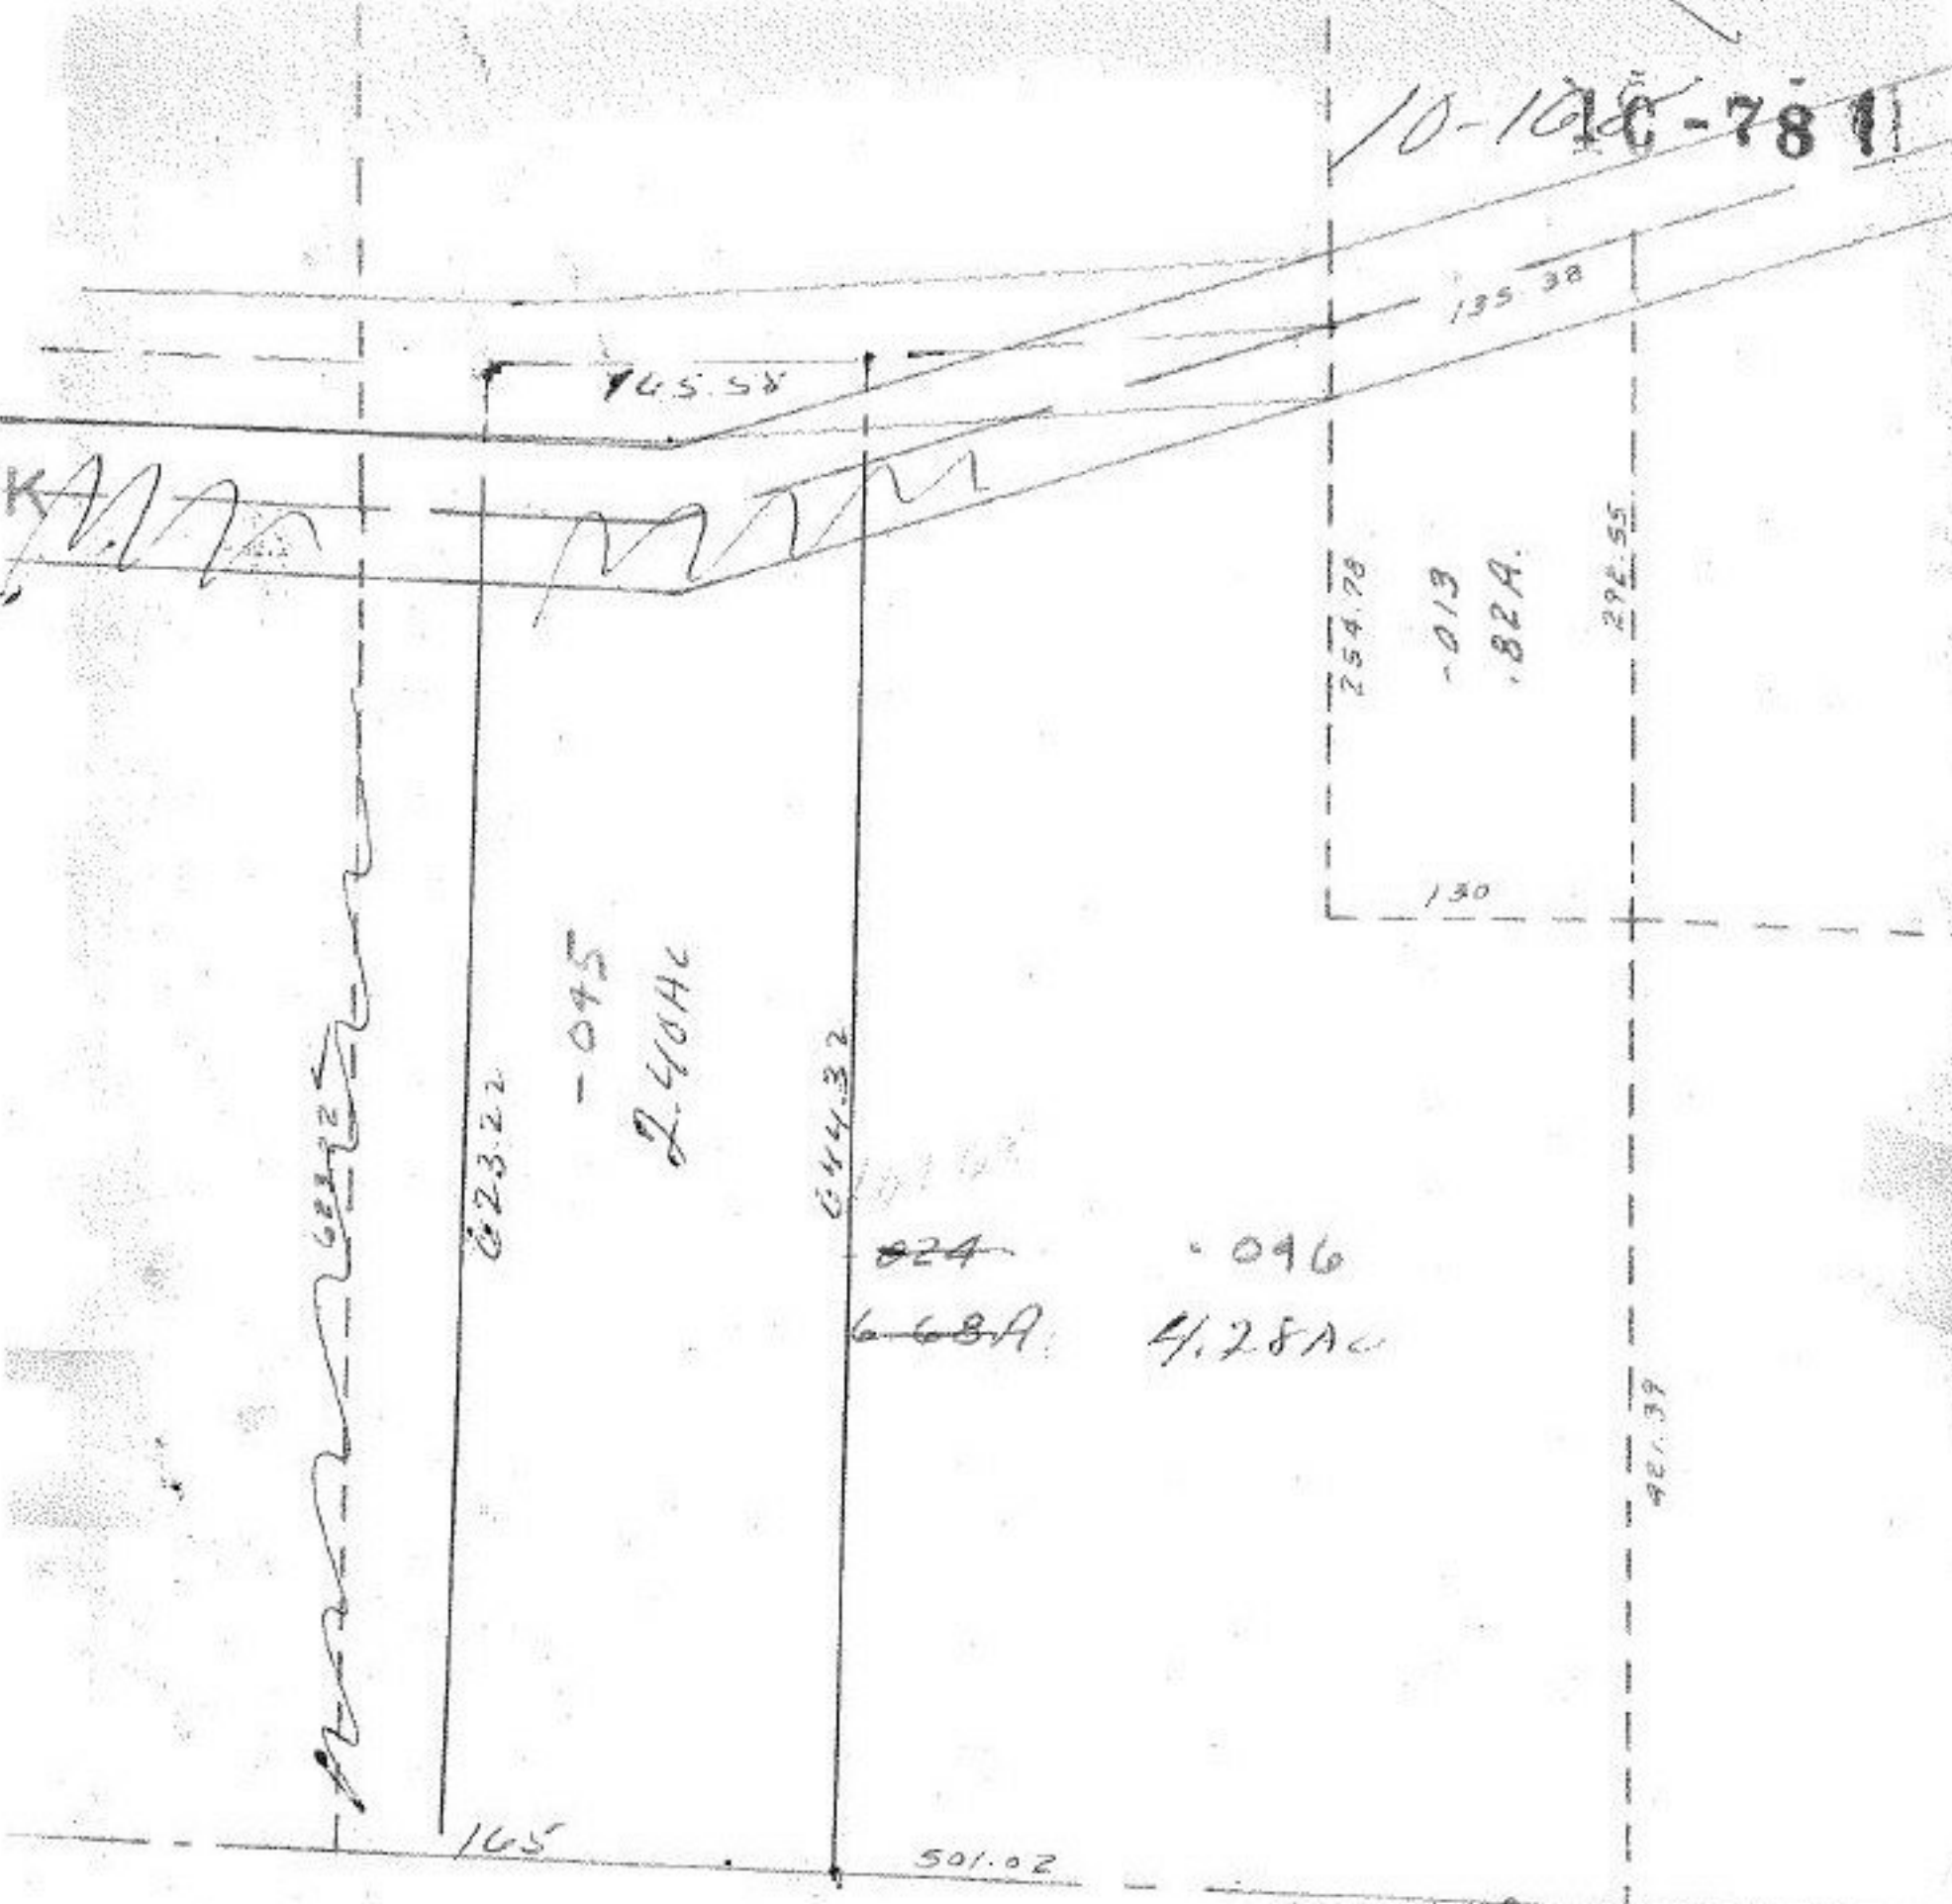

SEE 1-00-038-B

1-00-027B

10-168

APPROVED	
LORAIN CO.	
MAP DEPT.	
DATE	12/6/76
TRCE	1-00-027B
BY	L.V. Hill
VOID AFTER	400 PM

DEC 13 1976
APR 1 1977

HELM TWD