


10-78

~~10-78~~
718

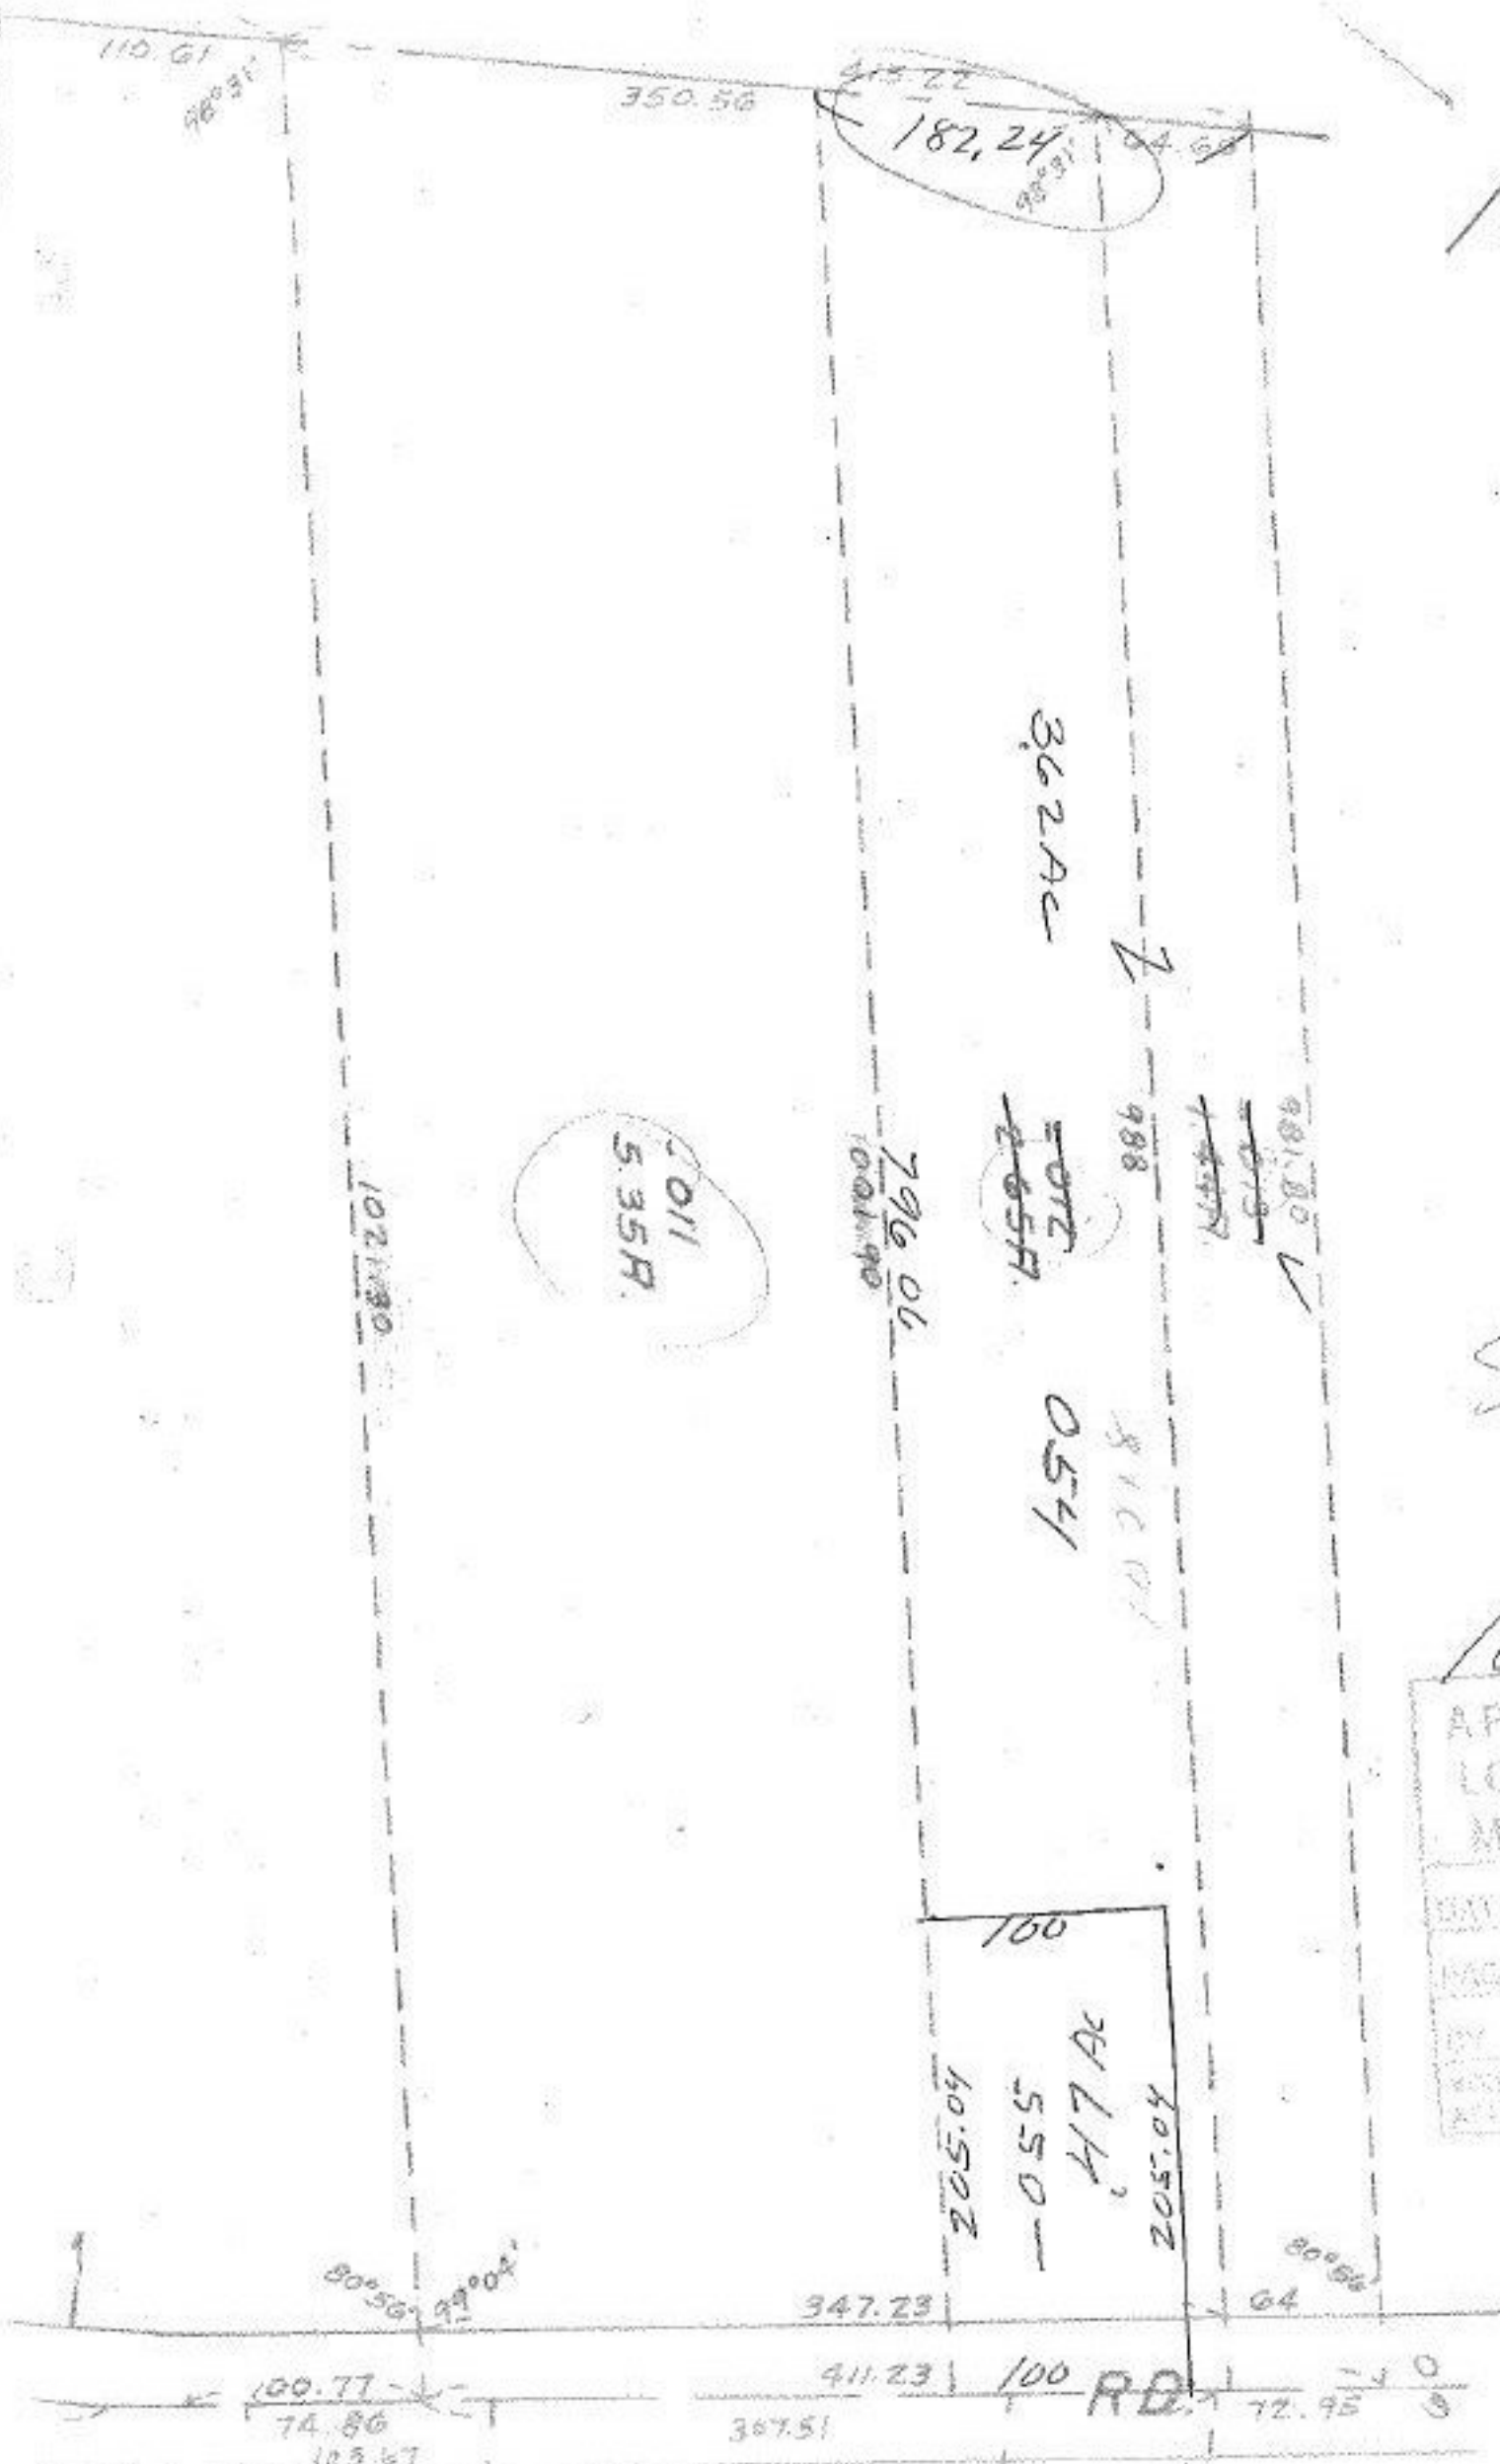

SEE
SURVEY

~~10-78~~
718

APPROVED
LORAIN CO. MS
MAP DEPT. AUG 17 1977

DATE 12/29/76
PAGE 5-00-045A
BY LNHall
3:30 PM

JAN 21 1977