


Pt. - 065  
Pt. 9.41A.

10-227

L. 10-78

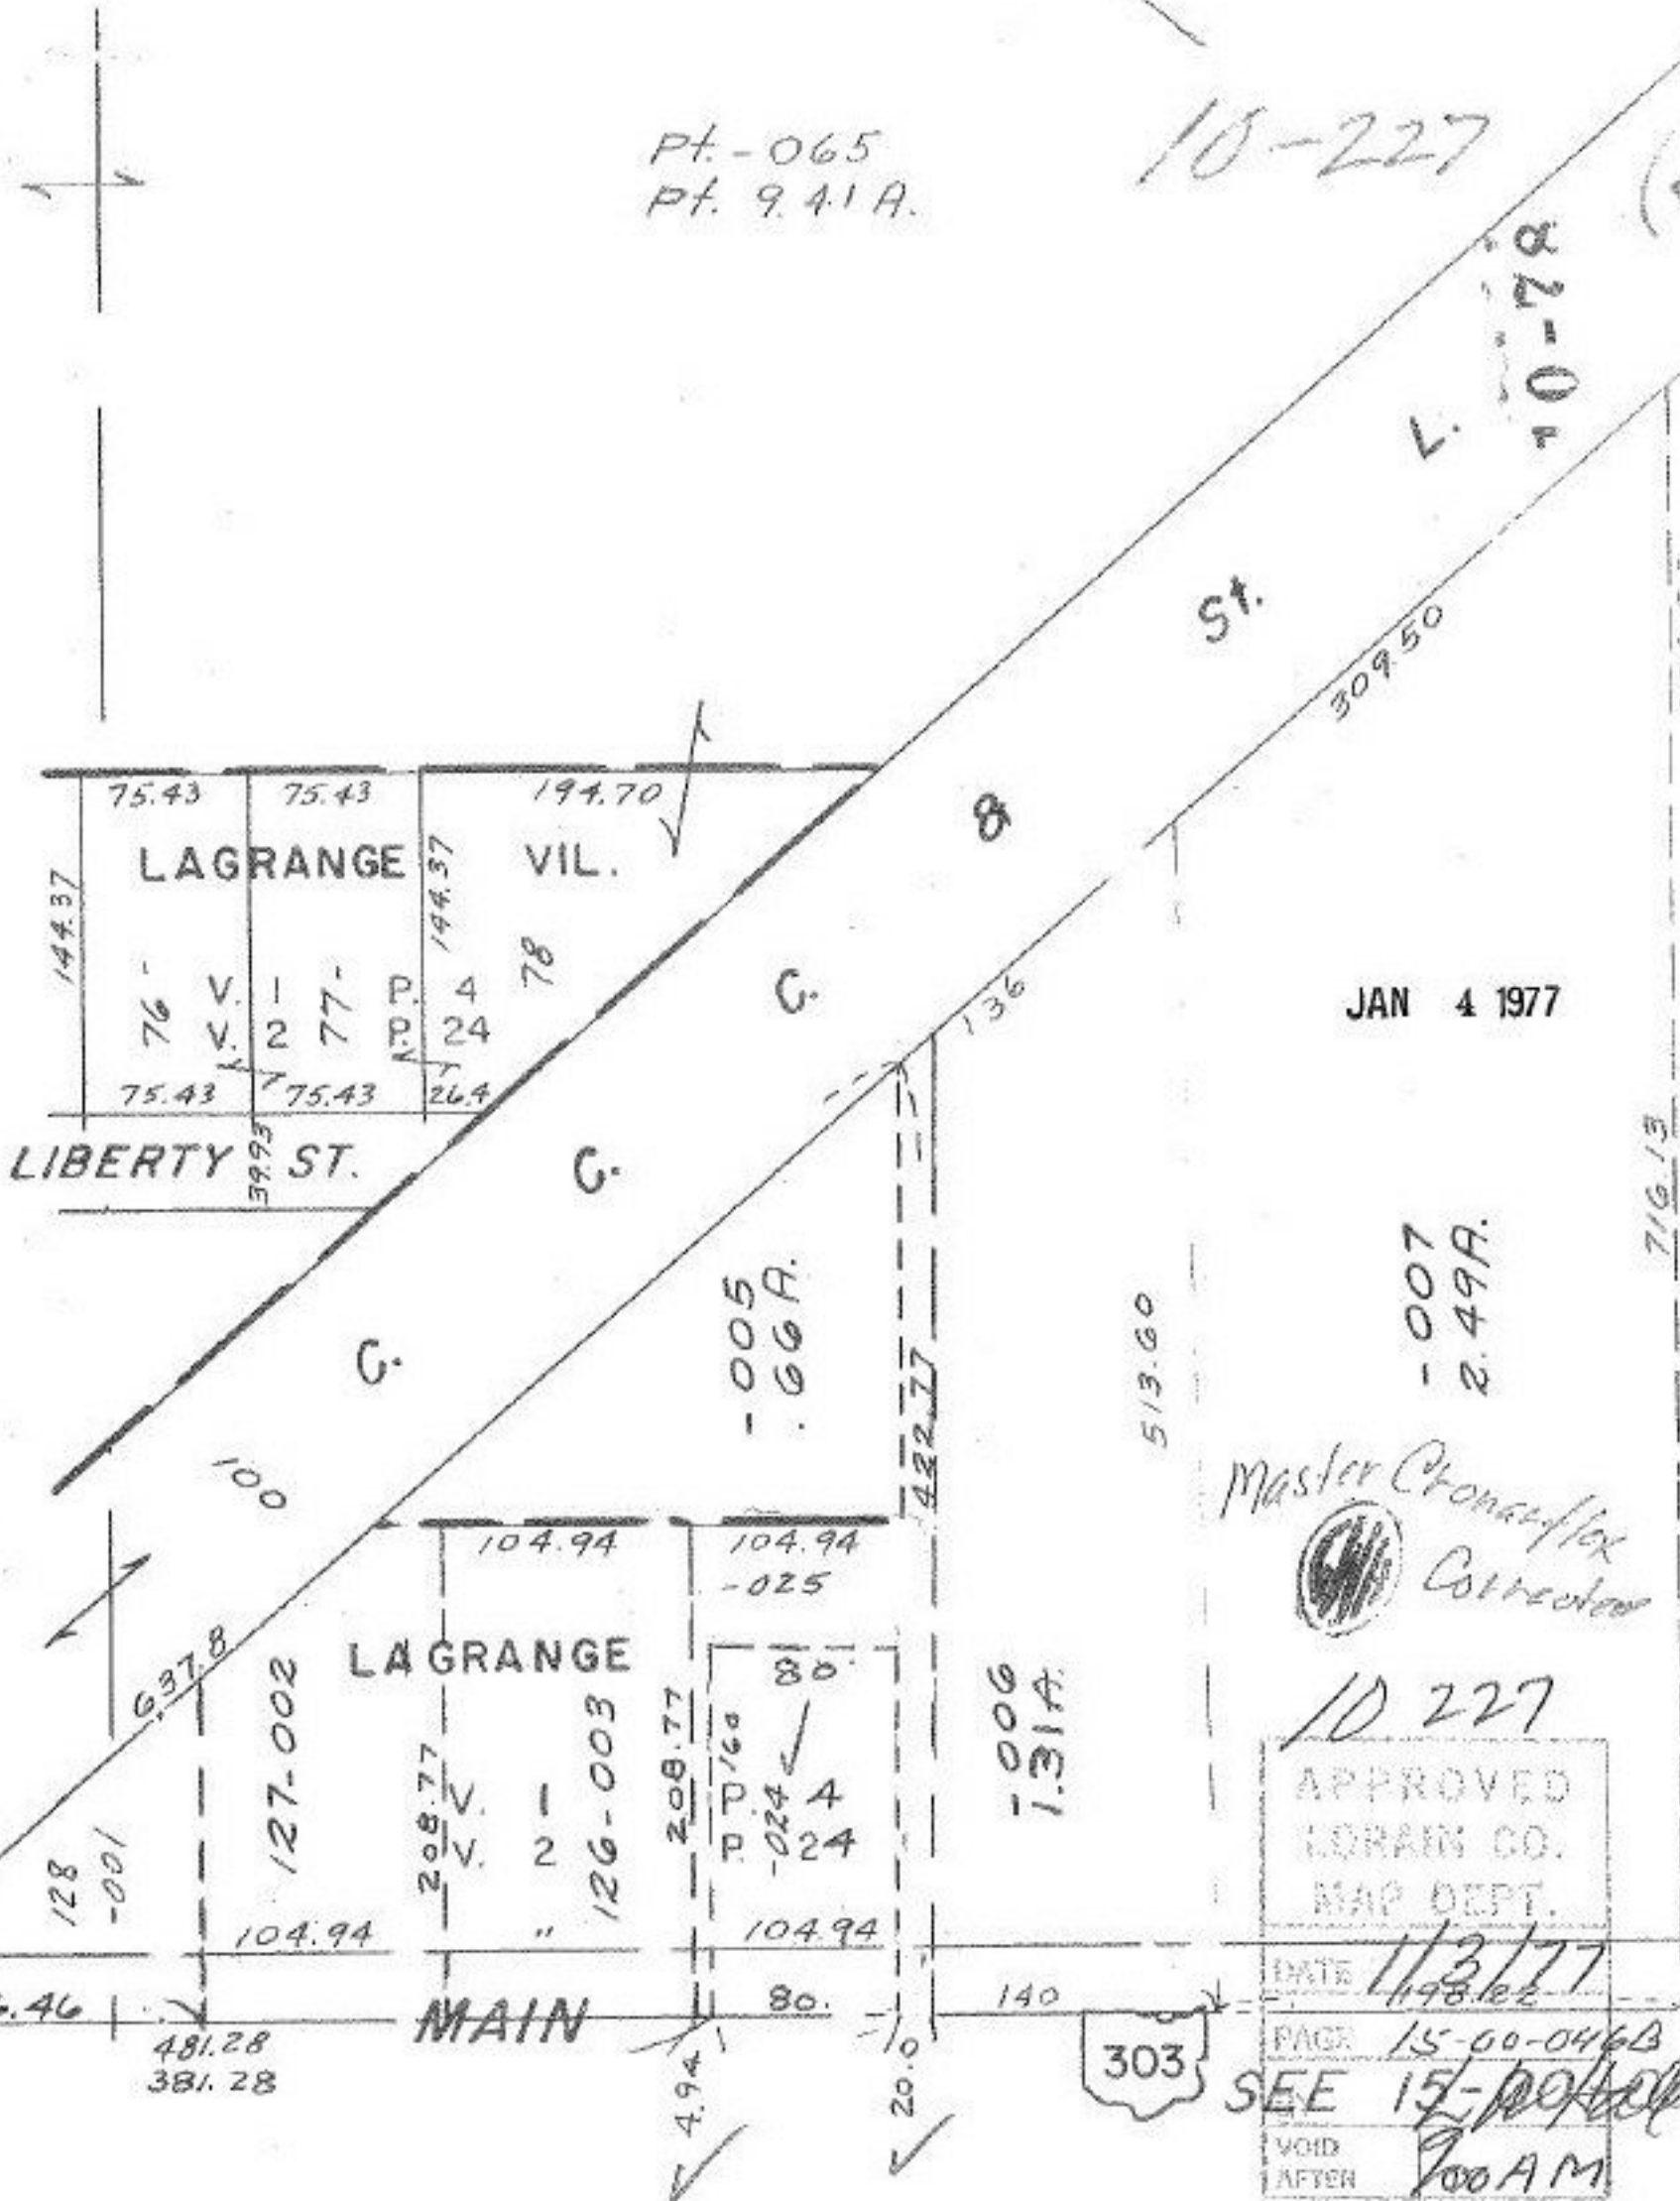

JAN 4 1977

-007  
2.49A.

Master Chronoflex  
Collector

10 227

APPROVED  
MORAN CO.  
MAP DEPT.

DATE 1/3/77  
1198.122

PAGE 15-00-046B

SEE 15-10-100  
VOID AFTER 9:00 AM

# LAGRANGE TWP.

SCALE: 1" = 100'