

121

1105.80

#10242

APPROVED
LORAIN CO.
MAP DEPT.
DATE 1-7-77
PAGE 10-00-003 F
BY <i>J. Dolan</i>
VOID AFTER

JAN 28 1977

[Signature]


JAN 11 1977

Pt. 10-00-003-121-002

Pt. 18.00 Ft.

613.18
179.13
434.05

100
56.72
13.28
1.39
36
1.05

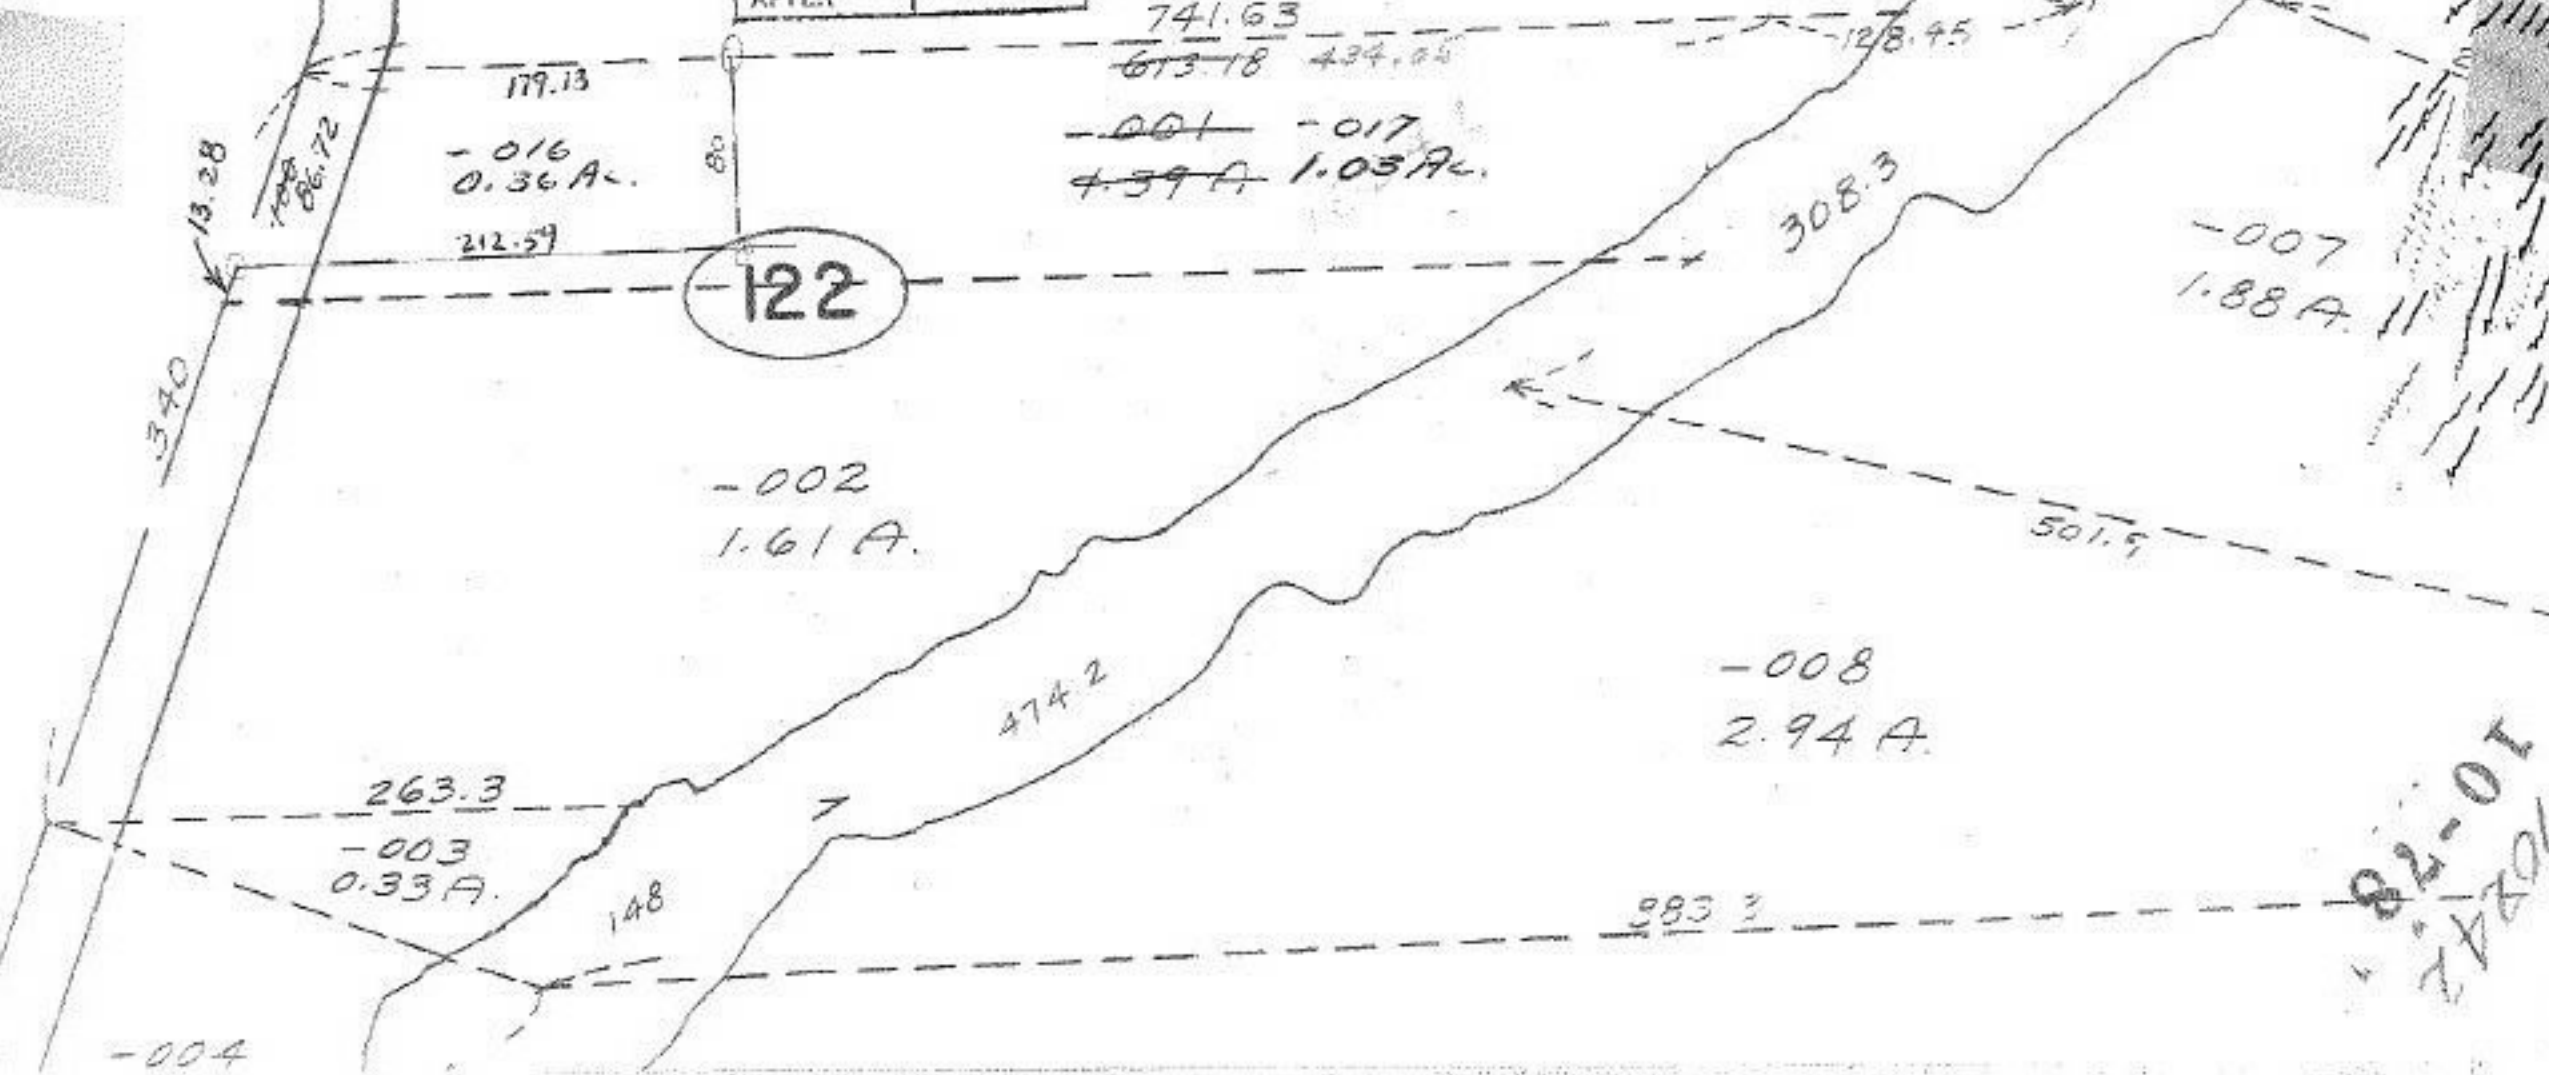

82-01
10242
10-28