

SEE

SEE

10-78

SEE

10-255

100	-001	100
	.68F.	
100	-002	100
	.68F.	
300		

#10293

APPROVED
LORAIN CO.
MAP DEPT.

FEB 11 1977

39

APR 1 1977

DATE 2-11-77

PAGE 1-H

BY *J. Hall*

VOID
AFTER


-011
50 90 A.

2.14
1.50
1.14

0.33
61.55 F.

7.21
1.14
6.07

6.07
2.14
8.21
1.14
9.35

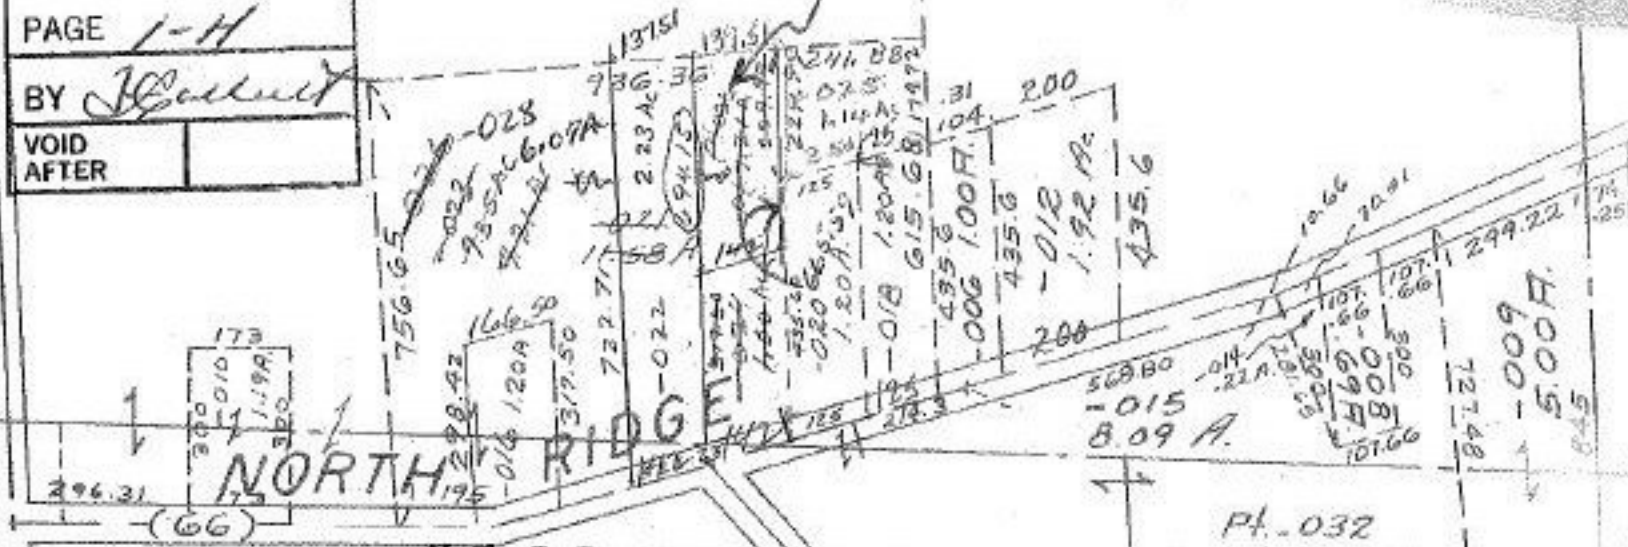

#10255

APPROVED
LORAIN CO.
MAP DEPT.

JAN 14 1977

APR 1 1977

DATE 1-13-77

PAGE 1-H

BY *J. W. Hall*

VOID
AFTER

