


10-266
10-269
84-48

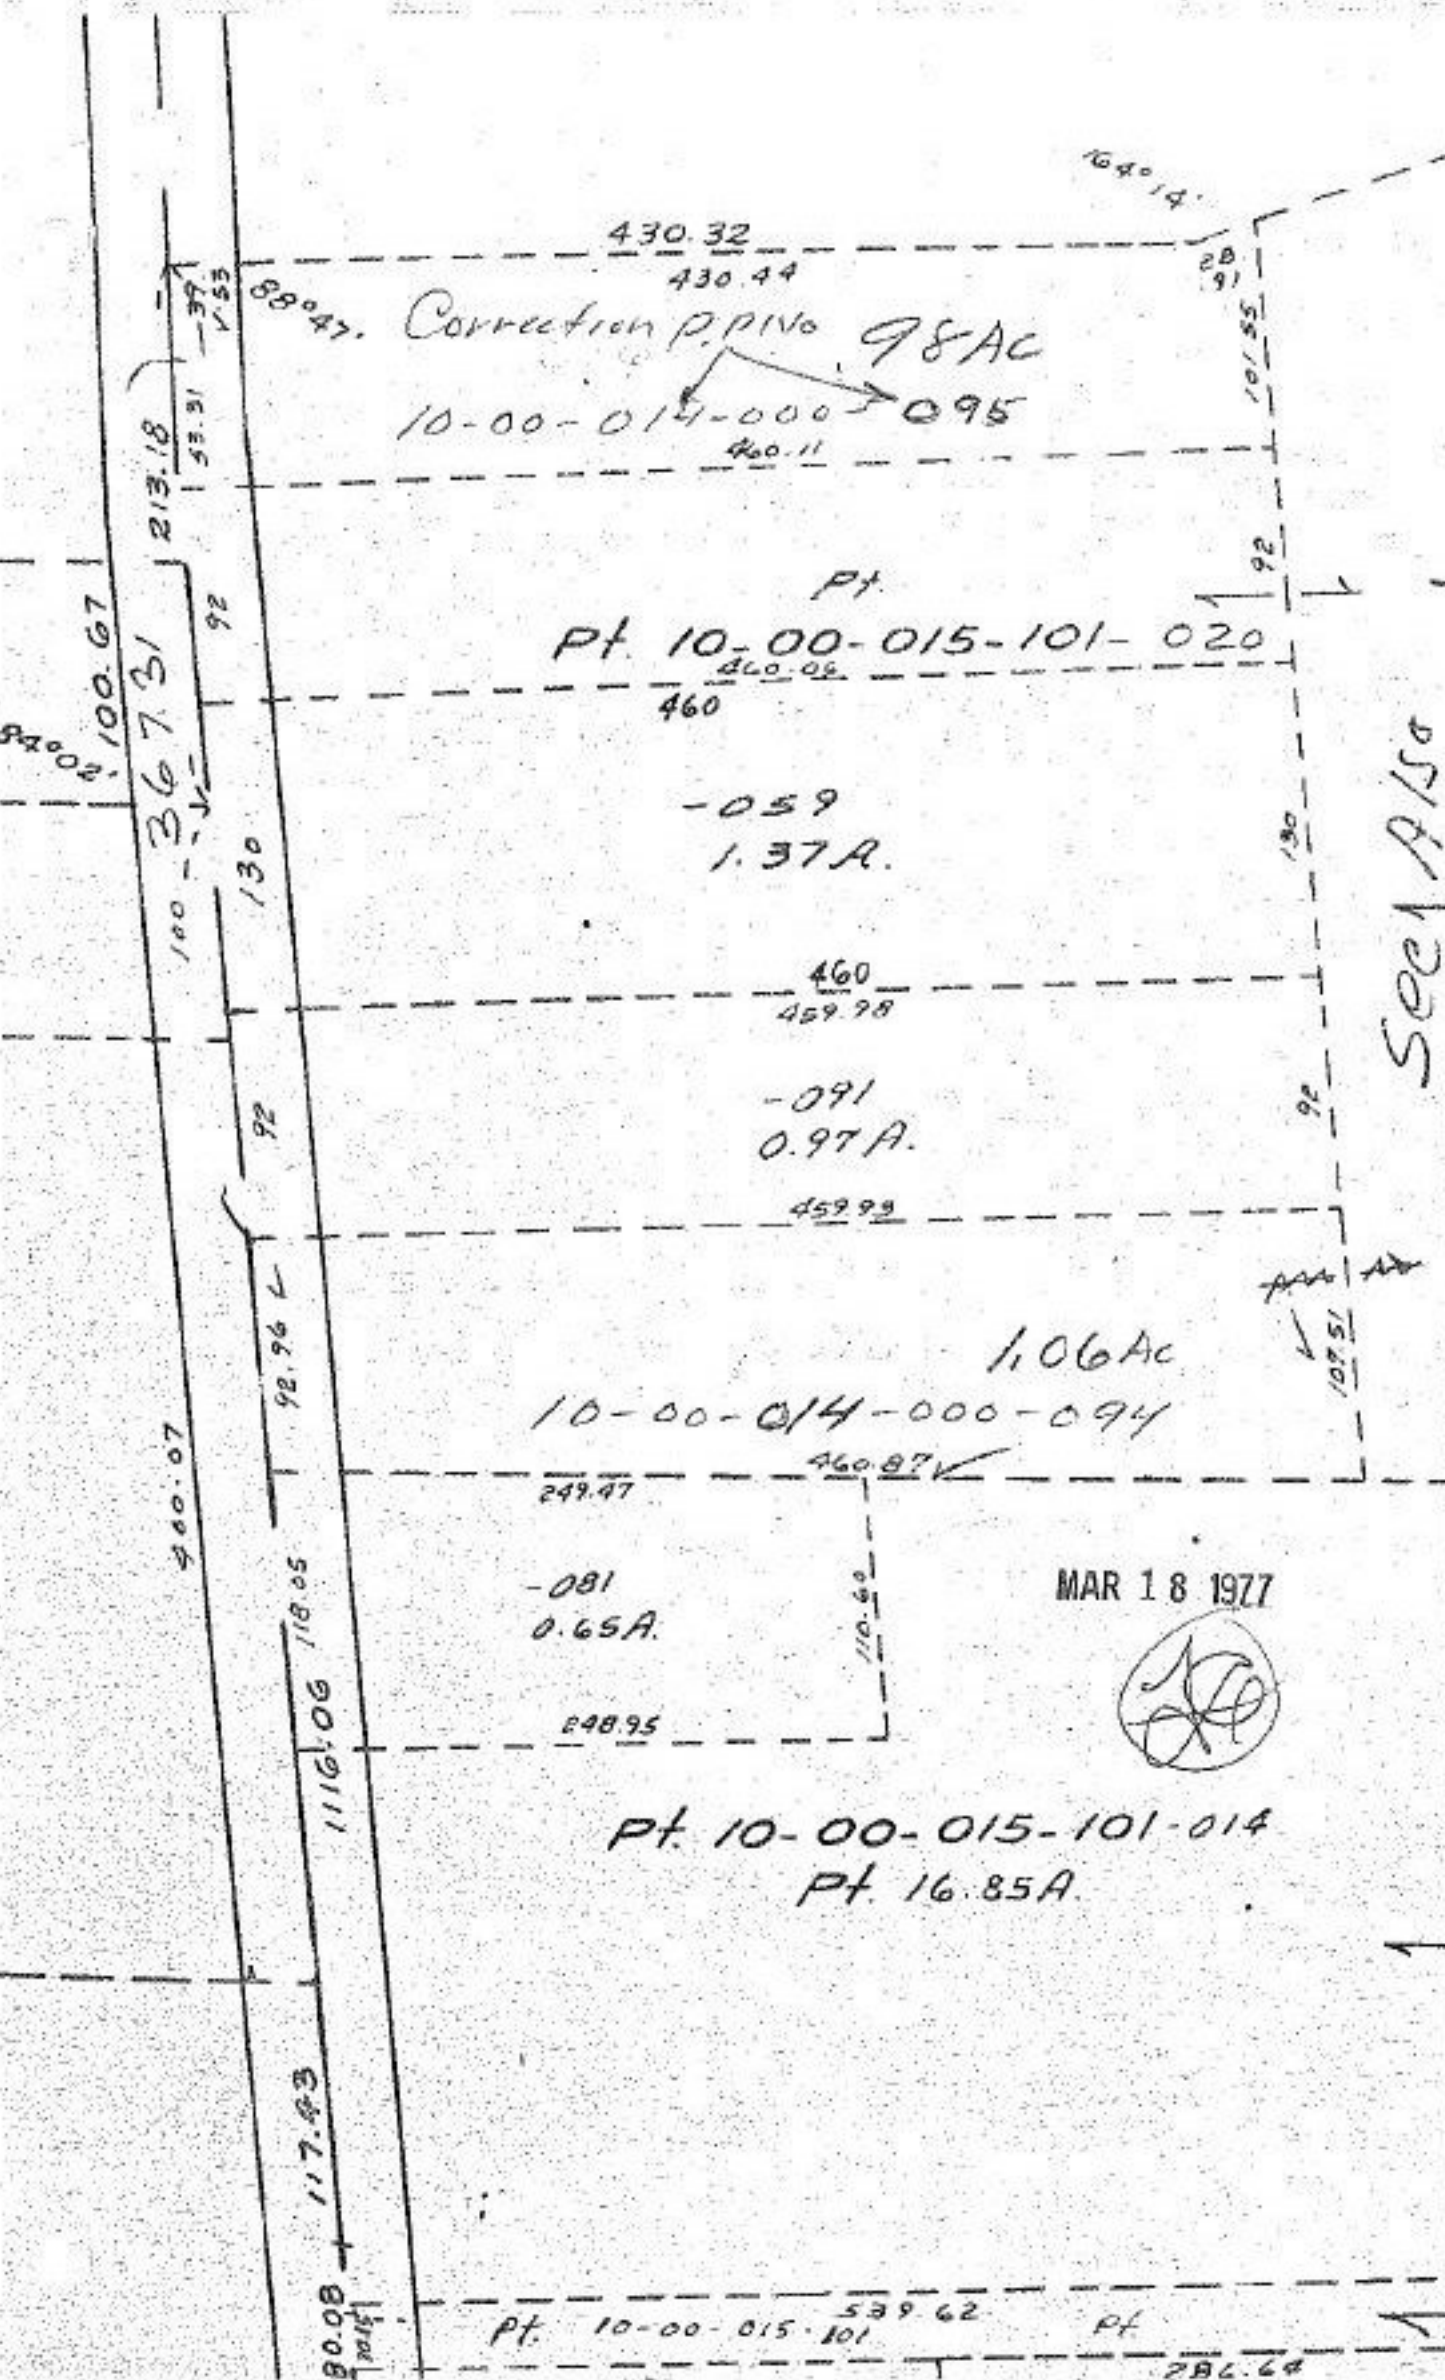

See 1 A/50
10-00-015A
On 25.62 AC
P.P. No will be
10-00-015-101-020
Tax Map P. 10-00-015 A

10-269
10-266

APPROVED
CORAIN CO.
MAP DEPT.
DATE 1/25/77
PAGE 10-00-014D
10-00-015A
BY L. W. Hall
VOID AFTER 3:30 PM

JAN 25 1977
JAN 26 1977
1-26-77