


10-275  
10-781

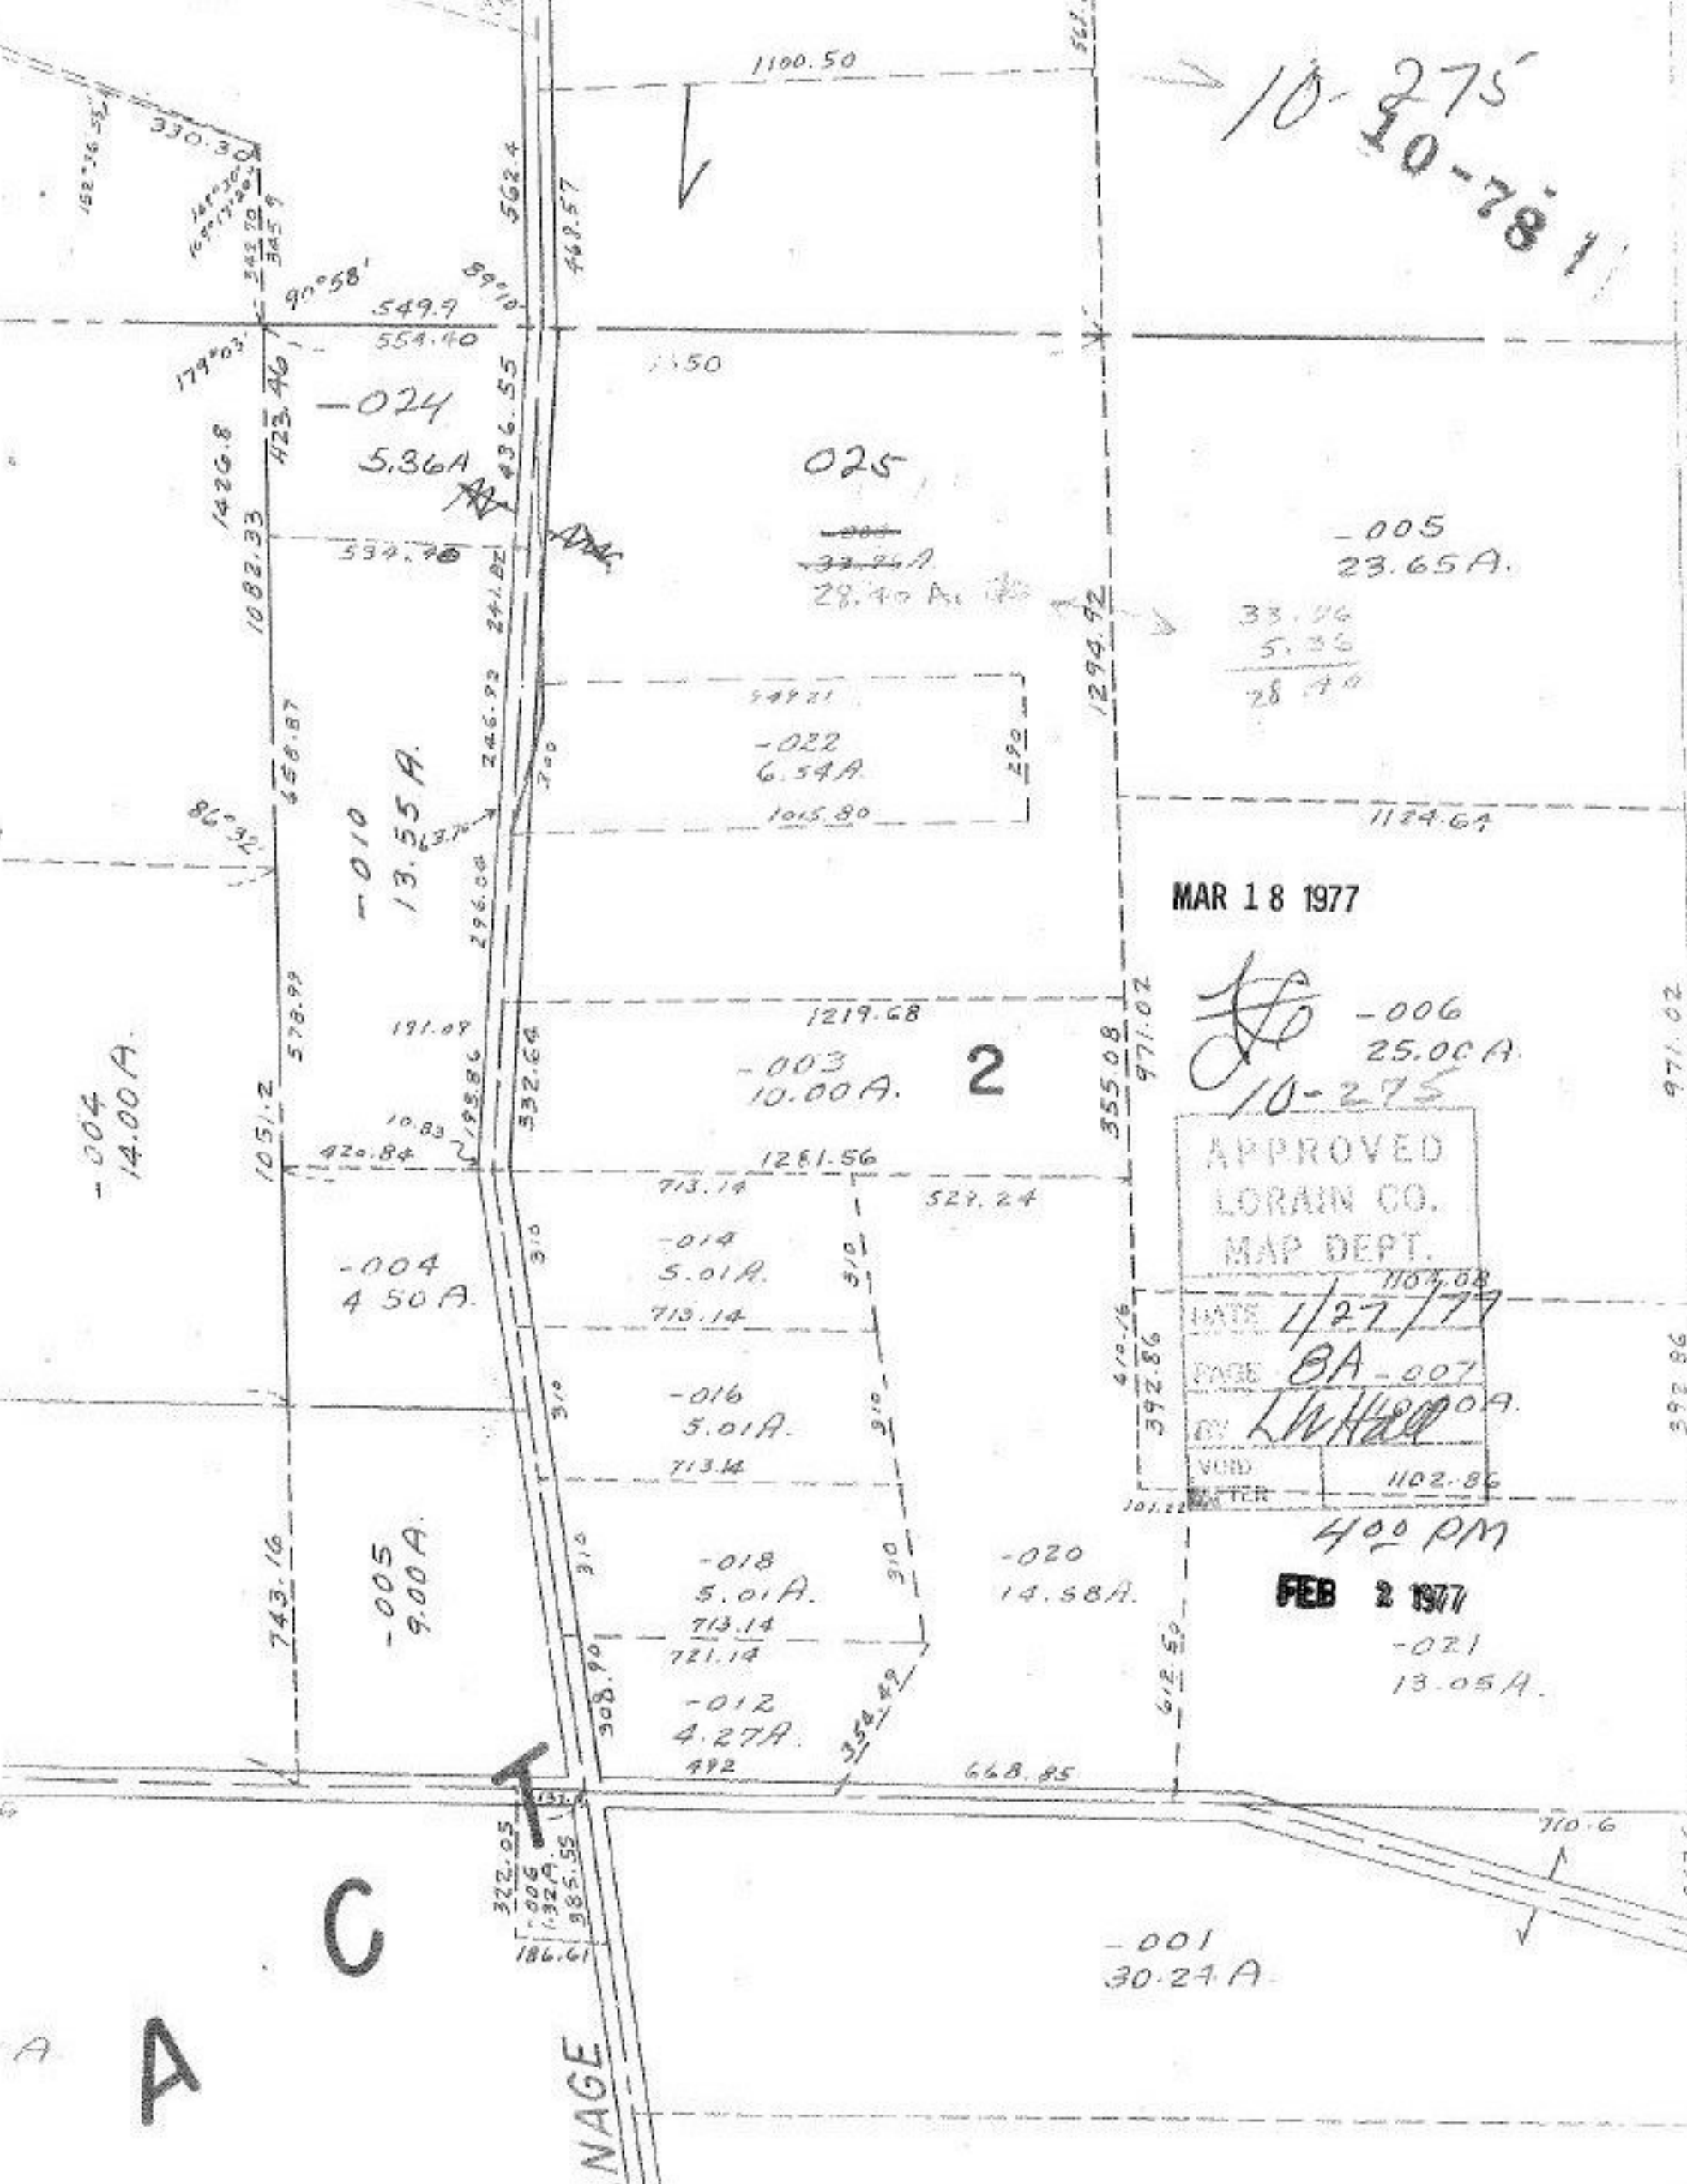

-024  
5.36A

025

-005  
23.65A.

33.06  
5.36  
28.70

-010  
13.55A.

-022  
6.54A

MAR 18 1977

-003  
10.00A.

2

-006  
25.00A.

APPROVED  
LORAIN CO.  
MAP DEPT.

-004  
4.50A.

-014  
5.01A.

DATE 1/27/77  
PAGE BA-007  
BY L.W.H.

-016  
5.01A.

VOID WATER 1102.86

-005  
9.00A.

-018  
5.01A.

-020  
14.58A.

FEB 2 1977

-012  
4.27A.

-021  
13.05A.

-001  
30.27A.

A A

C

ANAGE