


SEE 11-A

10-279  
10-278

941.96  
ST. JO. MAP 06 74

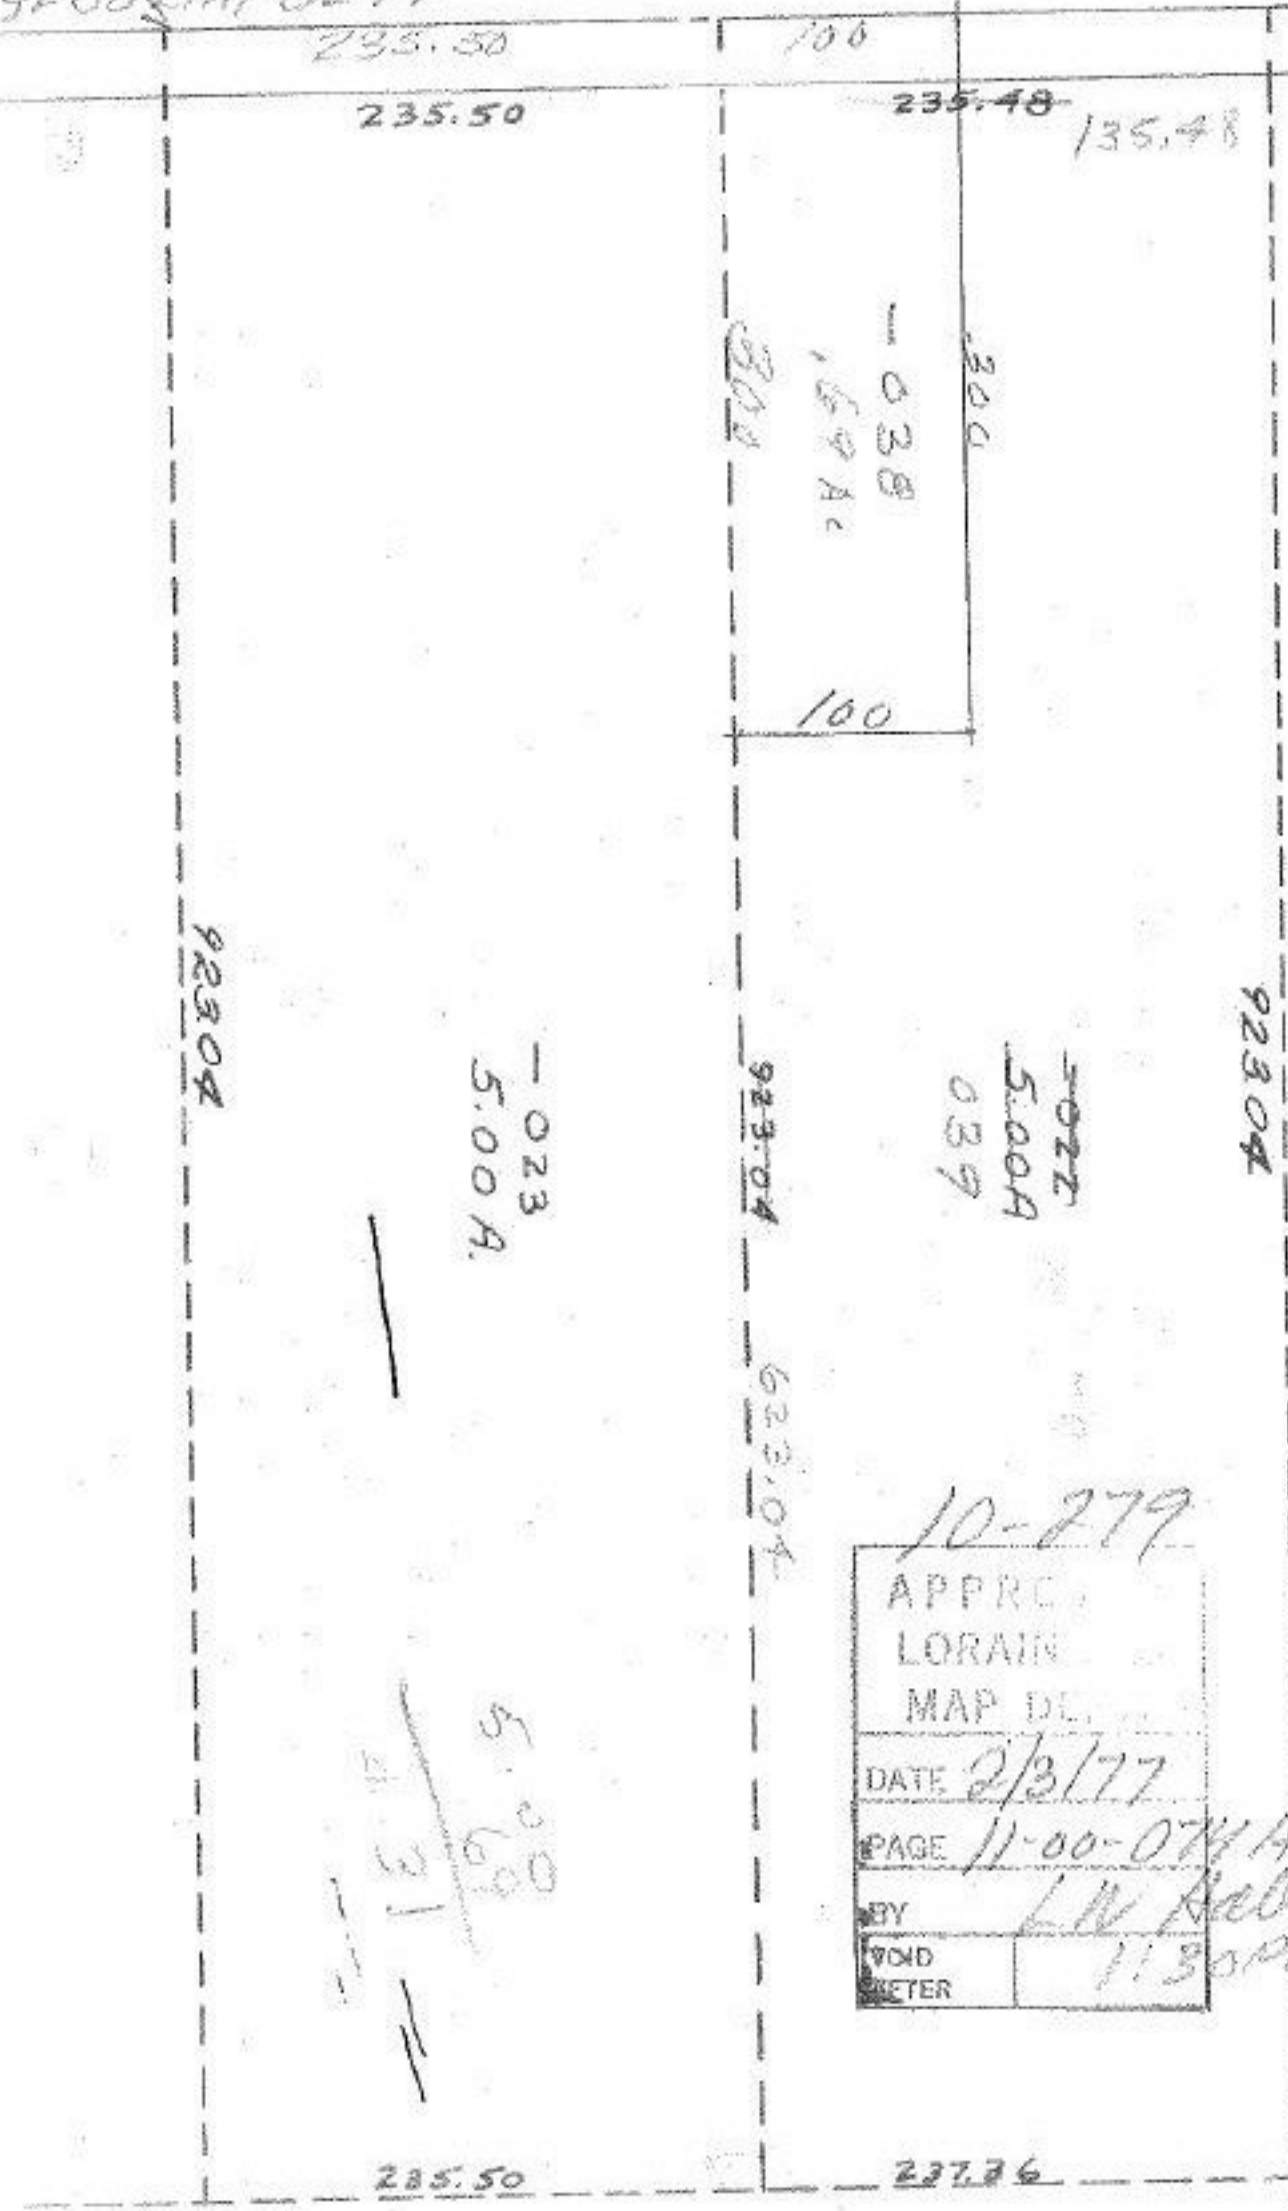

235.48

MAR 18 1977

FEB 24 1977

10-279

APPROX.
LORAIN
MAP DE.
DATE 2/3/77
PAGE 11-00-074A
BY L.W. Bell
VOID METER 11:30 PM

5.000  
0.23  
0.39