


18

MEDINA - NORWALK

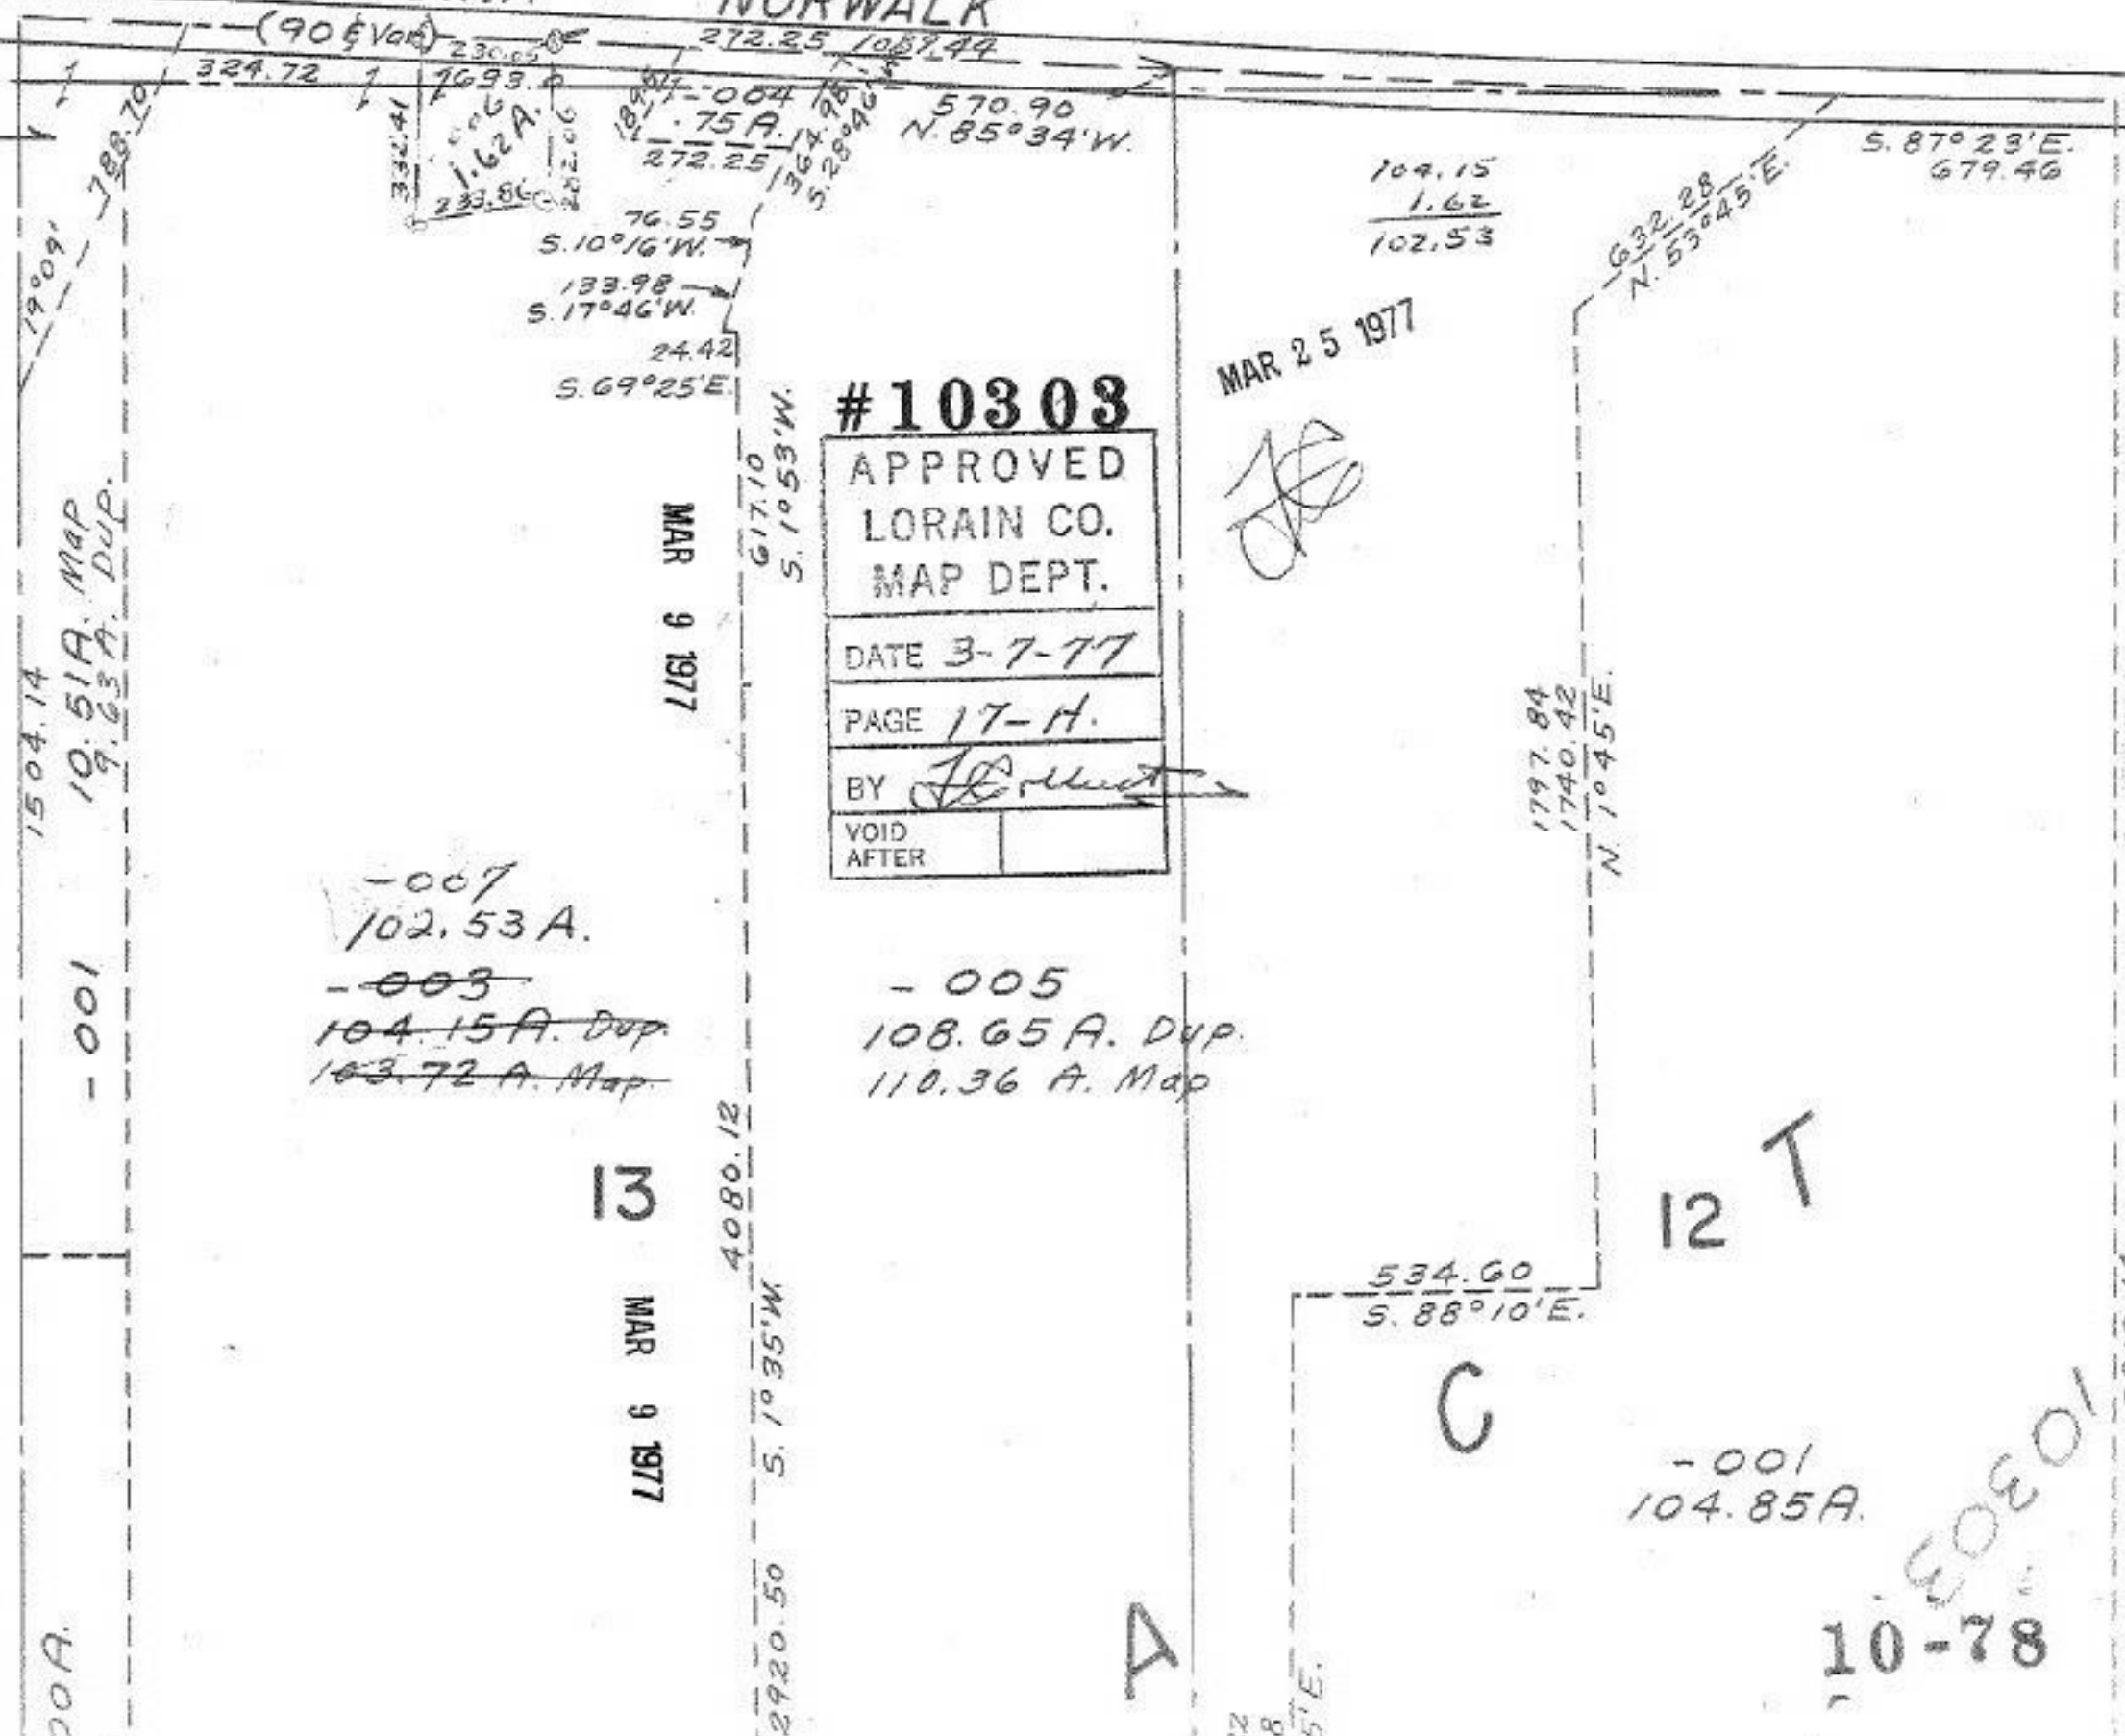

#10303

APPROVED
LORAIN CO.
MAP DEPT.

DATE 3-7-77

PAGE 17-H.

BY *J. D. ...*

VOID AFTER

MAR 25 1977

MAR 9 1977

13

MAR 9 1977

12 T

C

A

~~-007~~
102.53 A.

~~-003~~
104.15 A. Dup.
103.72 A. Map.

-005
108.65 A. Dup.
110.36 A. Map

-001
104.85 A.

10-78

10303

3913.14 - 002 10.00 A.