

-001
6.00 A

103

-002
0.00 A

-040
60.58 A

-002
30.00 A

#10307

APPROVED
LORAIN CO.
MAP DEPT.

DATE 2-16-77

PAGE 7-A

BY *Lorain*

VOID
AFTER

MAR 18 1977


FEB 17 1977

OTTEN 044-D

7-00

SEE

041
043
6 x 30

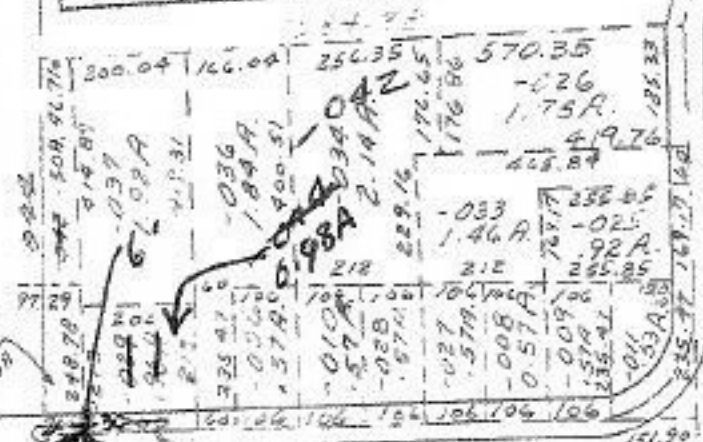

41

1400
-018
11.72 A.

1466.90

-017
11.72 A.

1540

-013

63.29 A.

LOG #
1877.02

400.0