


#10325

-008
15.77A
218.10

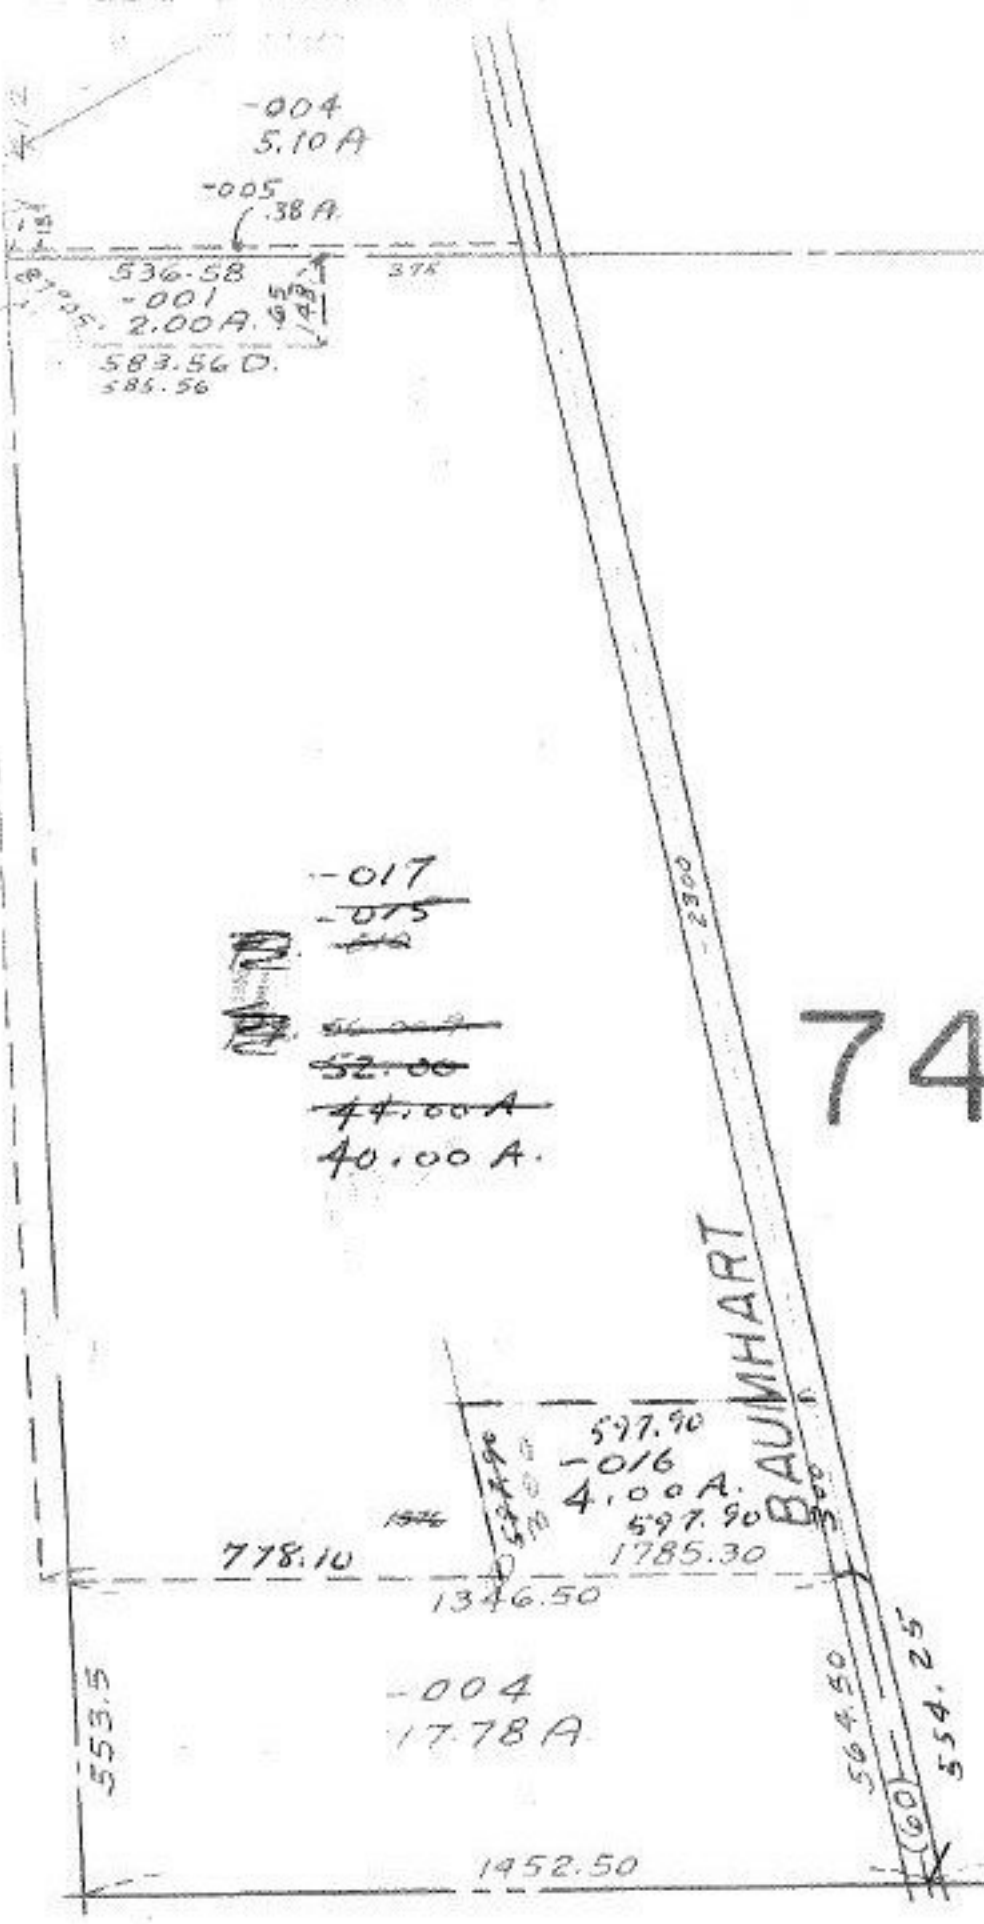

-017
-015
~~52.00~~
~~44.00A~~
40.00A

1-00-074-B

SEE

1376
597.90
778.10

#10325

APPROVED
LORAIN CO.
MAP DEPT.

DATE 3-3-77

PAGE 1-L

BY *[Signature]*

VOID AFTER

MAR 4 1977
APR 1 1977

[Signature]

Oler

PROWNHELM TWP.

SCALE: 1" = 400'