


BLAKE

FORU #10327 ST. 31

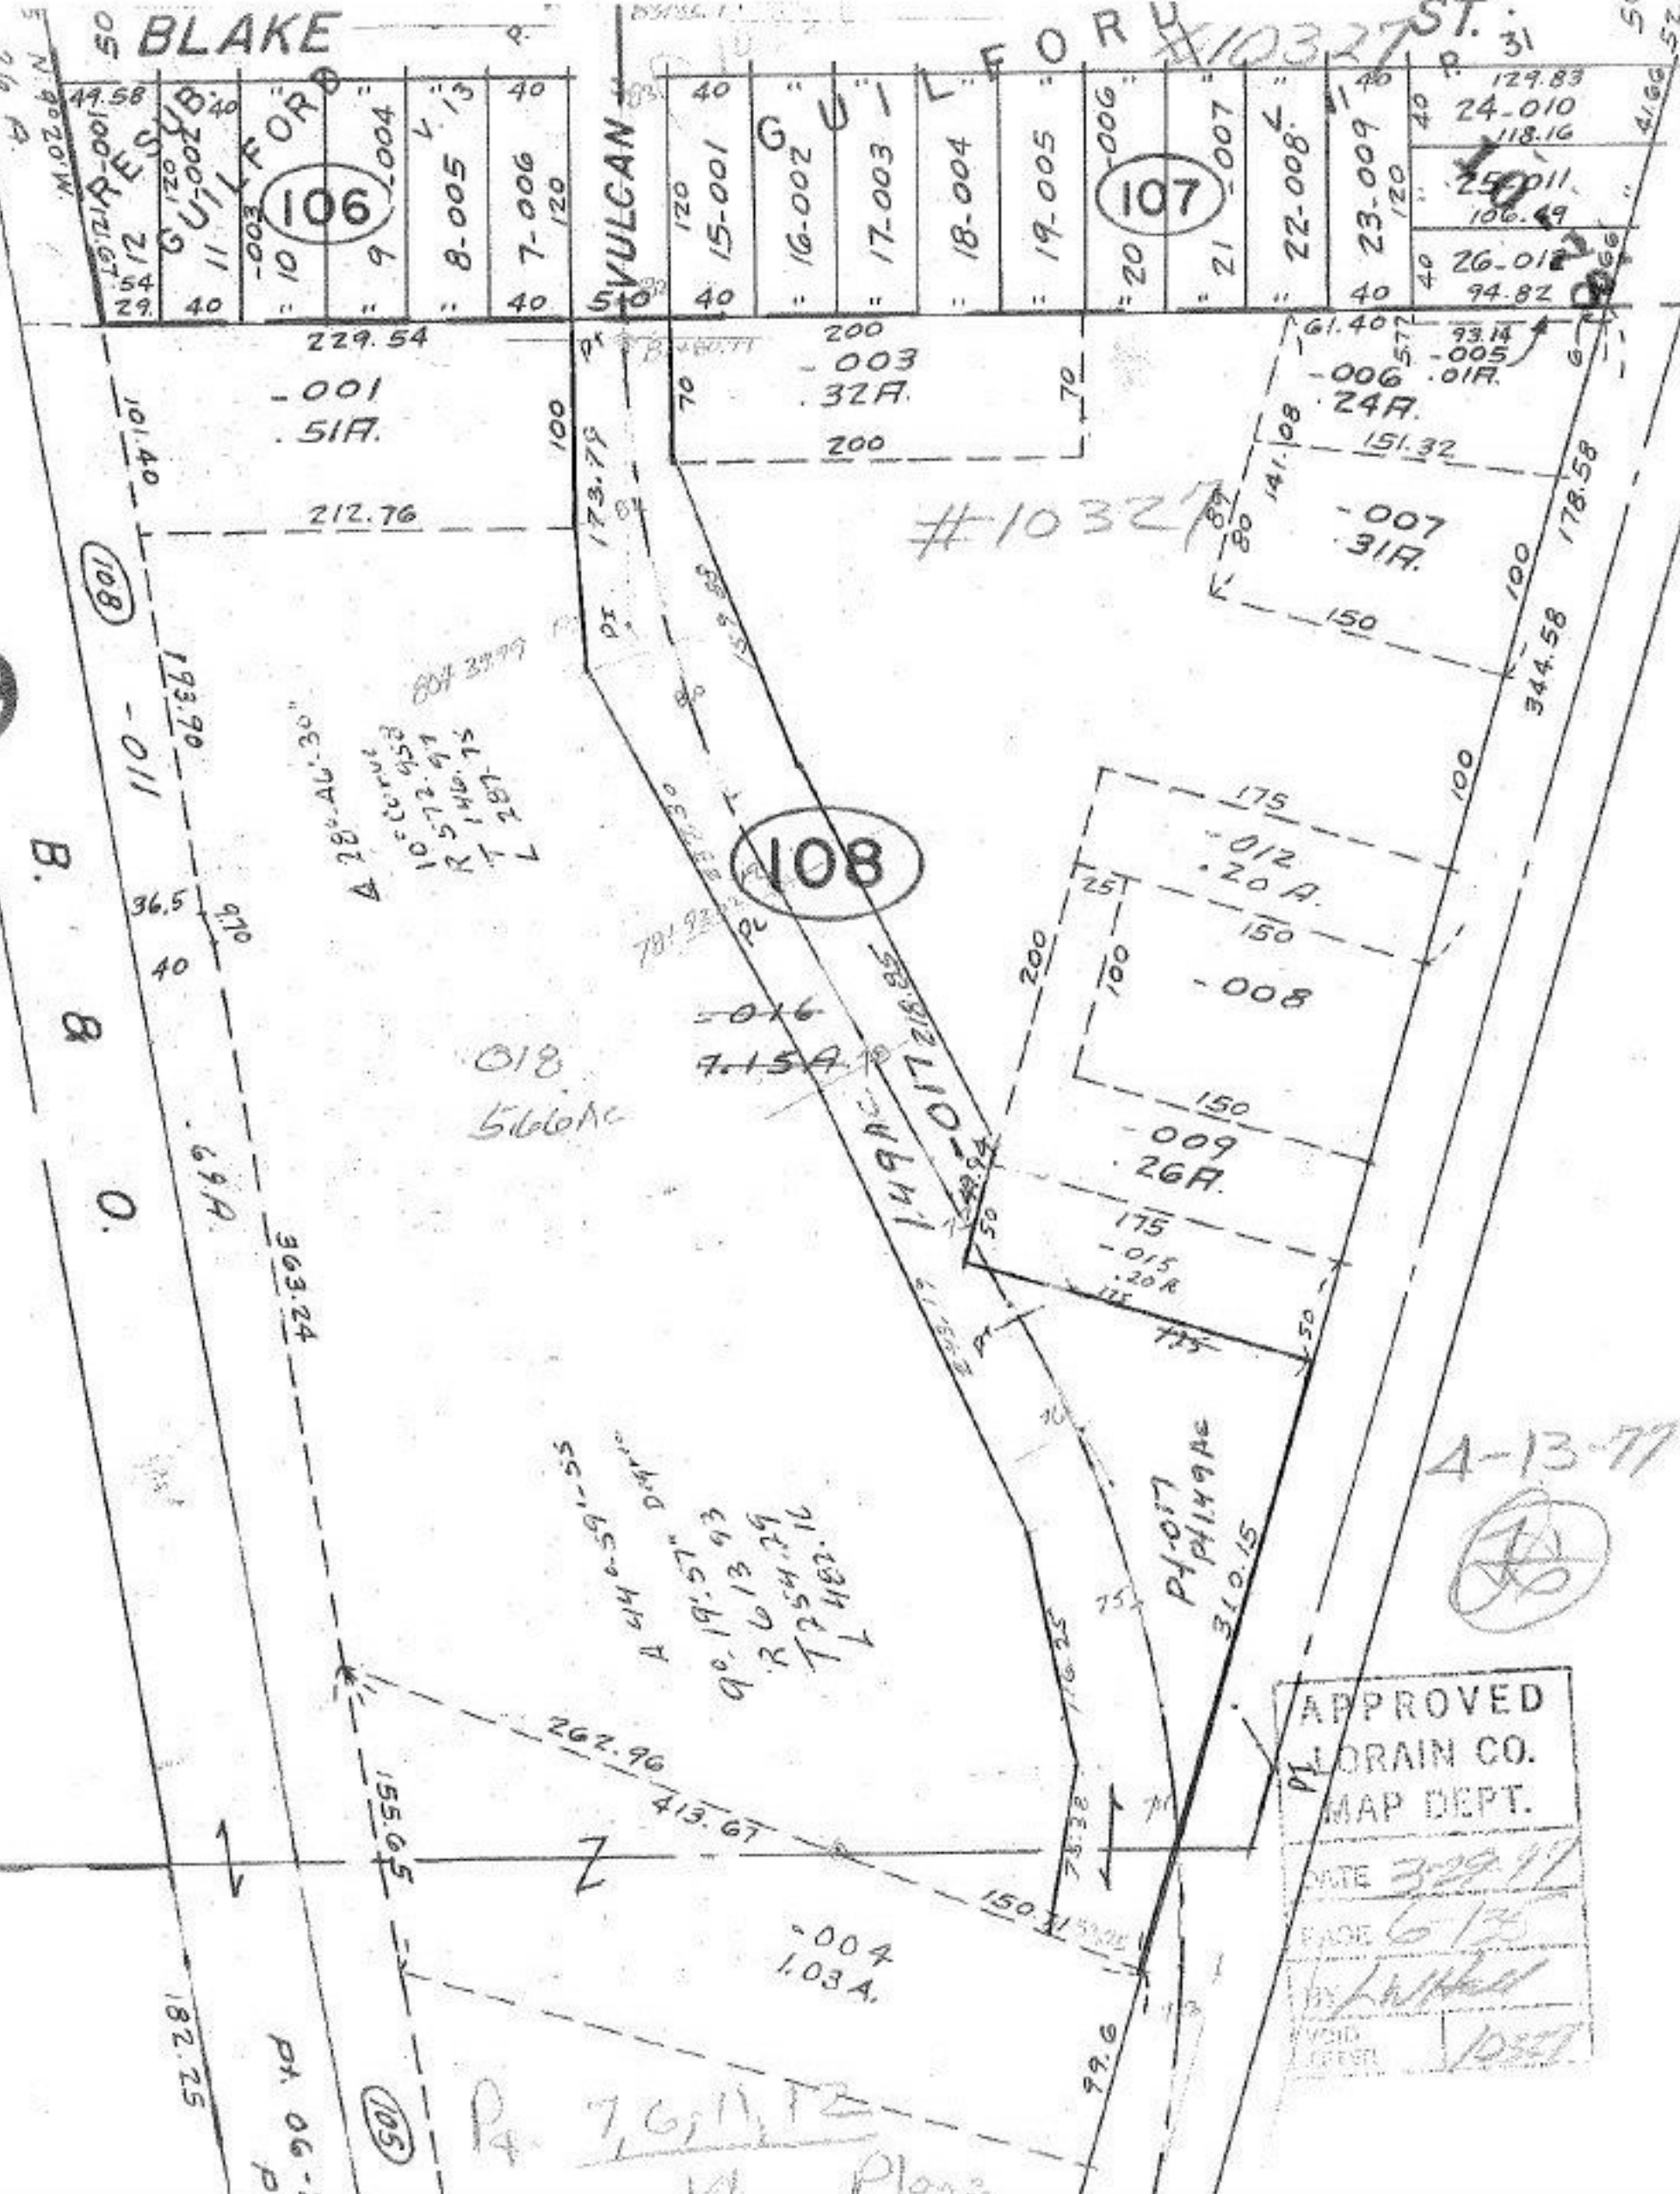

229.54
-001
51A.

212.76

108

018
566 AC

016
7.15A

P4-017
P4-149 AC
310.15

4-13-77



APPROVED
LORAIN CO.
MAP DEPT.

DATE 3-29-77

PAGE 6/13

BY [Signature]

VOID
IF REPRODUCED

-004
1.03A.

P.A. 7,6,11,12

10 Plans