

Went into
-029
Went into
-028
KIO-010
-028

10.330

APPROVED
LORAIN CO.
MAP DEPT.

DATE 3/10/77

PAGE 10-00-004E

BY LW Hall

VOID AFTER


MAR 14 1977
MAR 14 1977

APR 11 1977

[Handwritten signature]

SEE 10-00-004-A

10
Specify how the
located for
of 161 as
to be assigned

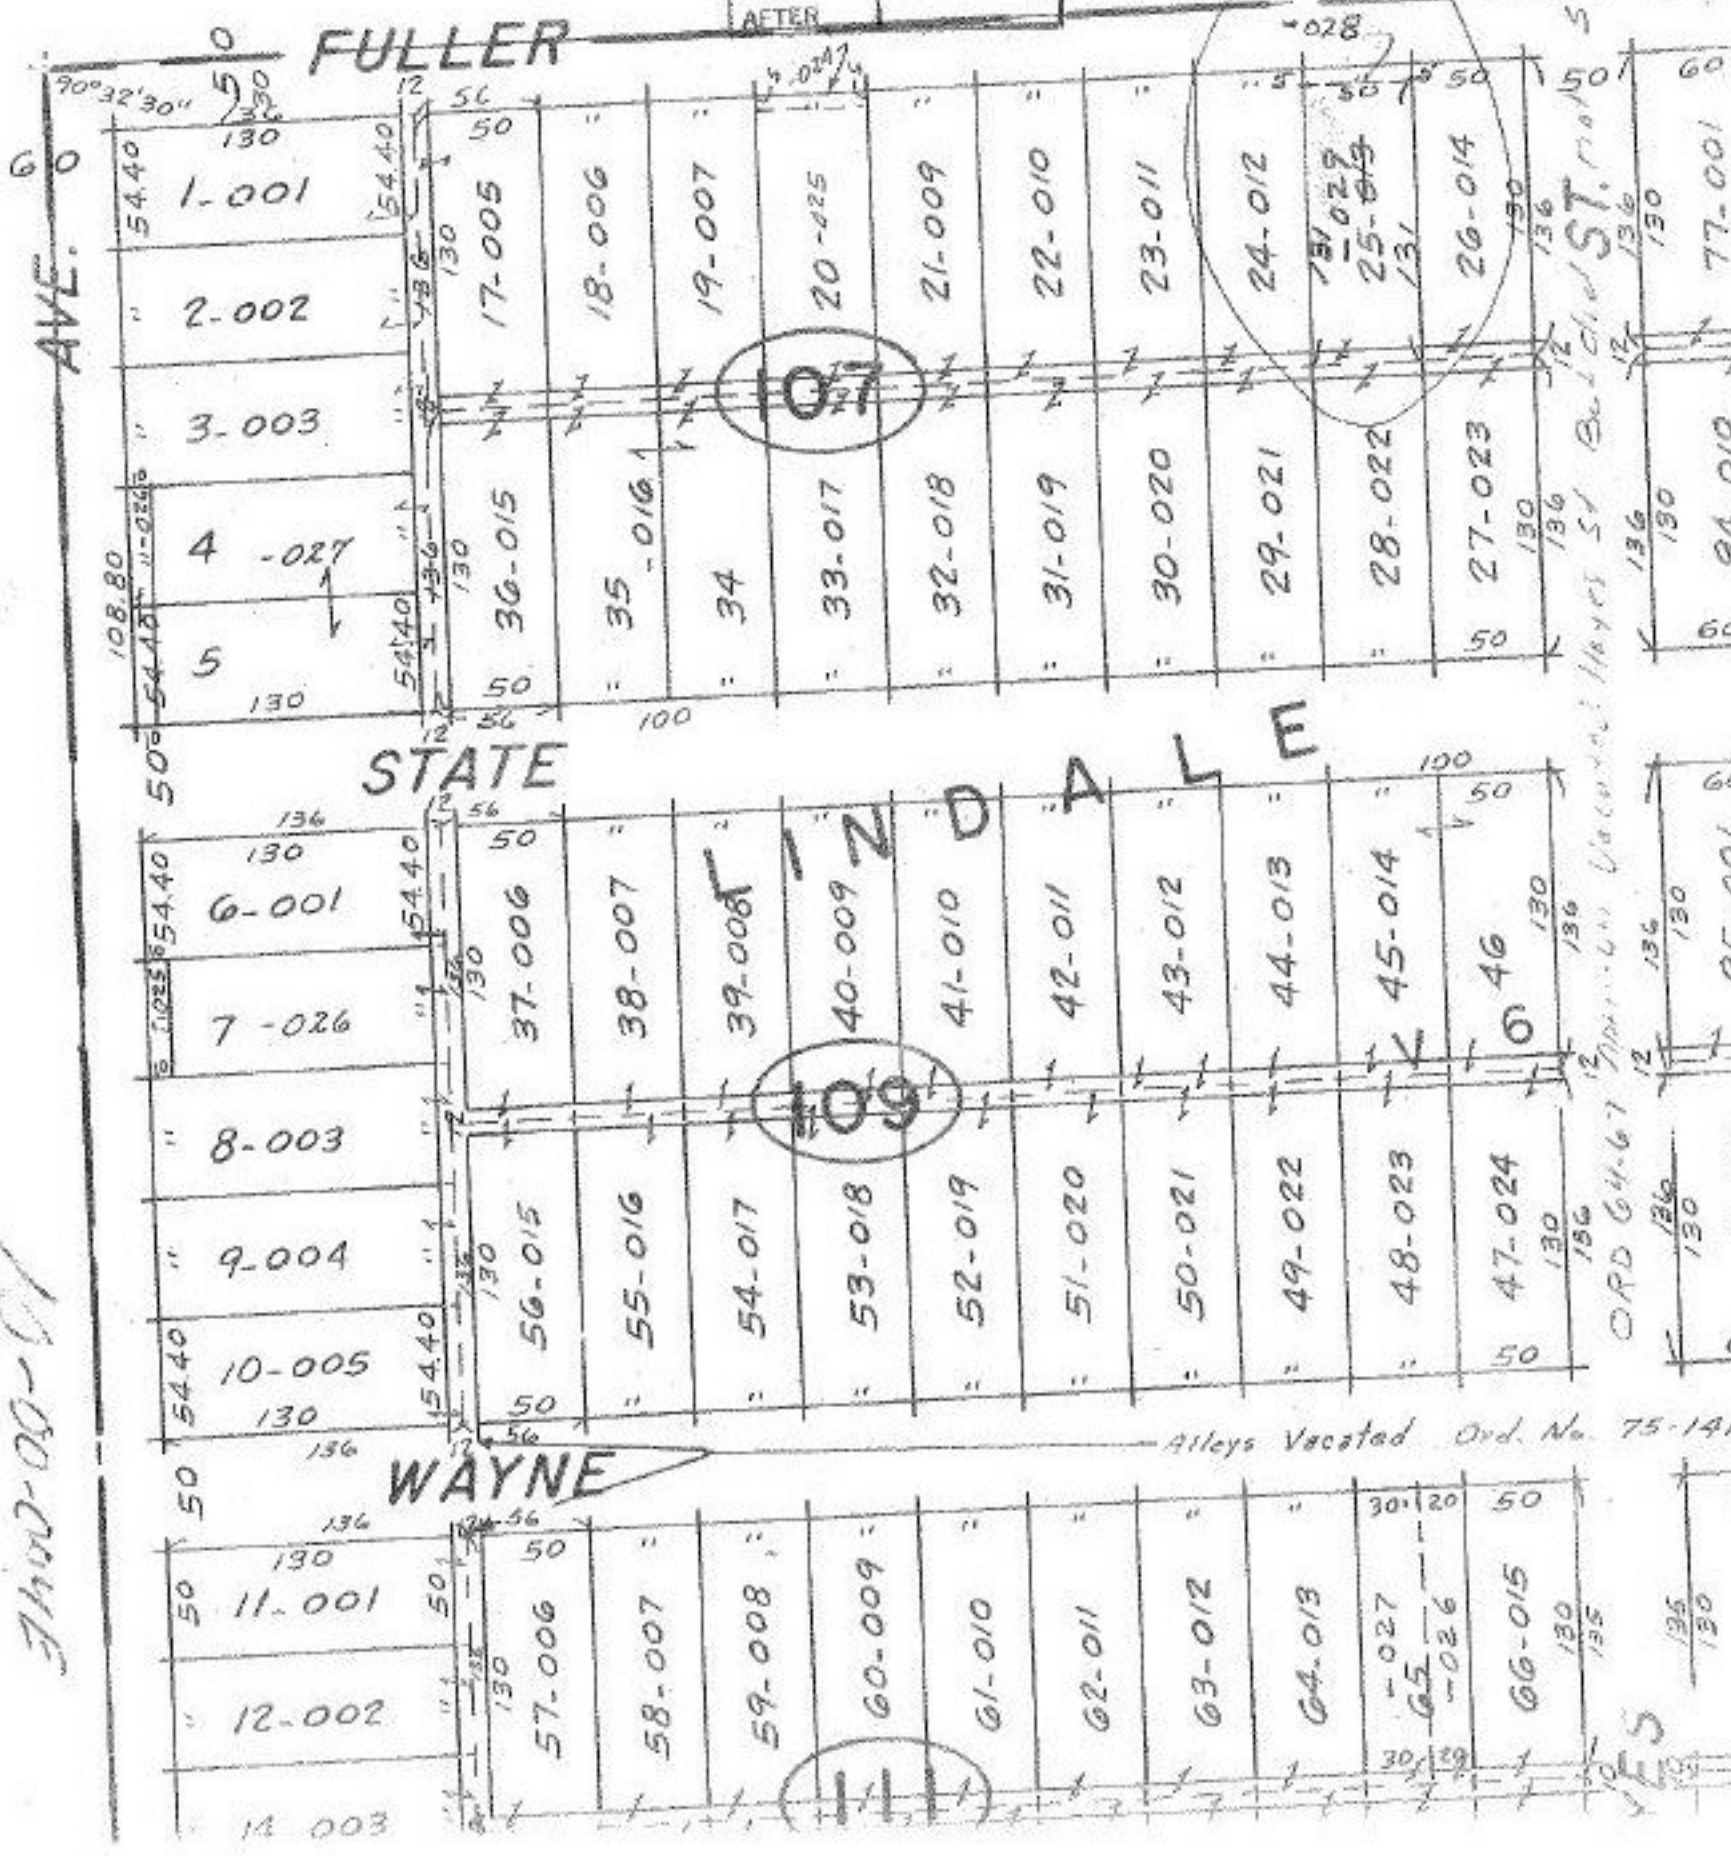

10-00-001

ORD 64-67
Vacated
Alleys Vacated Ord. No. 75-141