


#10340
10-28-8

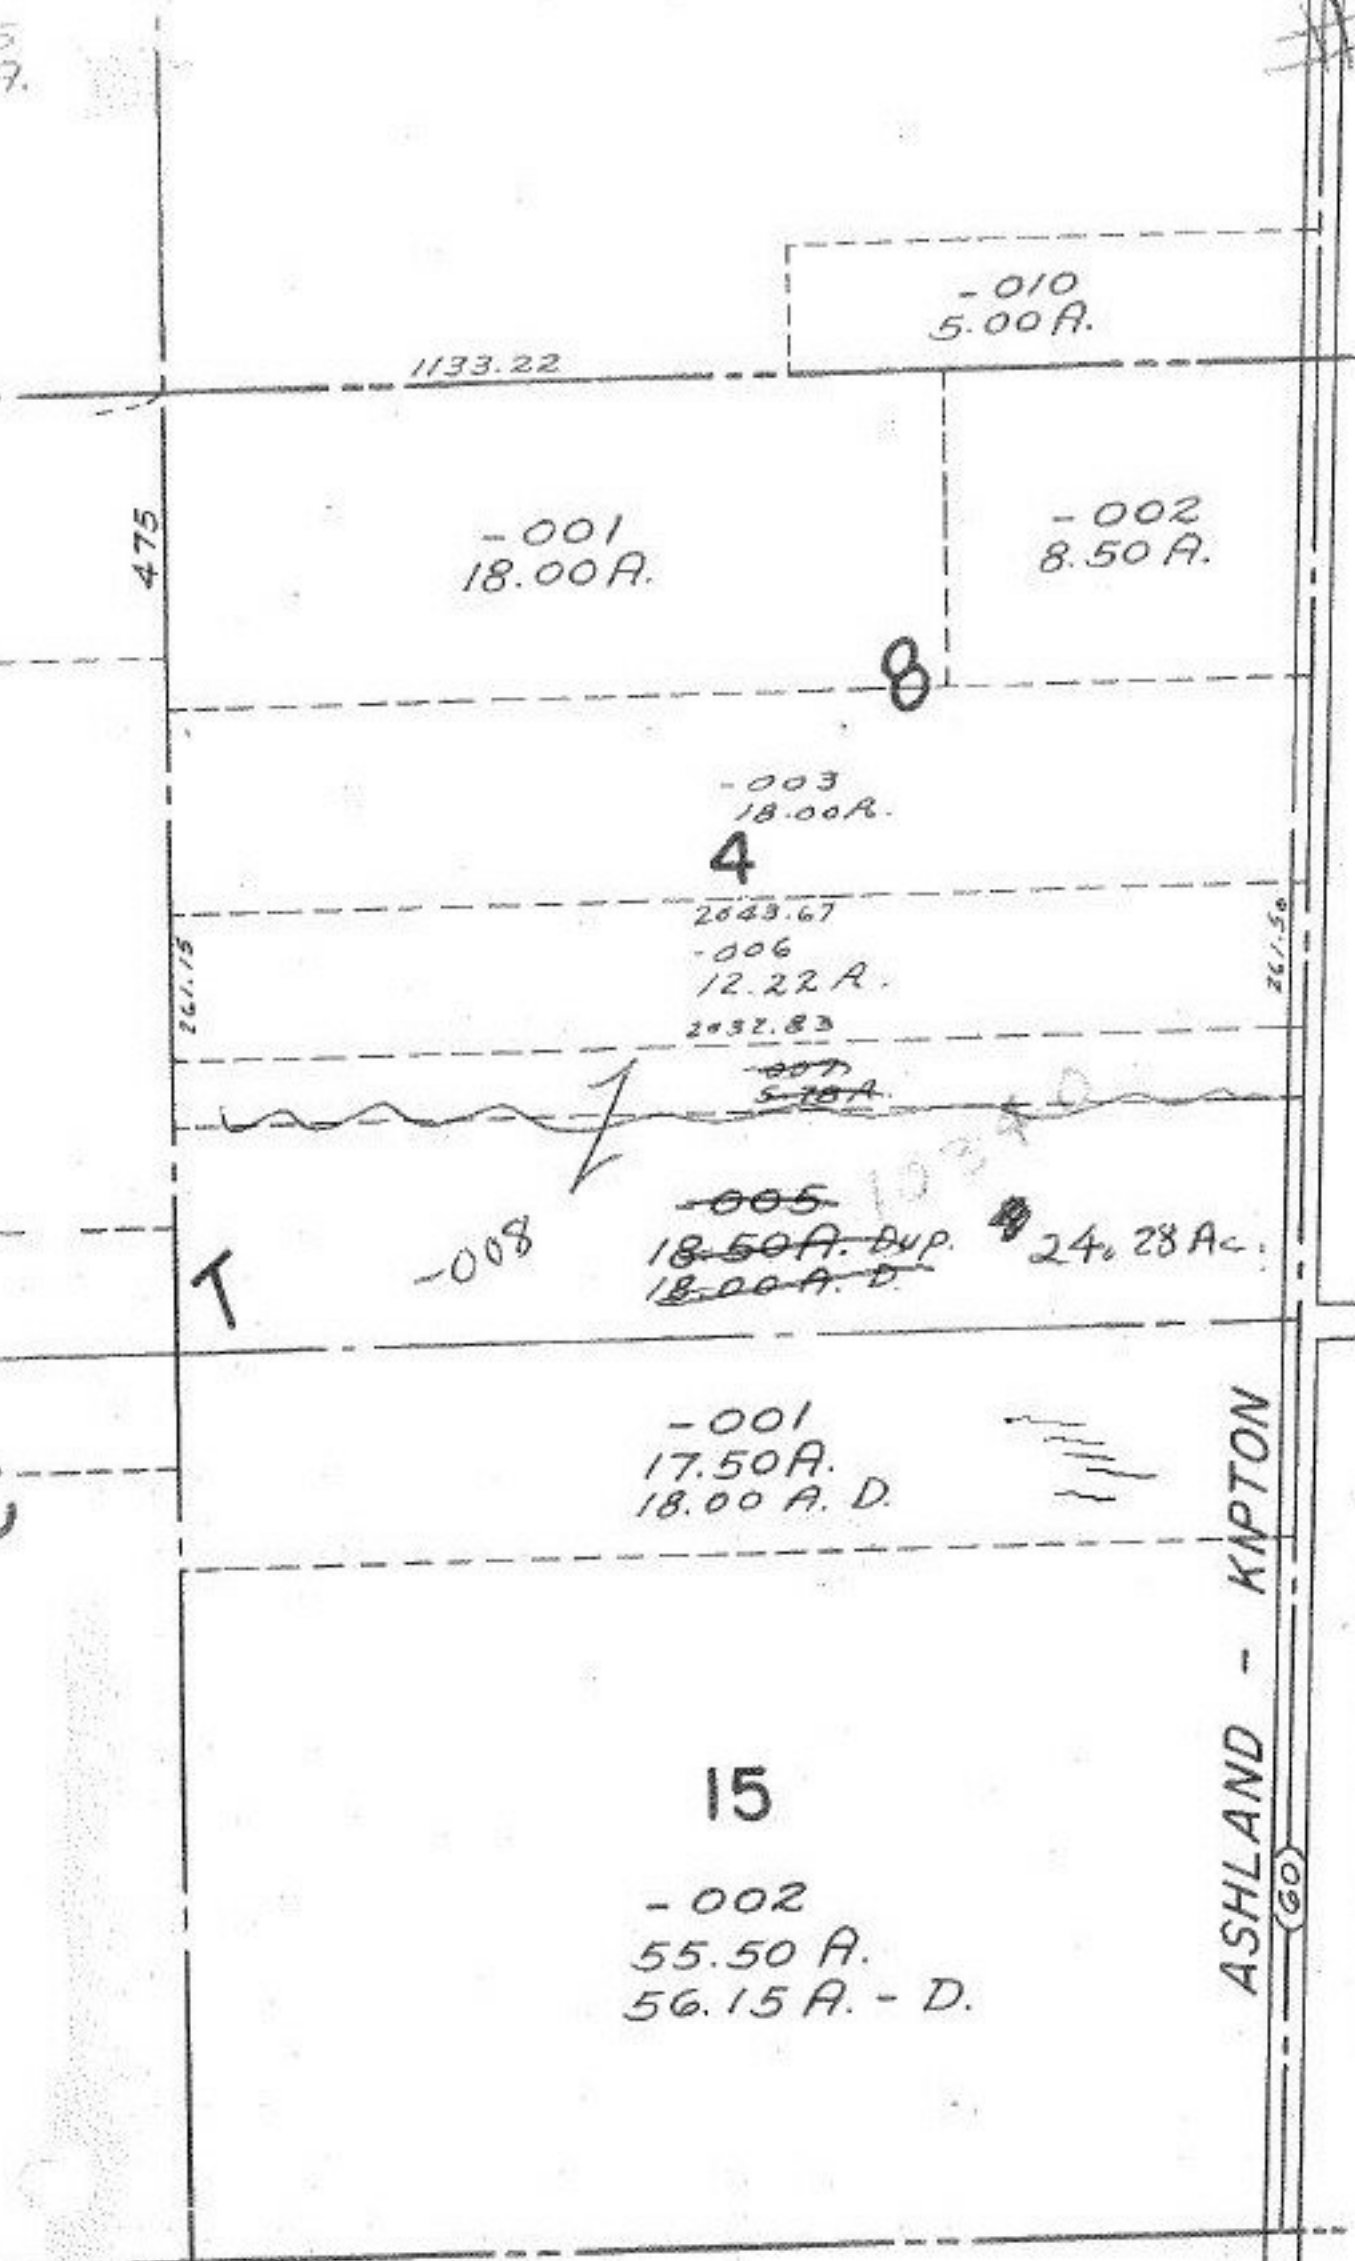

- 010
5.00 A.

1133.22

475

- 001
18.00 A.

- 002
8.50 A.

8

- 003
18.00 A.

4

2043.67

- 006
12.22 A.

2032.83

- 007
5.20 A.

261.15

261.50

T

- 008

- 005
18.50 A. D.V.P. 24.28 A.
~~18.00 A. D.~~

APR 11 1977

MAR 14 1977

- 001
17.50 A.
18.00 A. D.

ASHLAND - KIPTON

#10340

APPROVED LORAIN CO. MAP DEPT.	
DATE 3-9-77	
PAGE 13-F	
BY <i>Roller</i>	
VOID AFTER	

15

- 002
55.50 A.
56.15 A. - D.

511

8 LOTS 3, 4, 15, 16