


26

10381

026-F

CT.

RD.

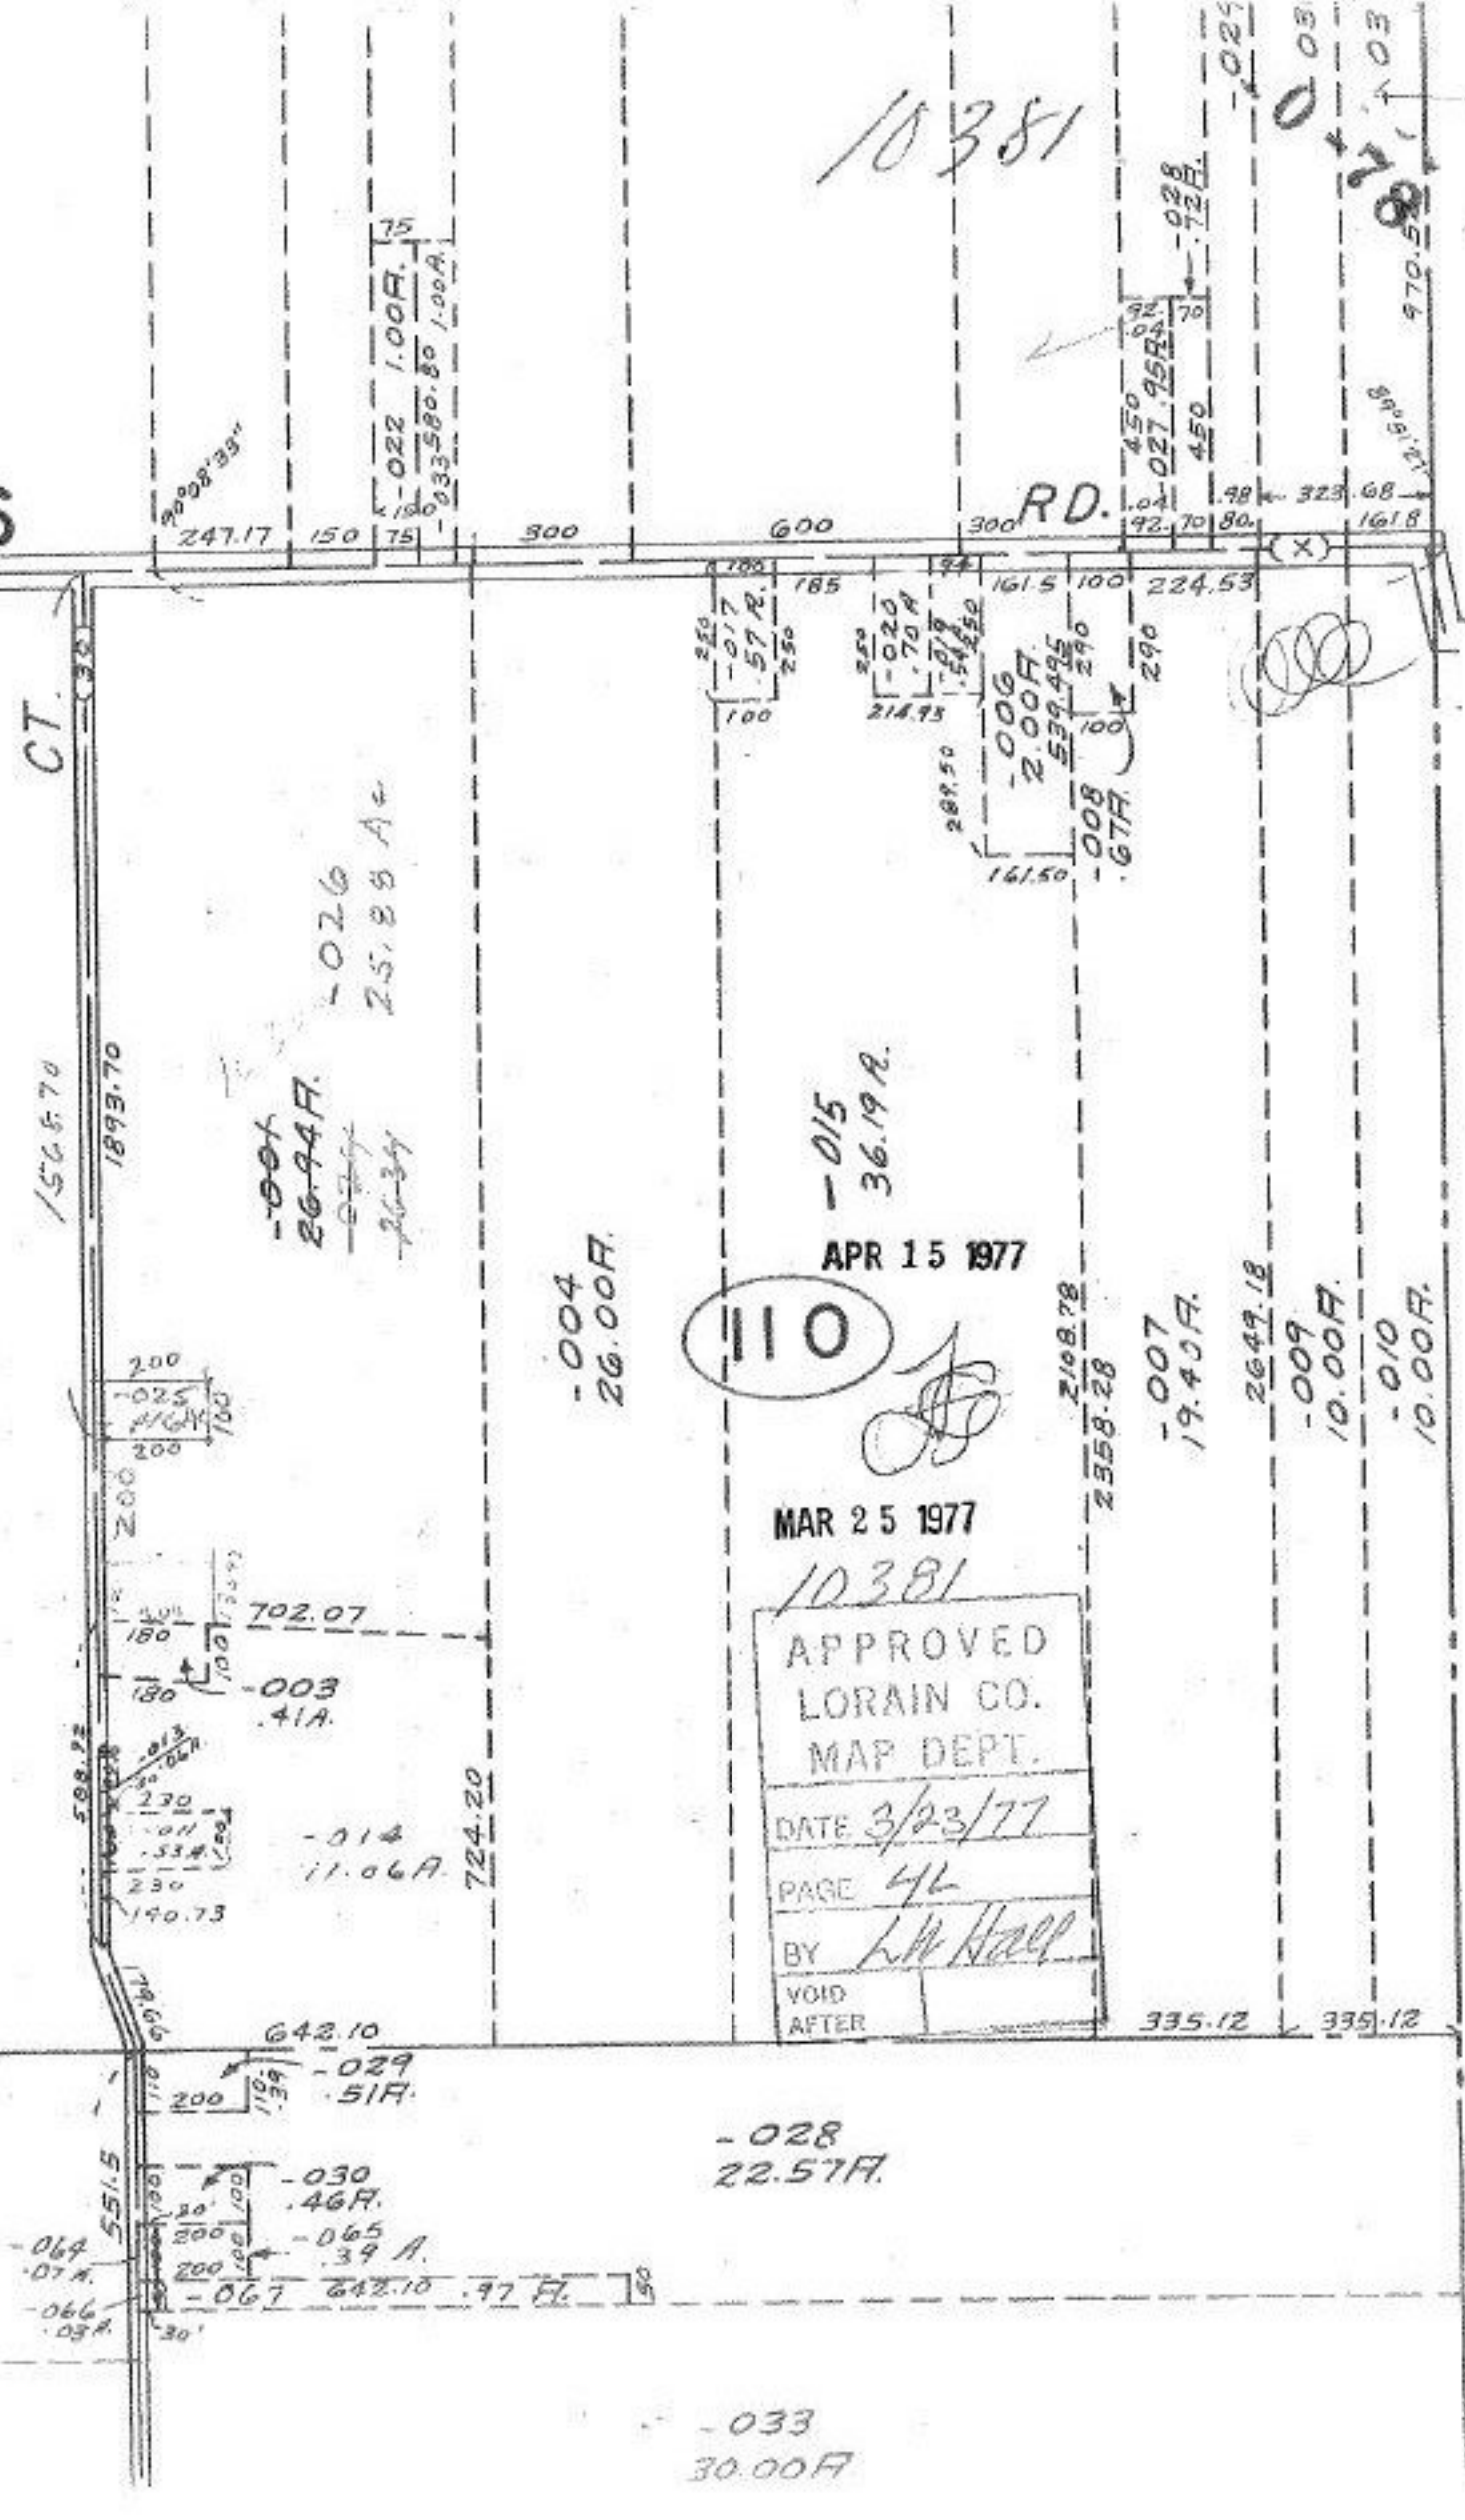

110

APR 15 1977

MAR 25 1977

10381

APPROVED  
LORAIN CO.  
MAP DEPT.

DATE 3/23/77

PAGE 46

BY L.H. Hall

VOID  
AFTER

0.03  
970.52

37

33