


-018  
23.84 A.  
10393

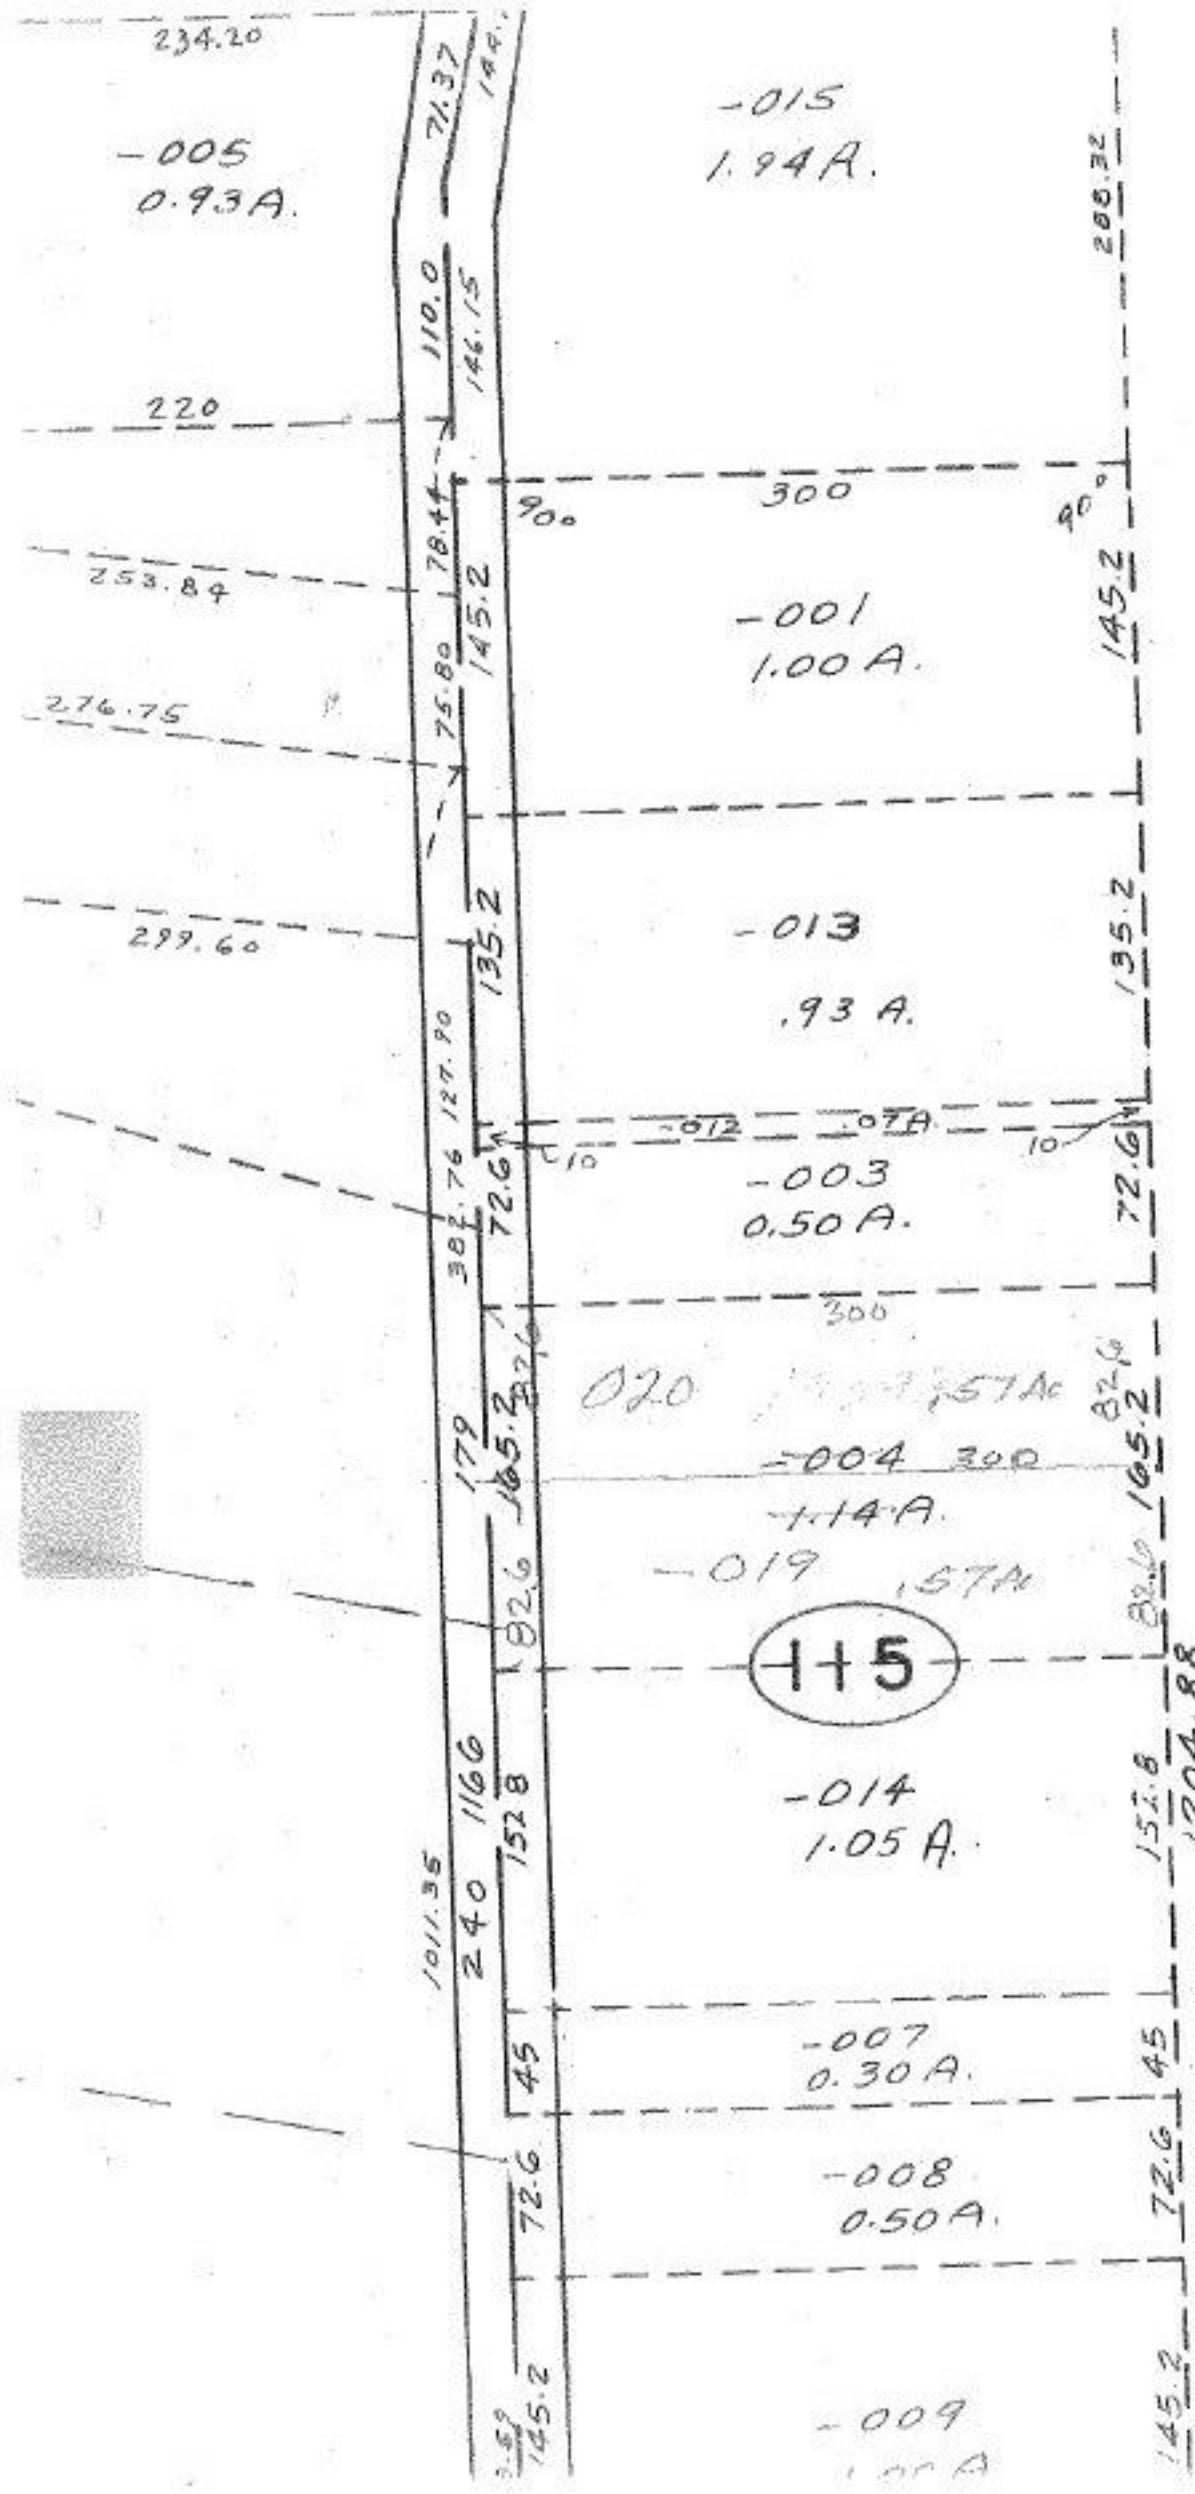

APR 11 1977 APR 1 1977

10393

APPROVED LORAIN CO. MAP DEPT.	
DATE 3/30/77	
PAGE 10-00-015F	
BY <i>L. P. Hall</i>	
VOID AFTER	