


10405

10-78

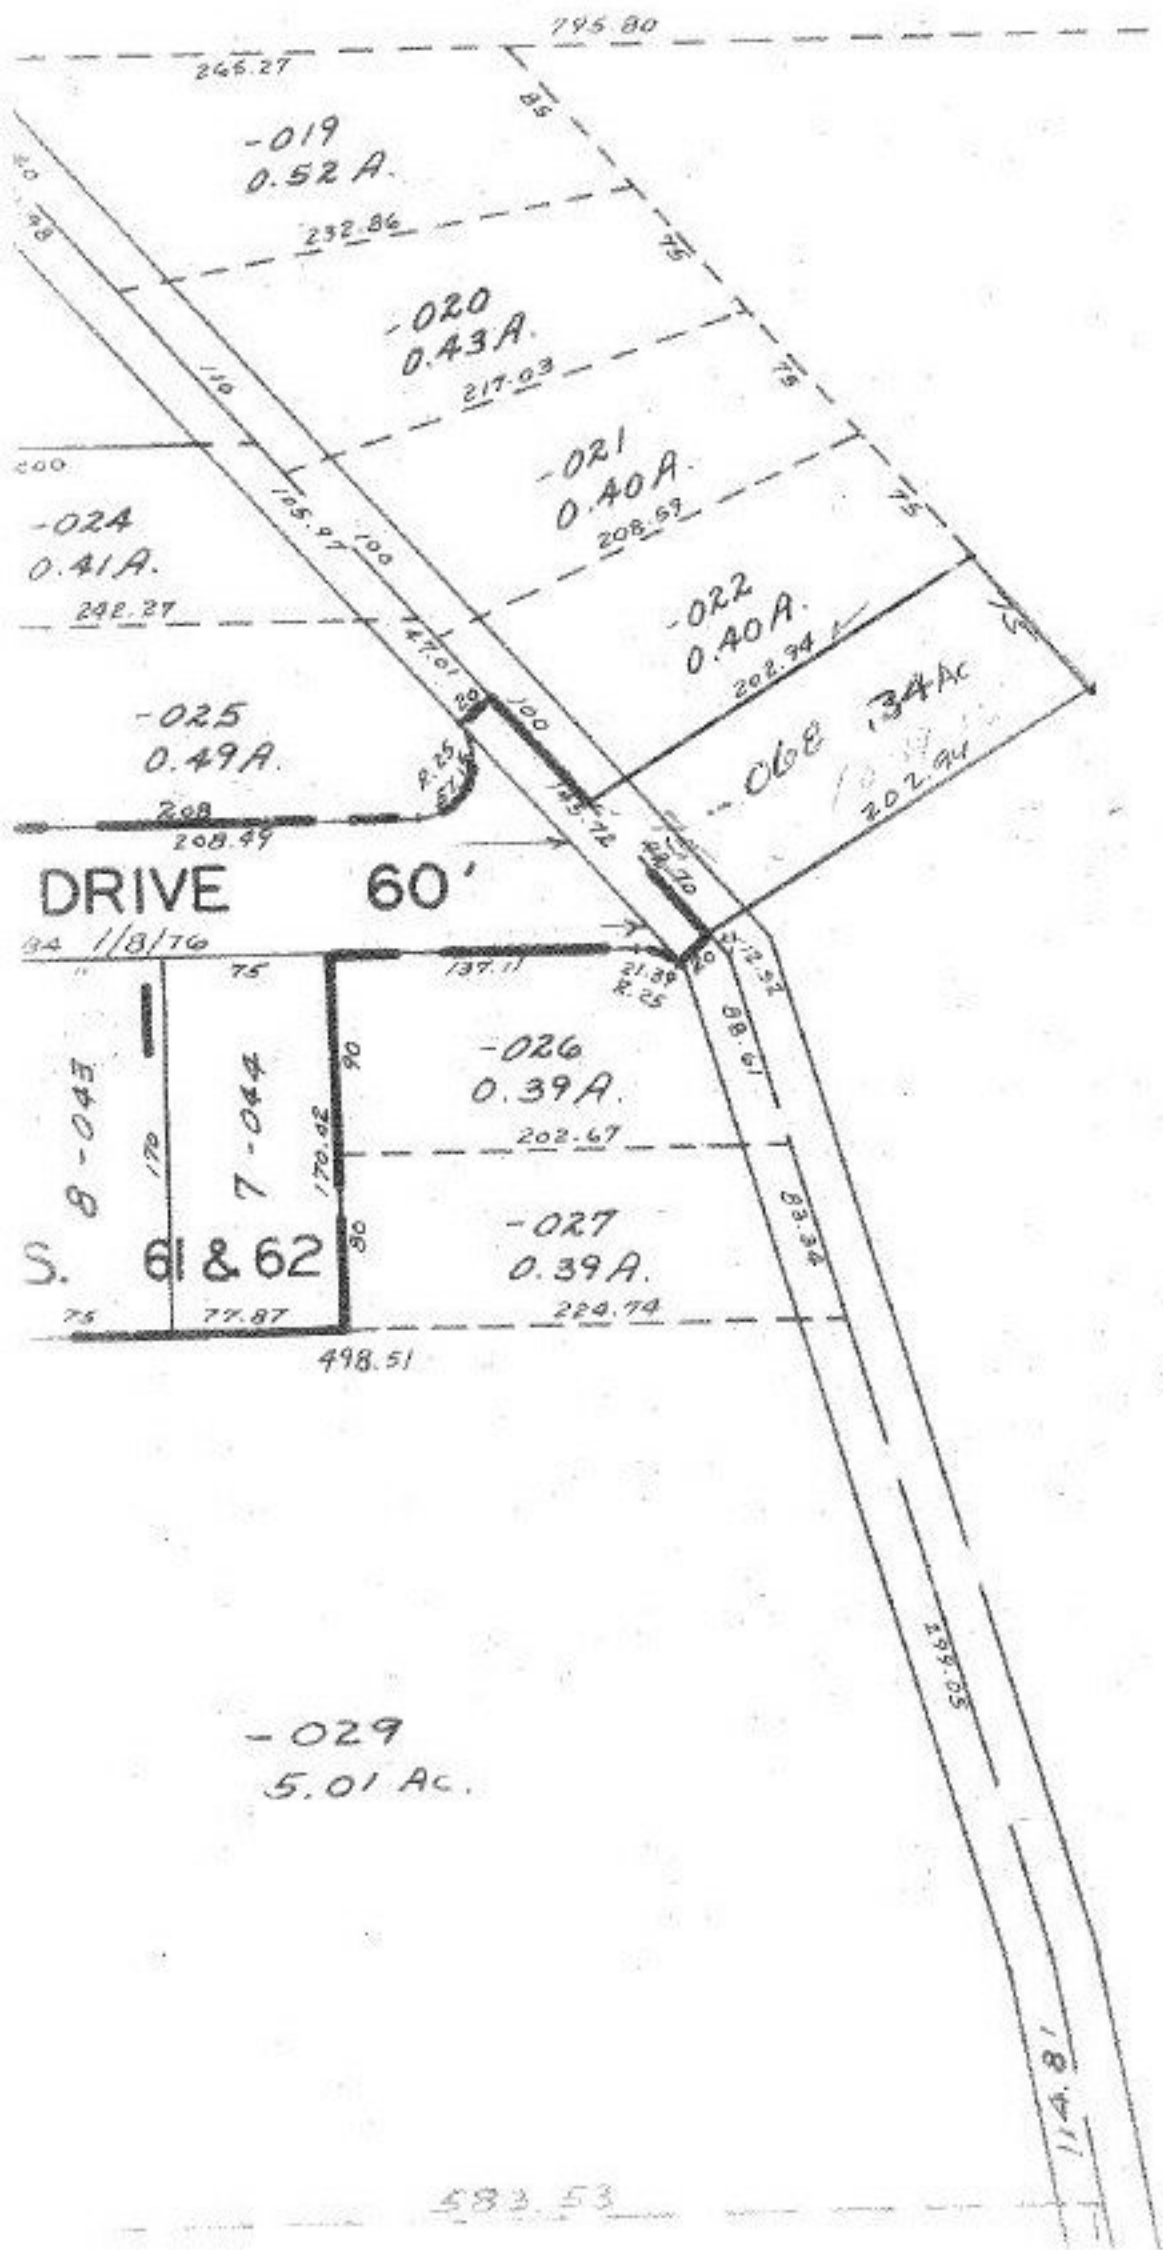

See split  
# 9745

APR 5 1977

APR 29 1977

10405

APPROVED
LORAIN CO.
MAP DEPT.
DATE 4/1/77
PAGE 01-00-017A + E
BY L.W. Hall
VOID AFTER

-069  
48.02 Ac.

-067  
48.30

583.53